


0376 - 084

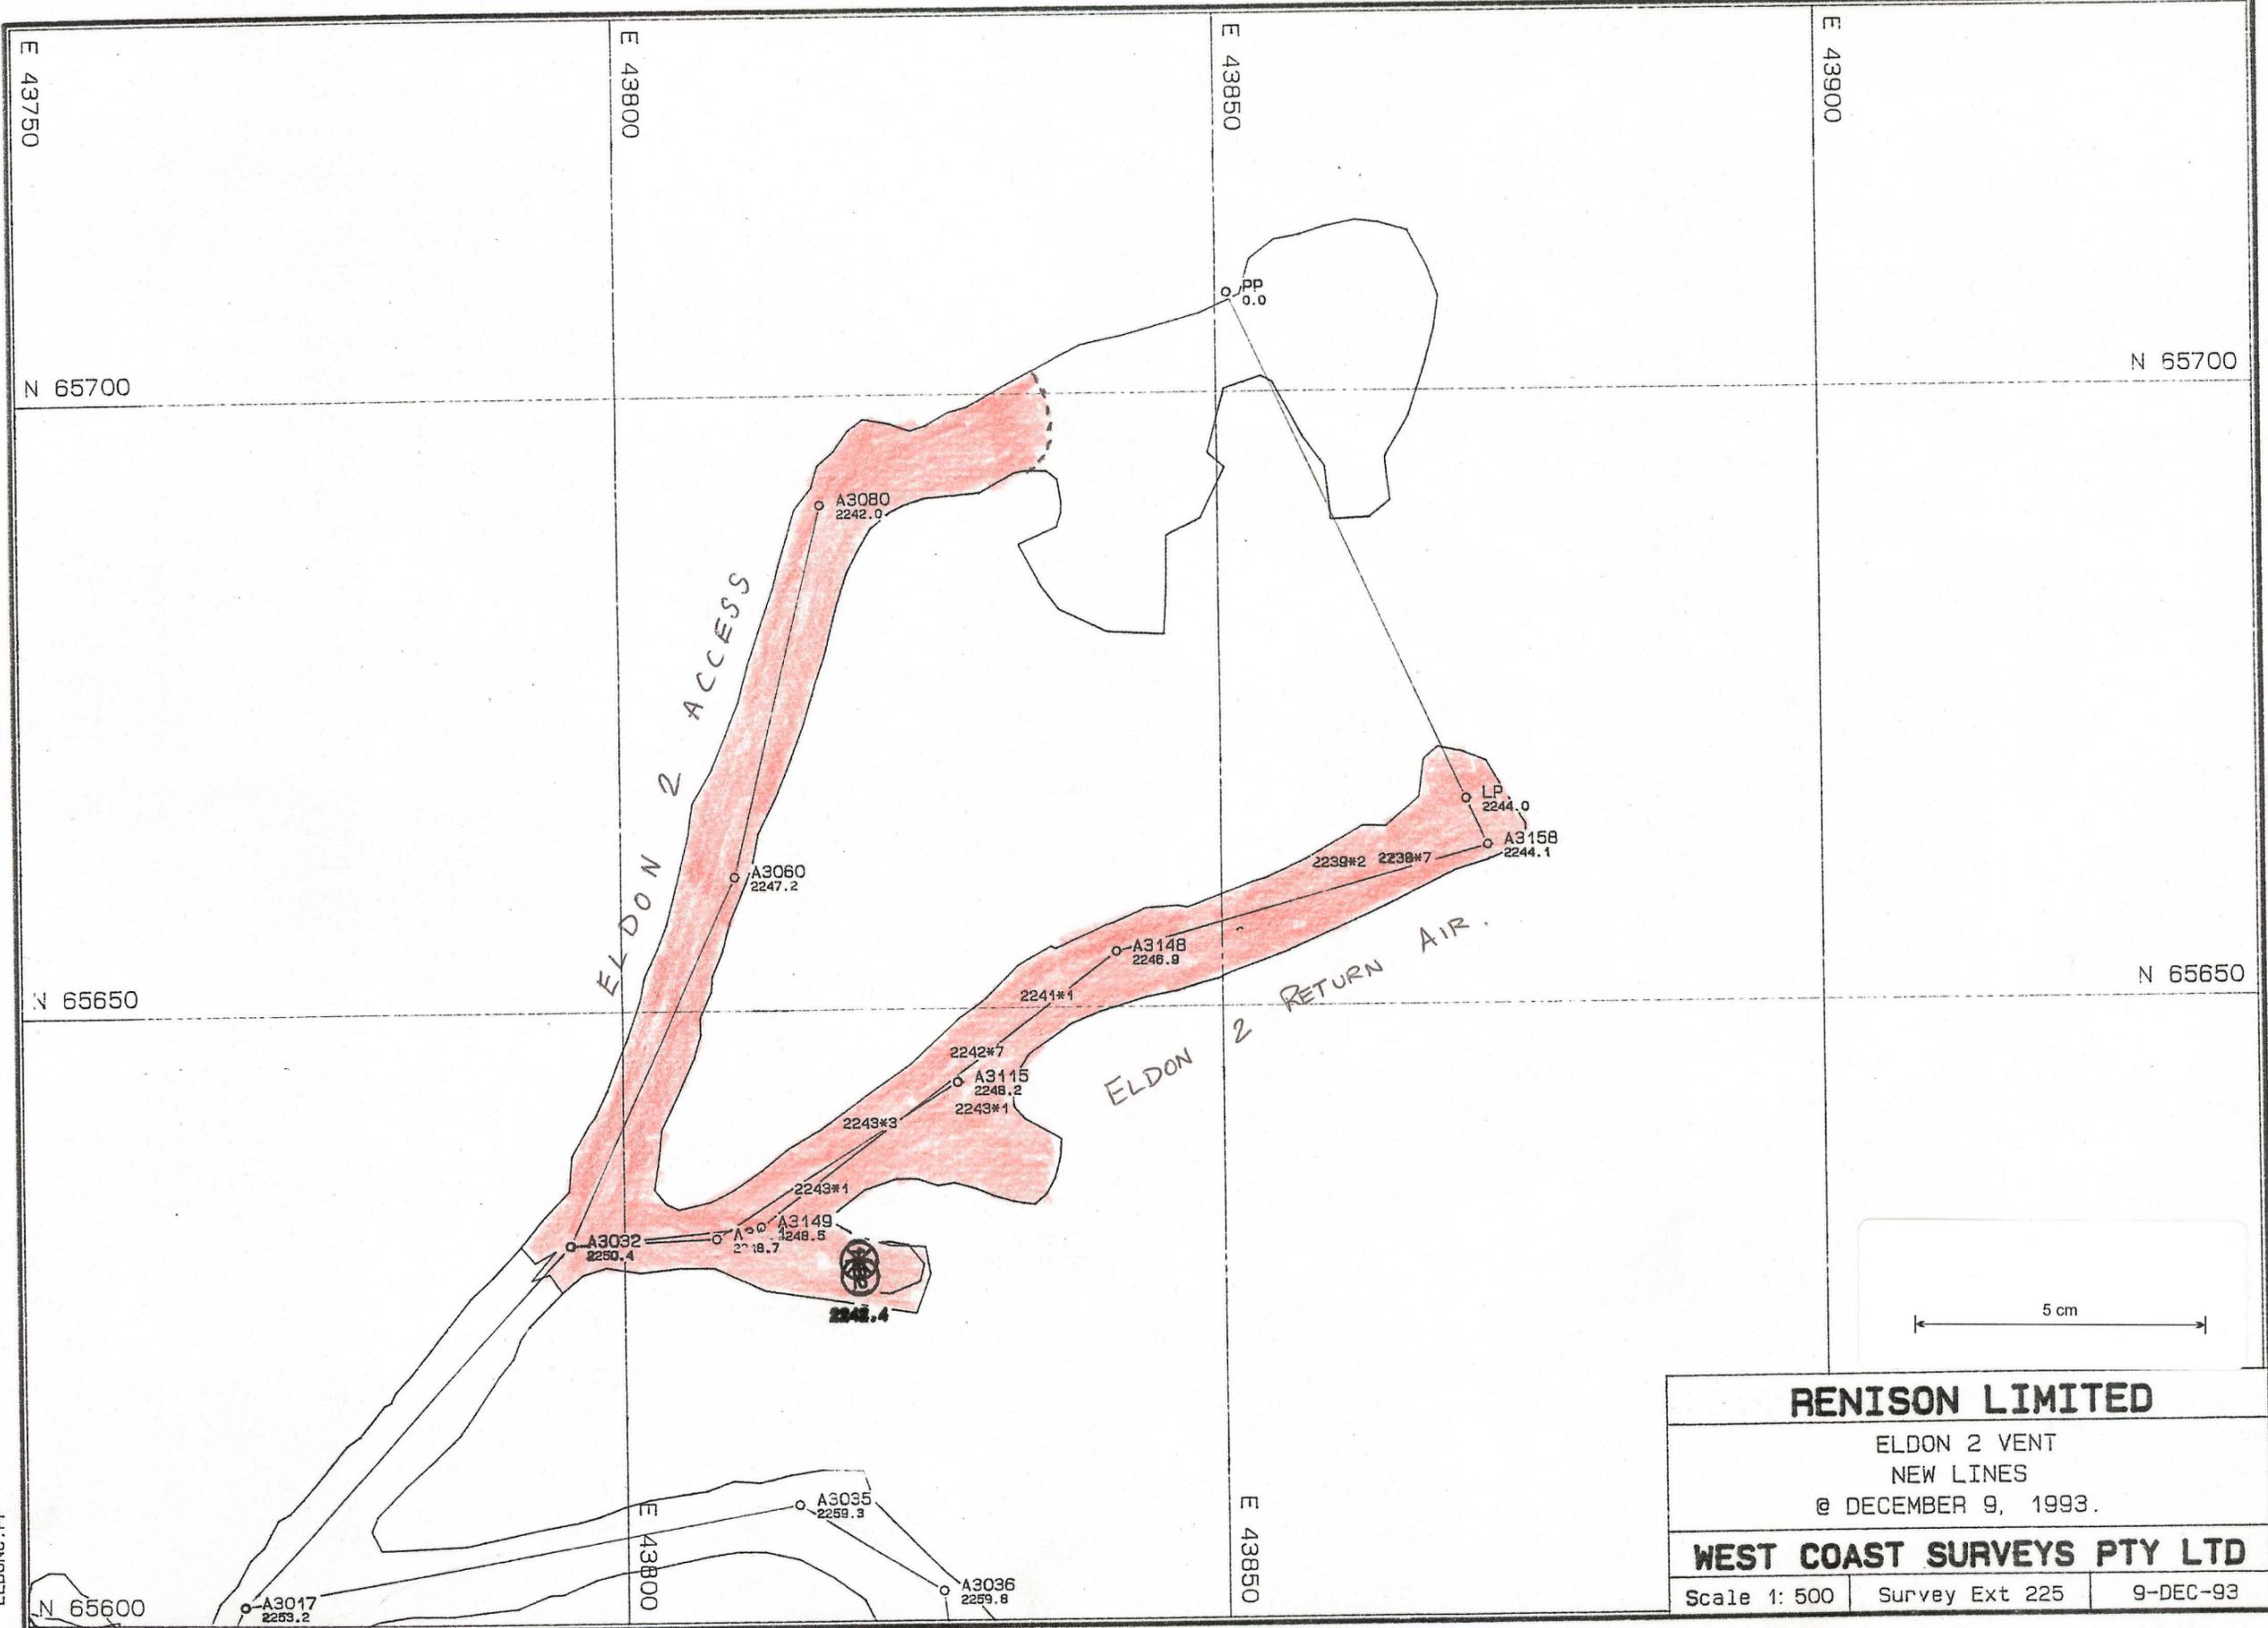

RENISON LIMITED
 ELDON 2 VENT
 NEW LINES
 @ DECEMBER 9, 1993.

WEST COAST SURVEYS PTY LTD
 Scale 1: 500 | Survey Ext 225 | 9-DEC-93

ELDONC.PF