


0376-086

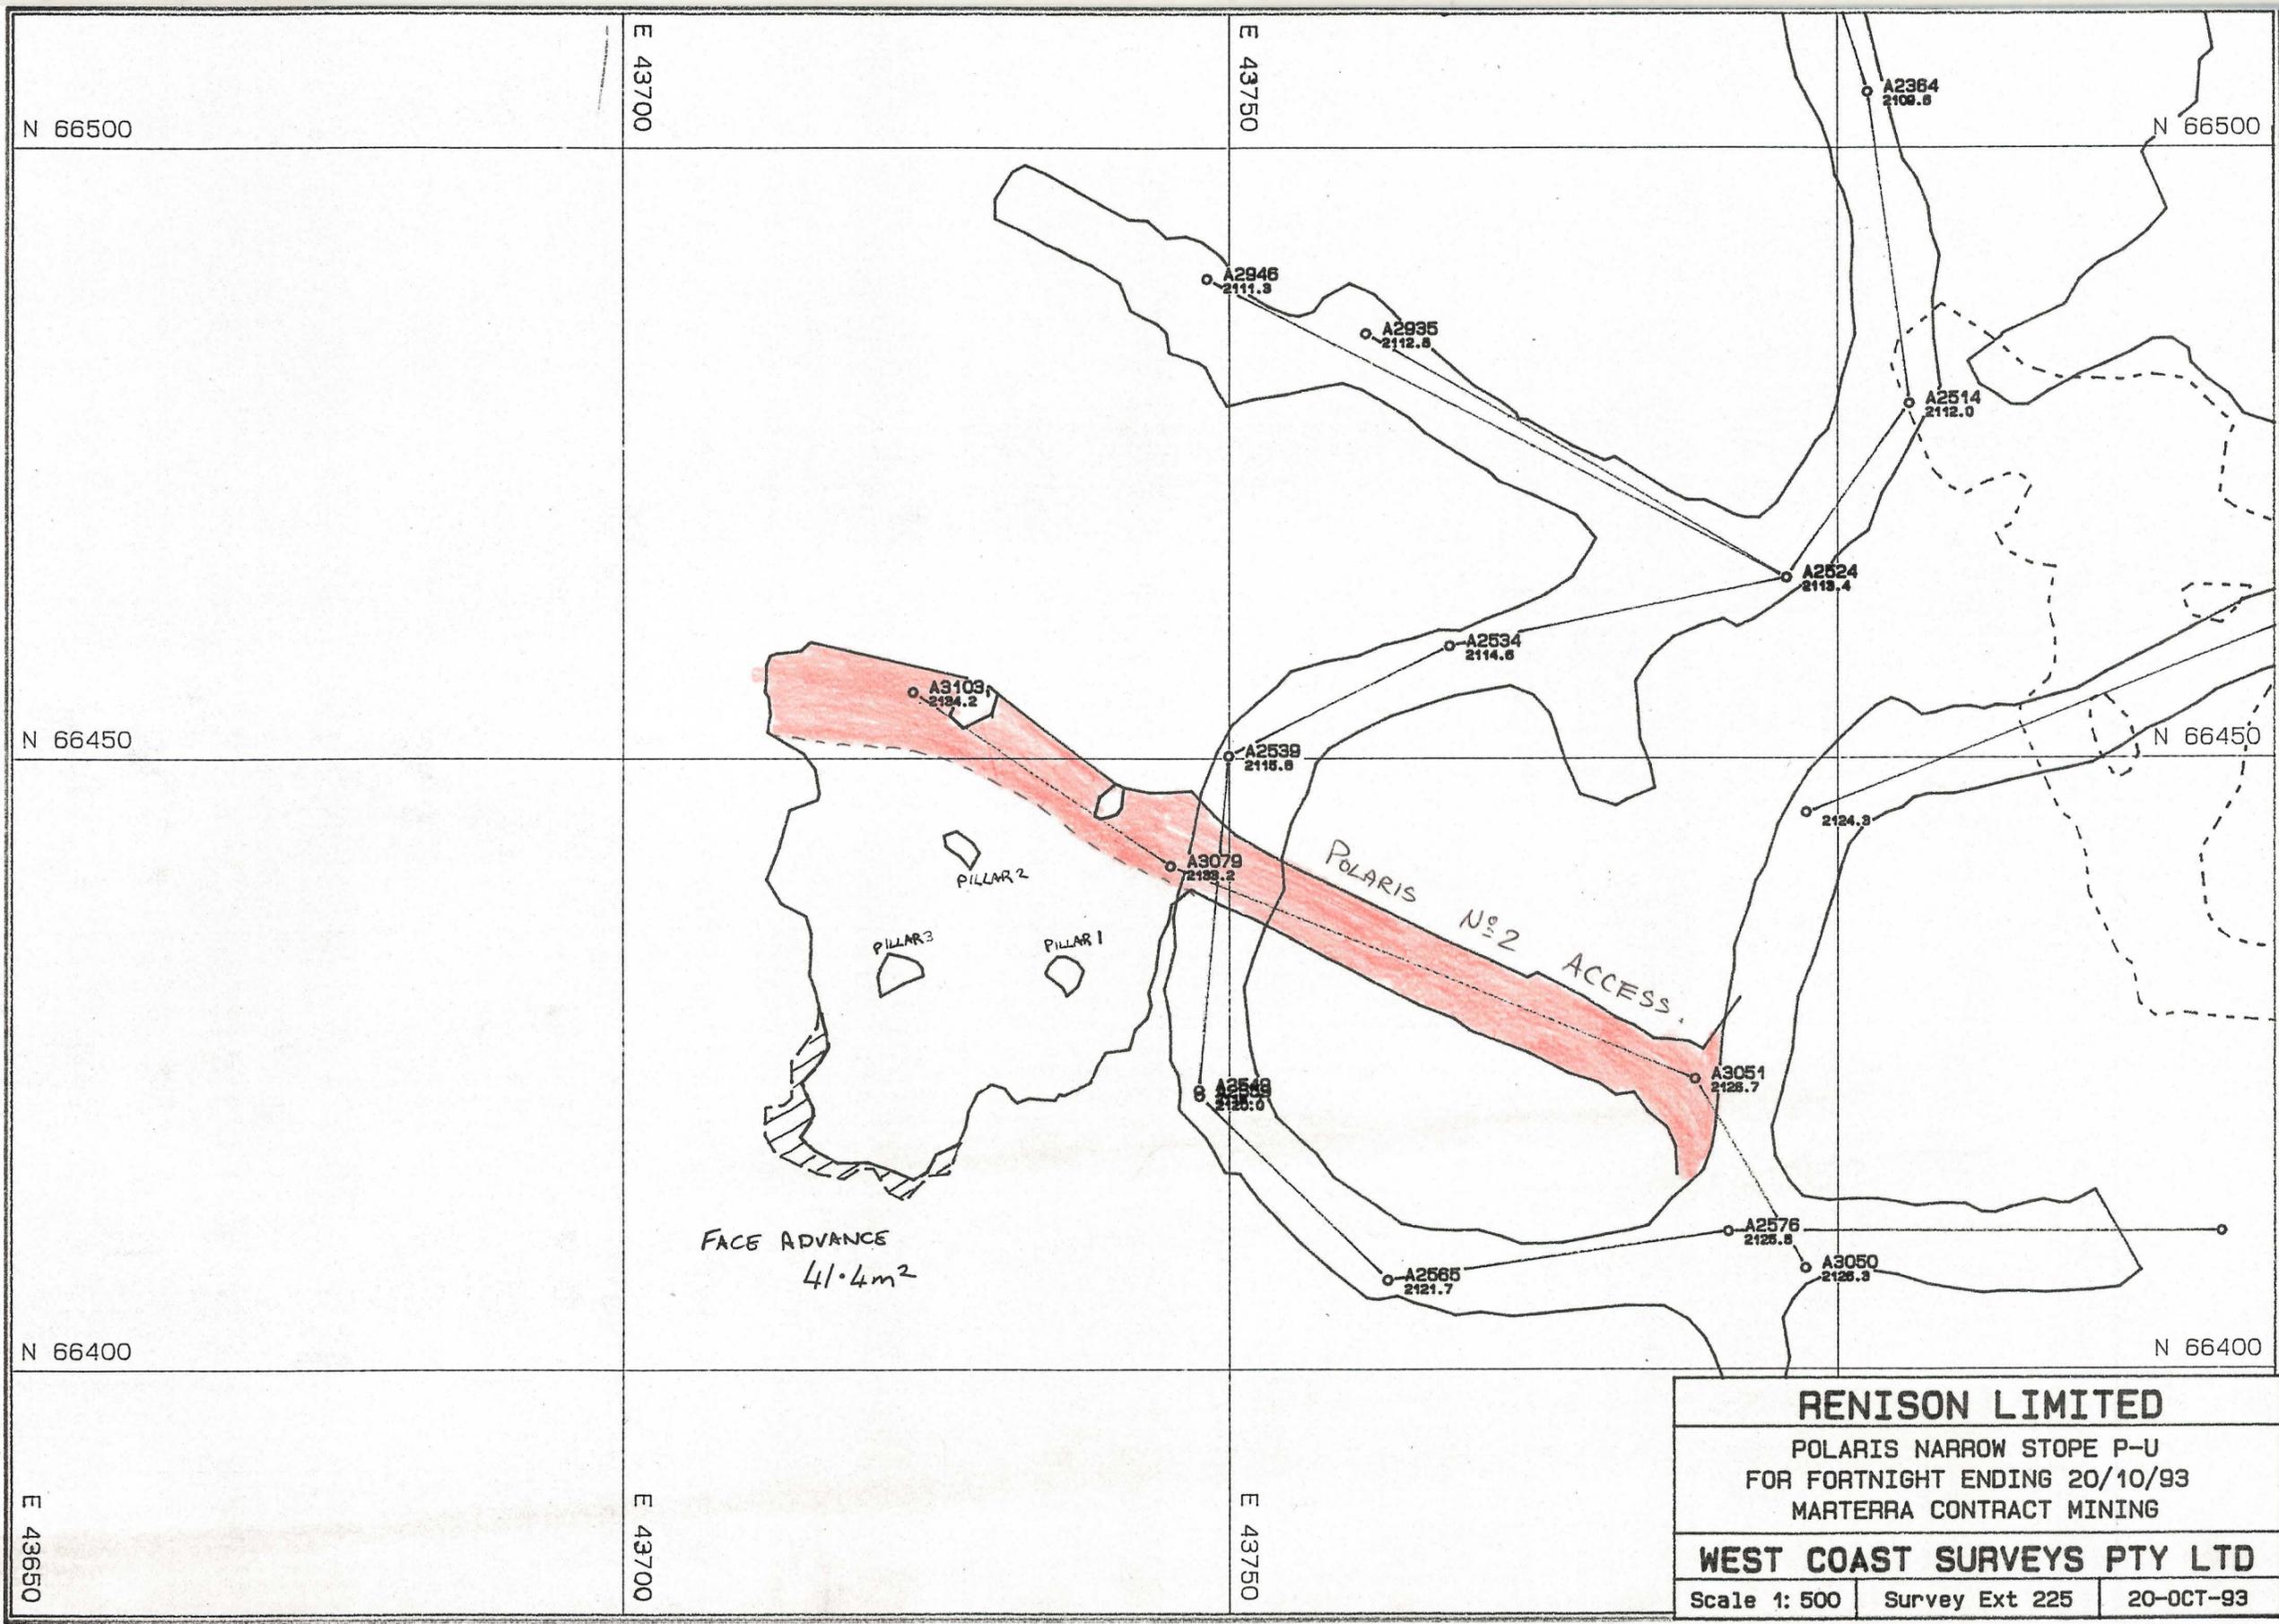

RENISON LIMITED		
POLARIS NARROW STOPE P-U FOR FORTNIGHT ENDING 20/10/93 MARTERRA CONTRACT MINING		
WEST COAST SURVEYS PTY LTD		
Scale 1: 500	Survey Ext 225	20-OCT-93

POLARB.PF