


0376-088

1/2

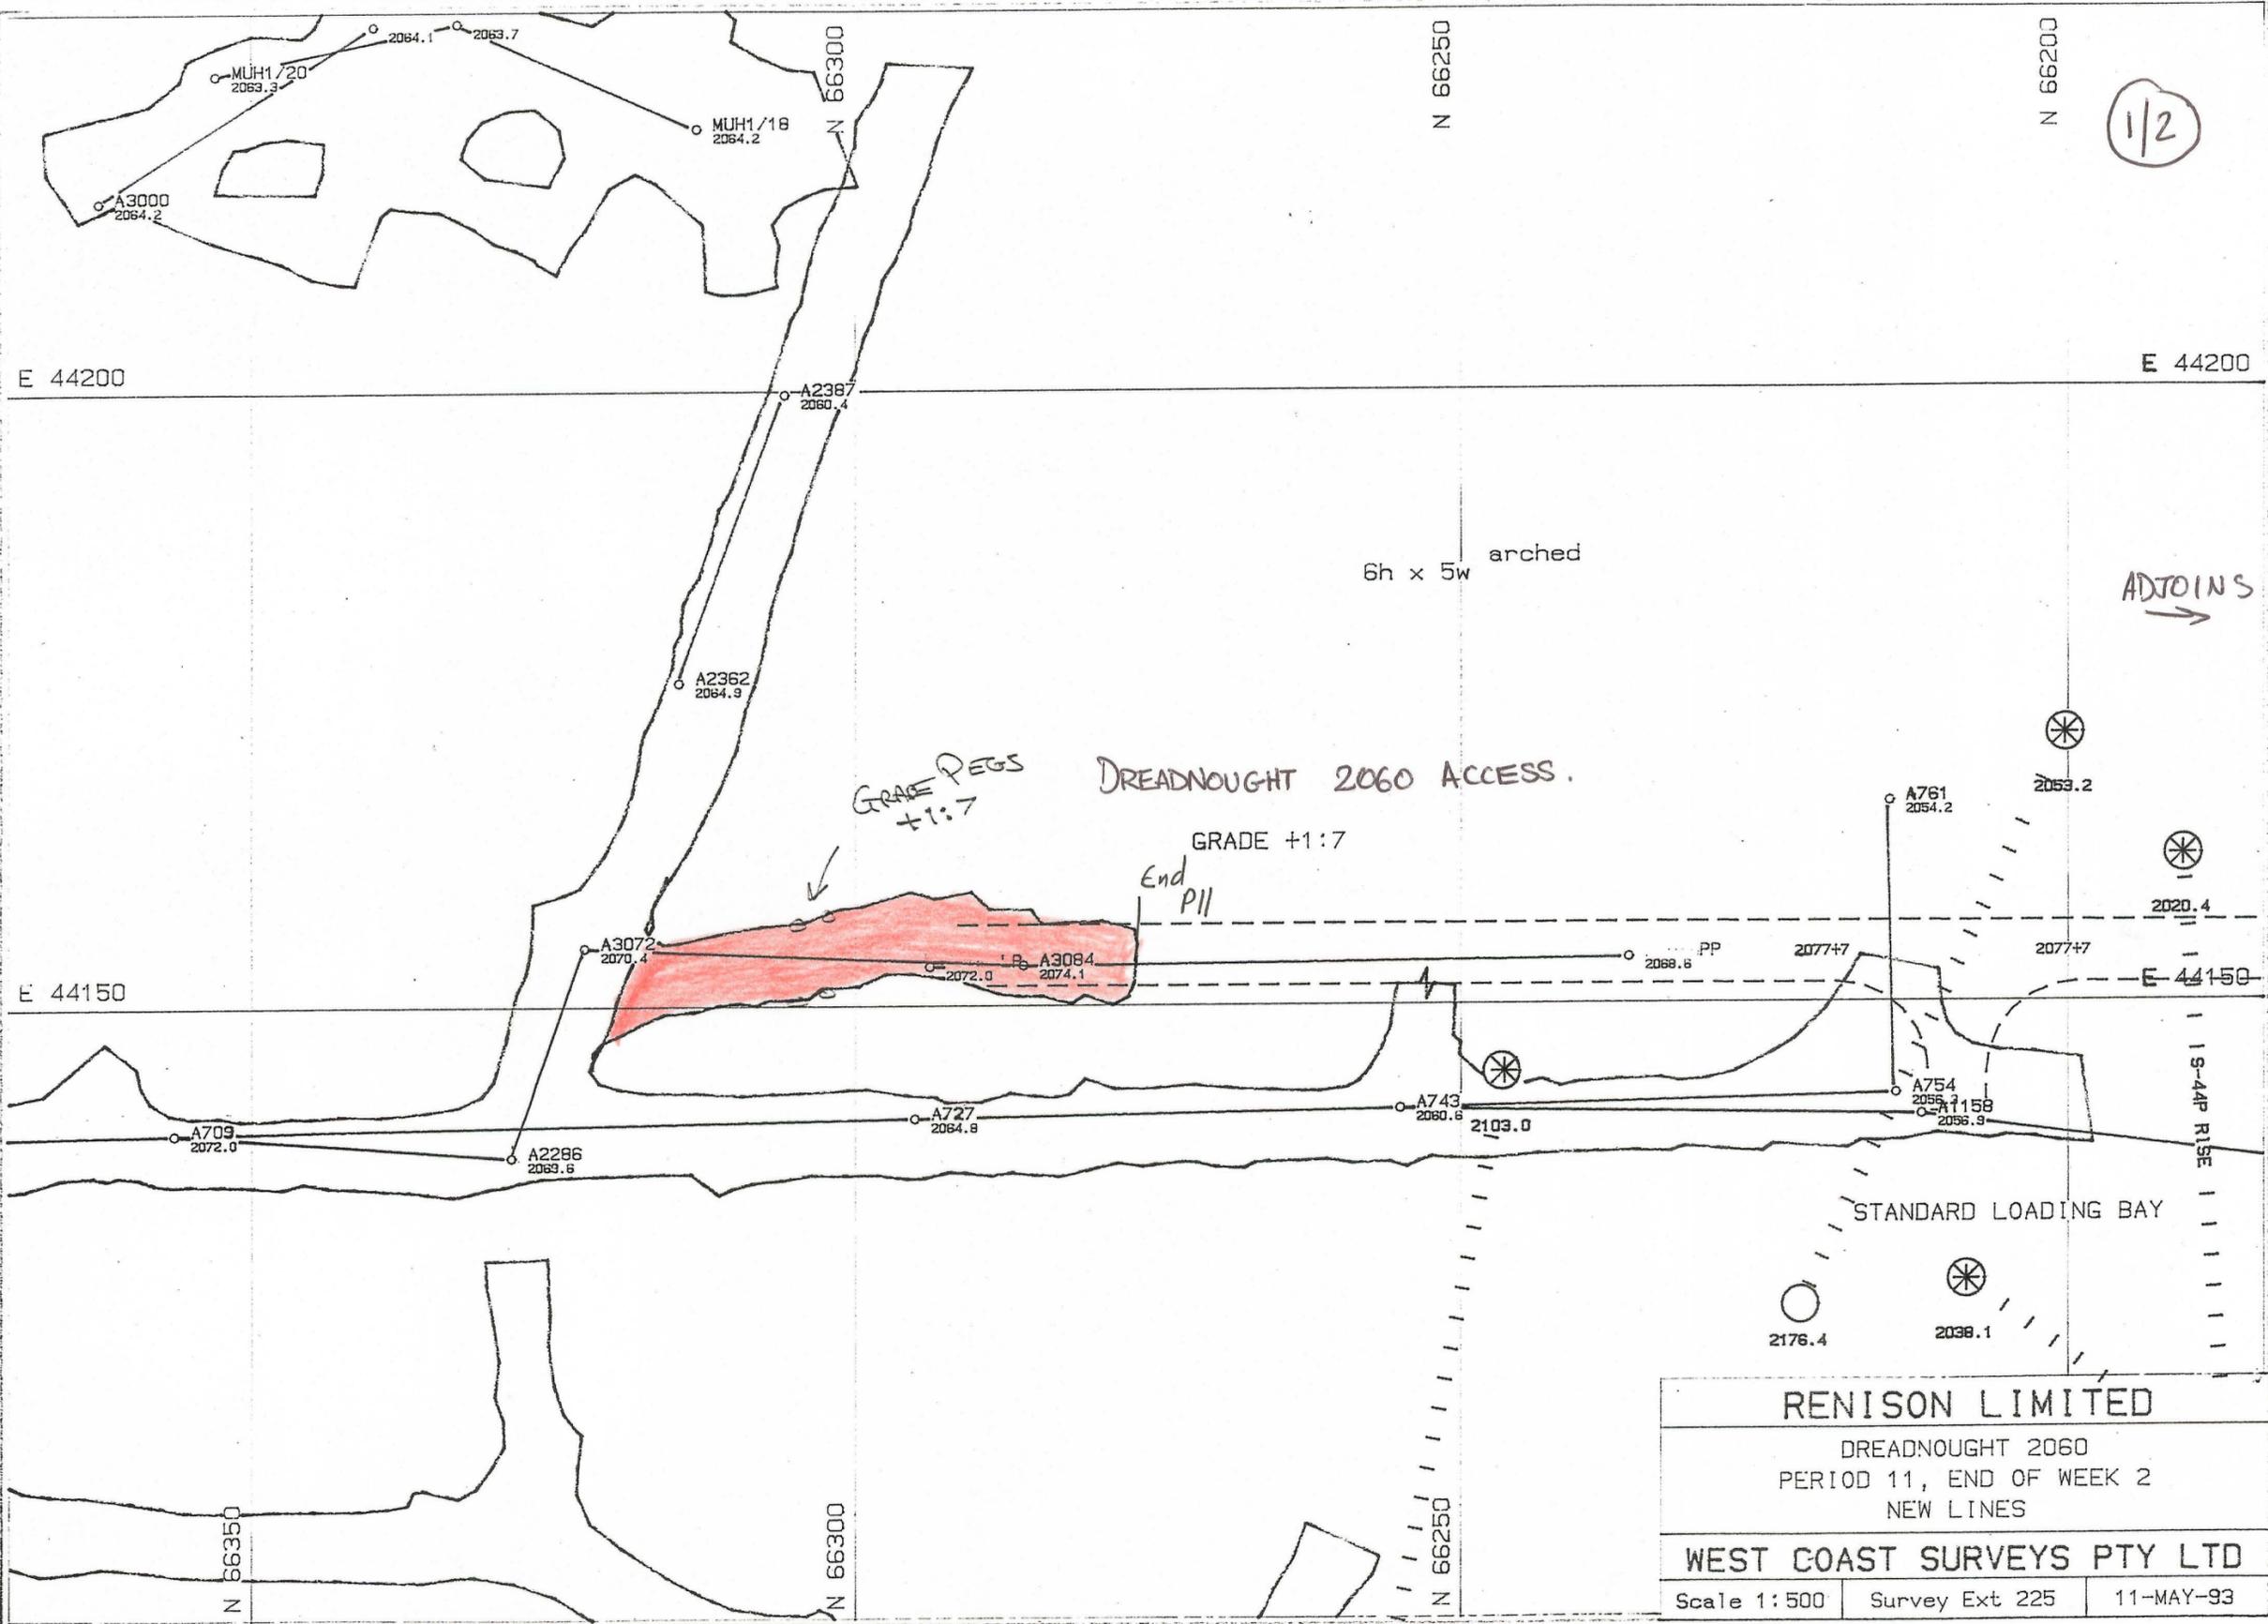

RENISON LIMITED		
DREADNOUGHT 2060 PERIOD 11, END OF WEEK 2 NEW LINES		
WEST COAST SURVEYS PTY LTD		
Scale 1:500	Survey Ext 225	11-MAY-93