


0376-091

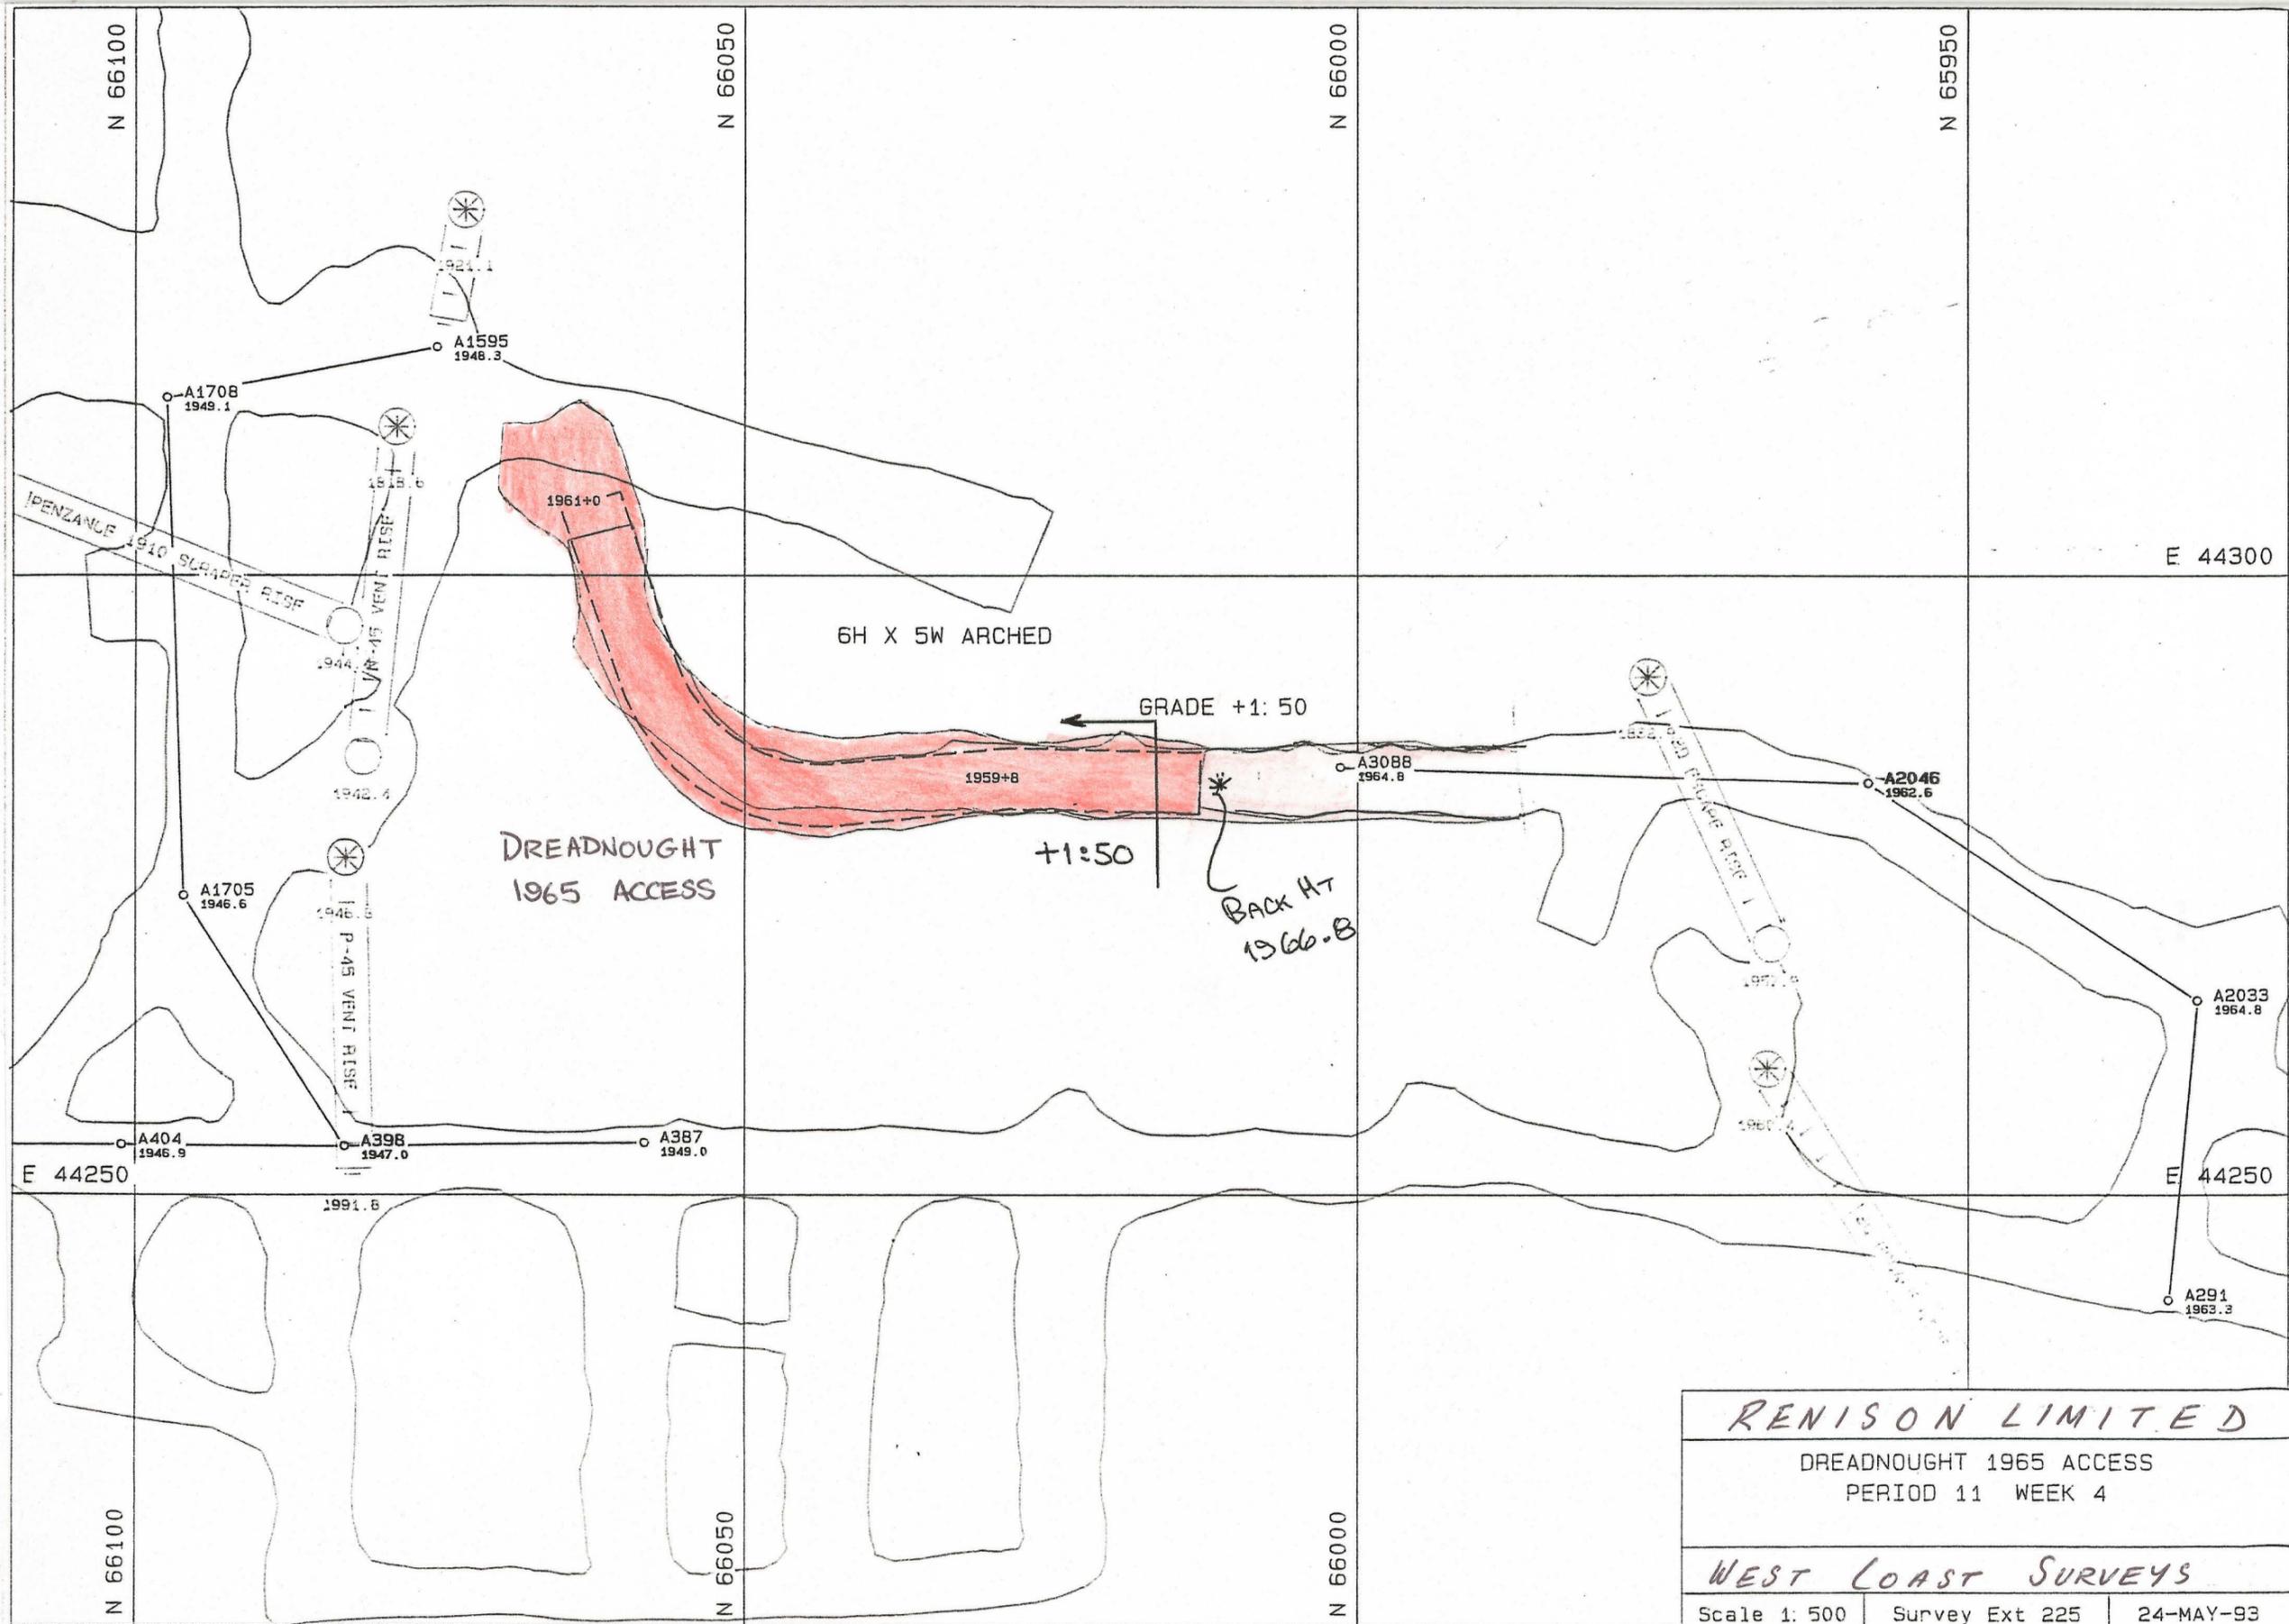

RENISON LIMITED		
DREADNOUGHT 1965 ACCESS PERIOD 11 WEEK 4		
WEST COAST SURVEYS		
Scale 1: 500	Survey Ext 225	24-MAY-93

5 cm

DREADA.PF