


0376-093

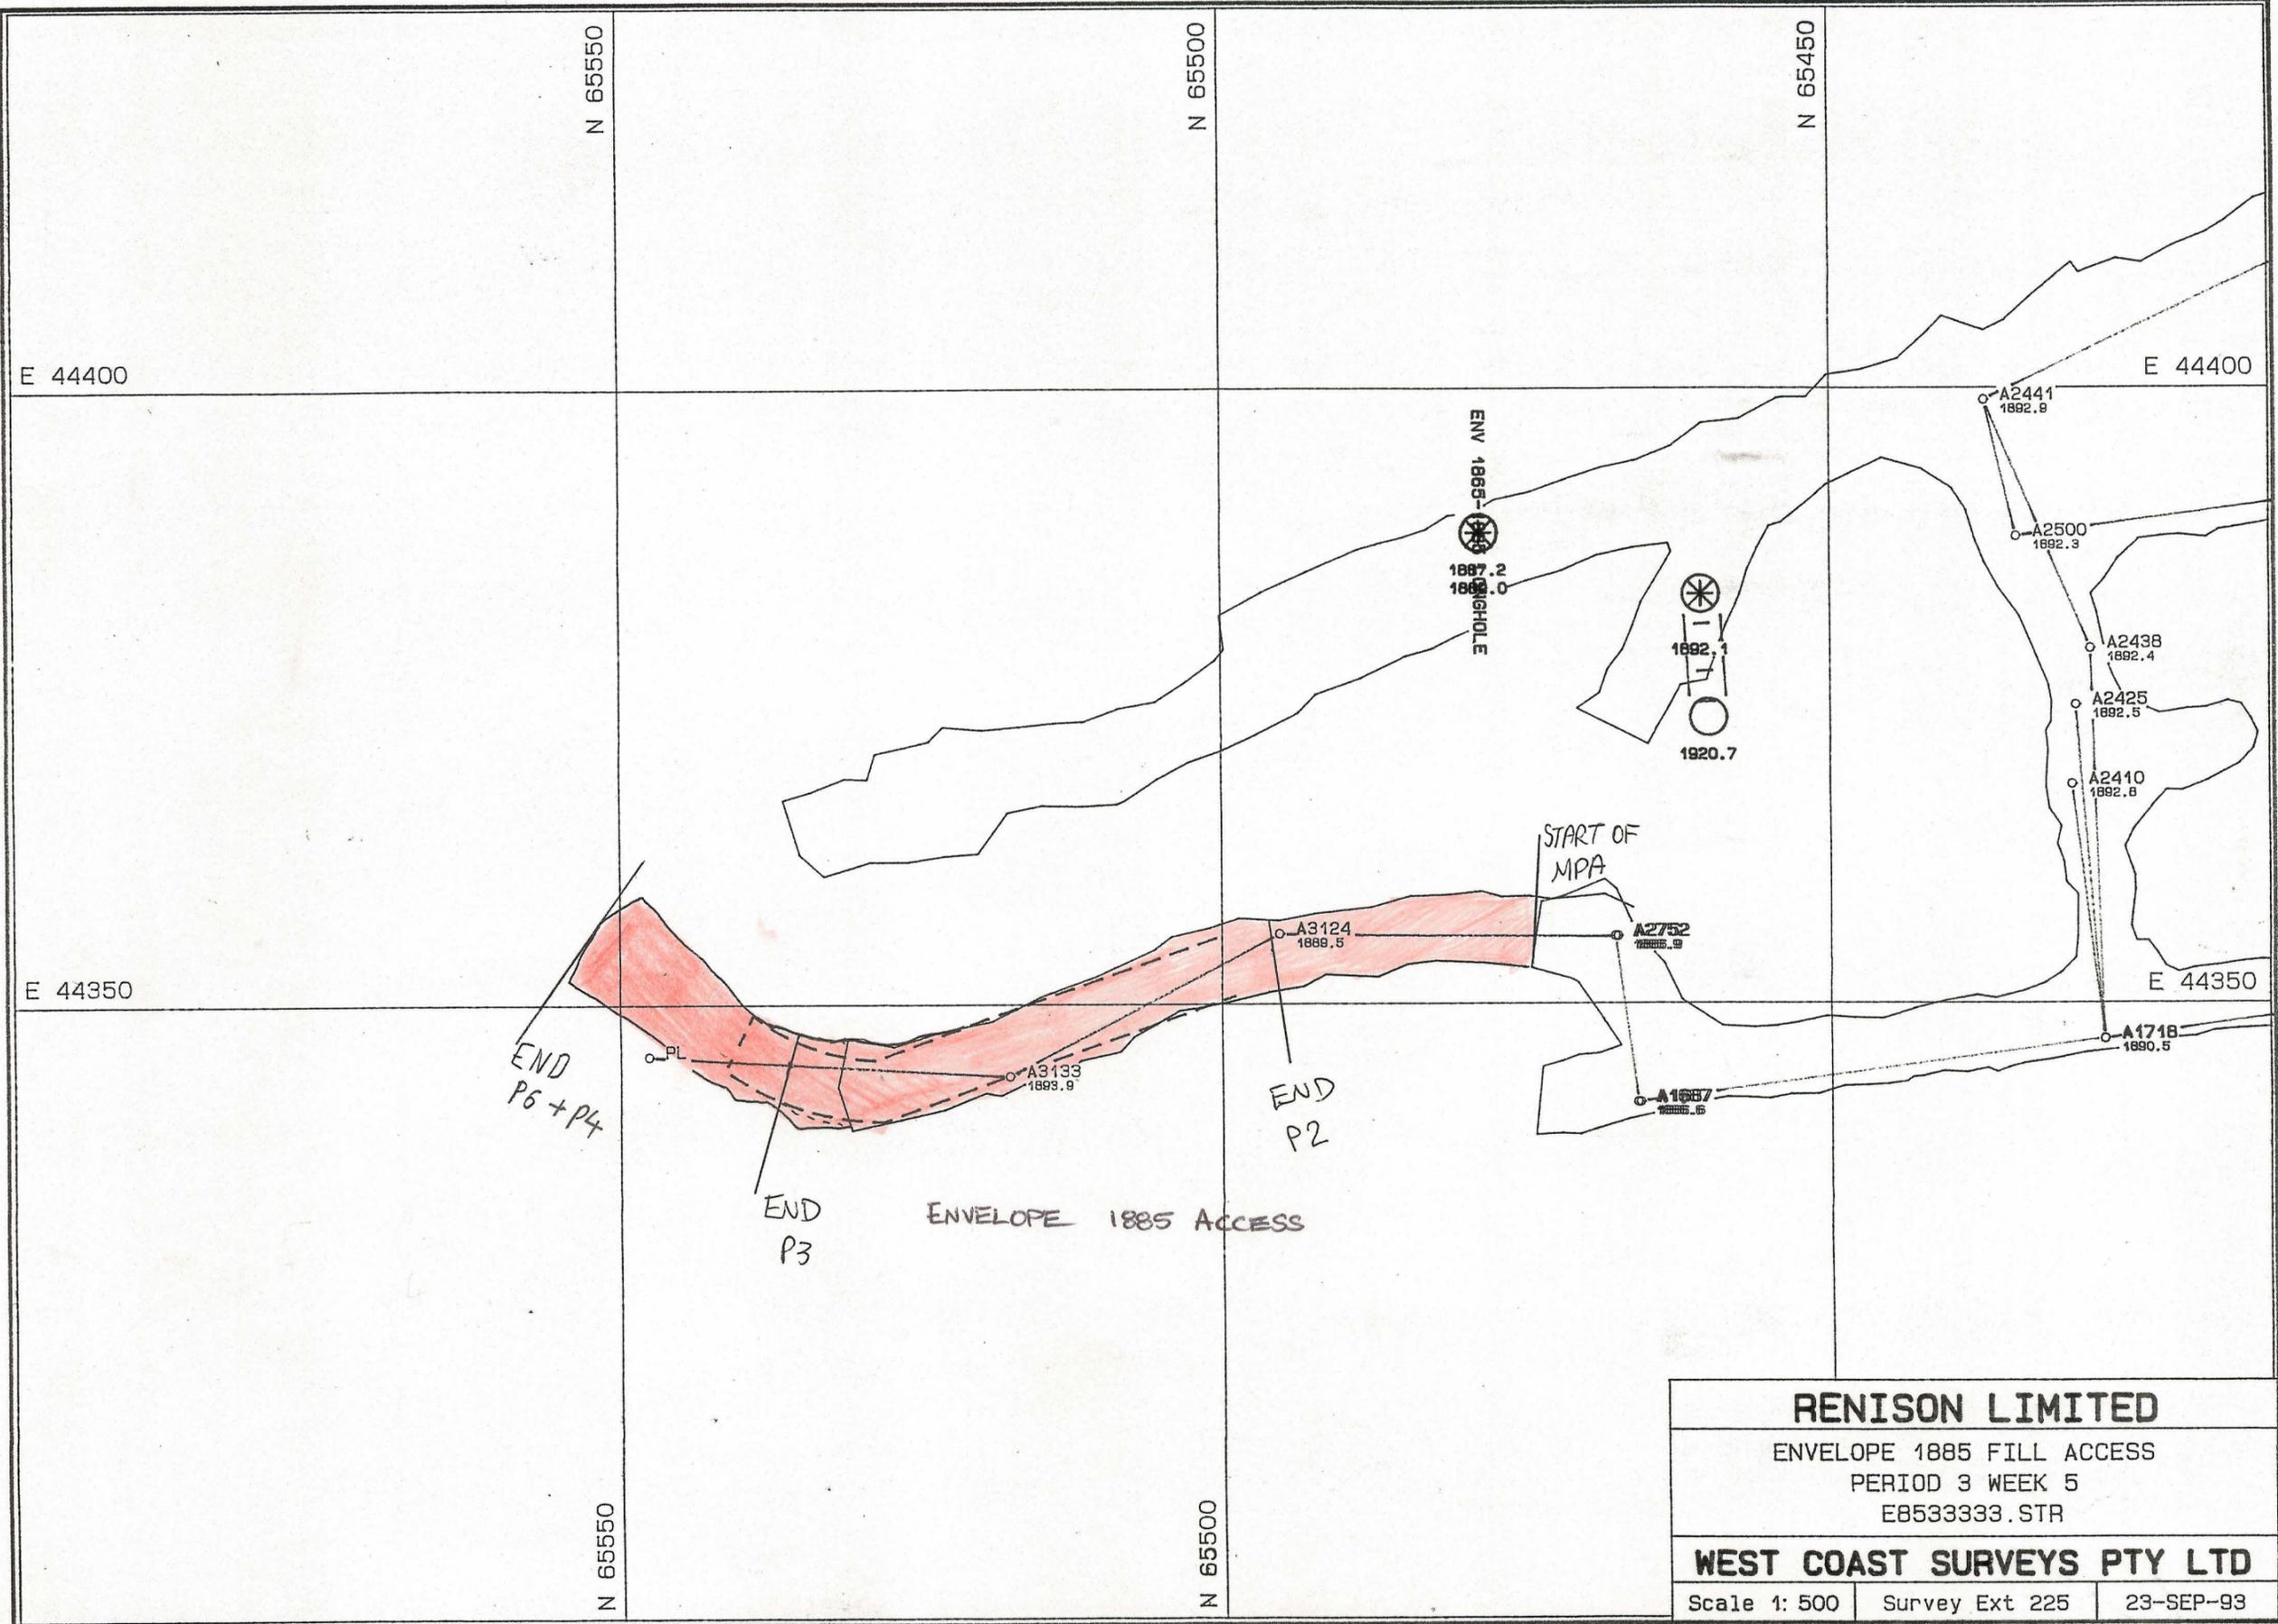

RENISON LIMITED		
ENVELOPE 1885 FILL ACCESS		
PERIOD 3 WEEK 5		
EB533333.STR		
WEST COAST SURVEYS PTY LTD		
Scale 1: 500	Survey Ext 225	23-SEP-93

5 cm