



0376 - 094

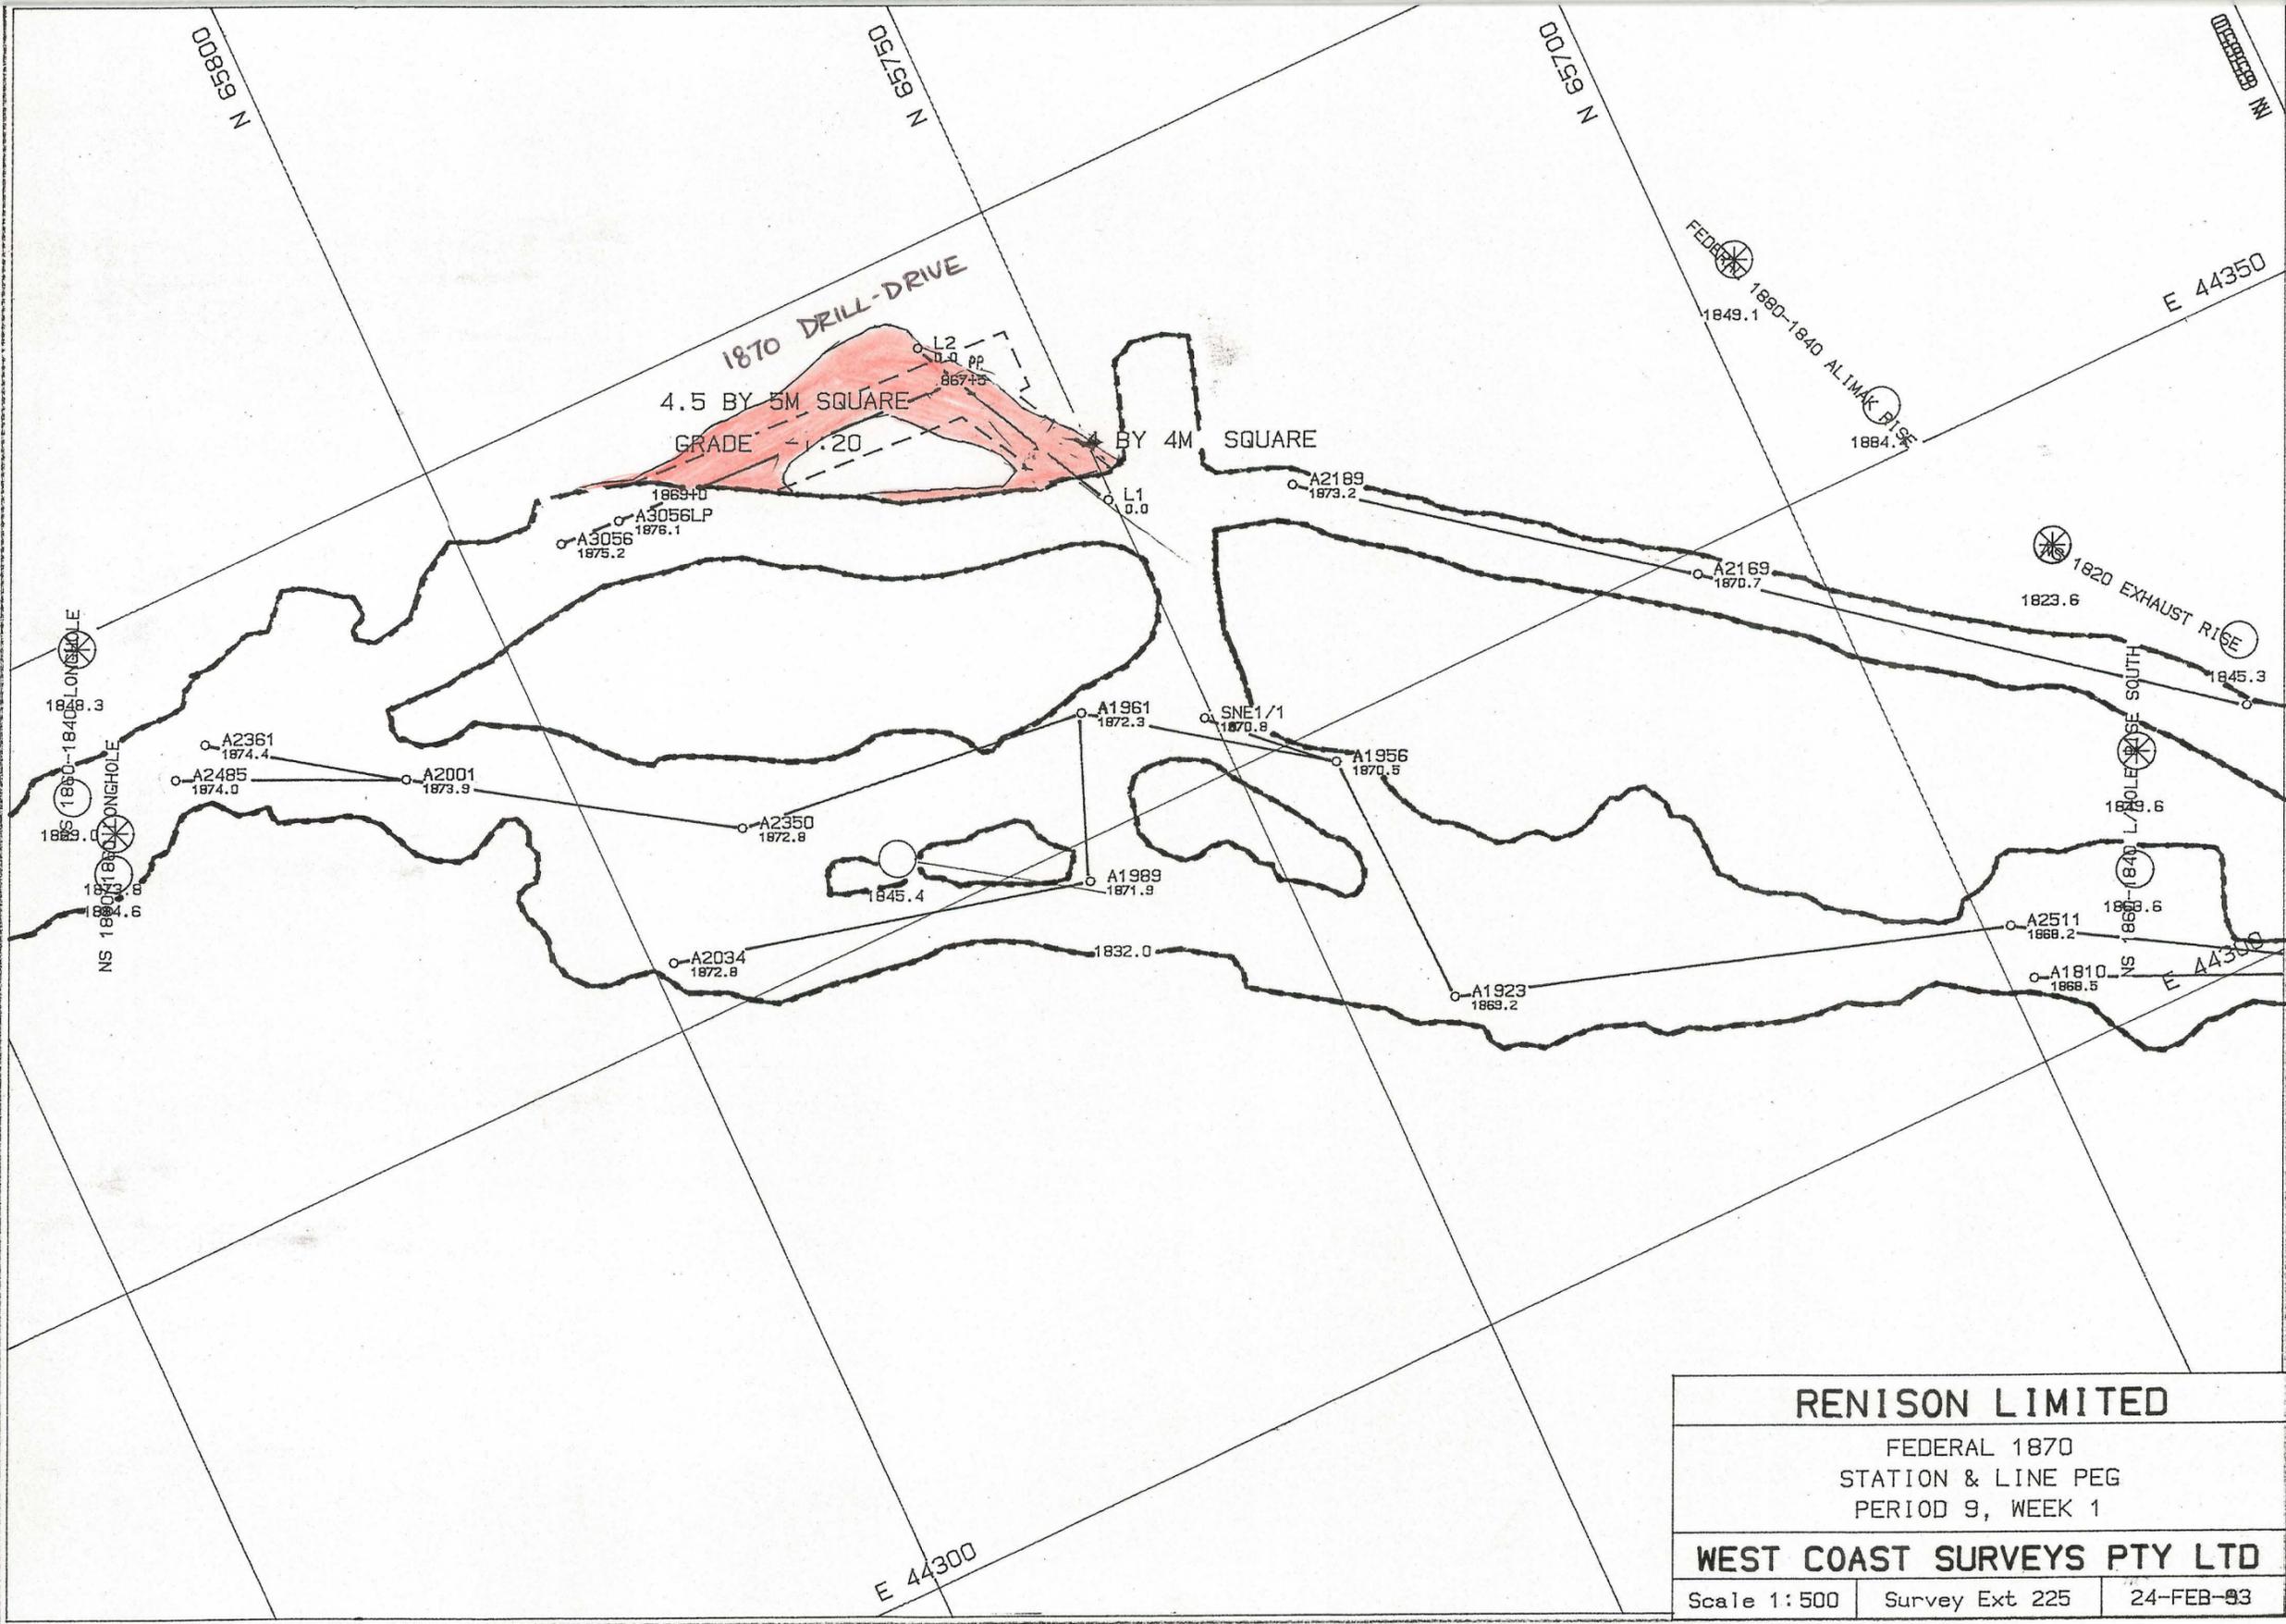

RENISON LIMITED		
FEDERAL 1870 STATION & LINE PEG PERIOD 9, WEEK 1		
WEST COAST SURVEYS PTY LTD		
Scale 1:500	Survey Ext 225	24-FEB-83

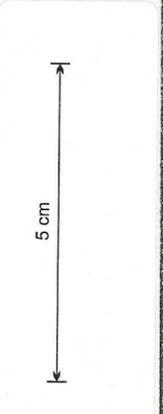

FEDERB. PF