


0376-095

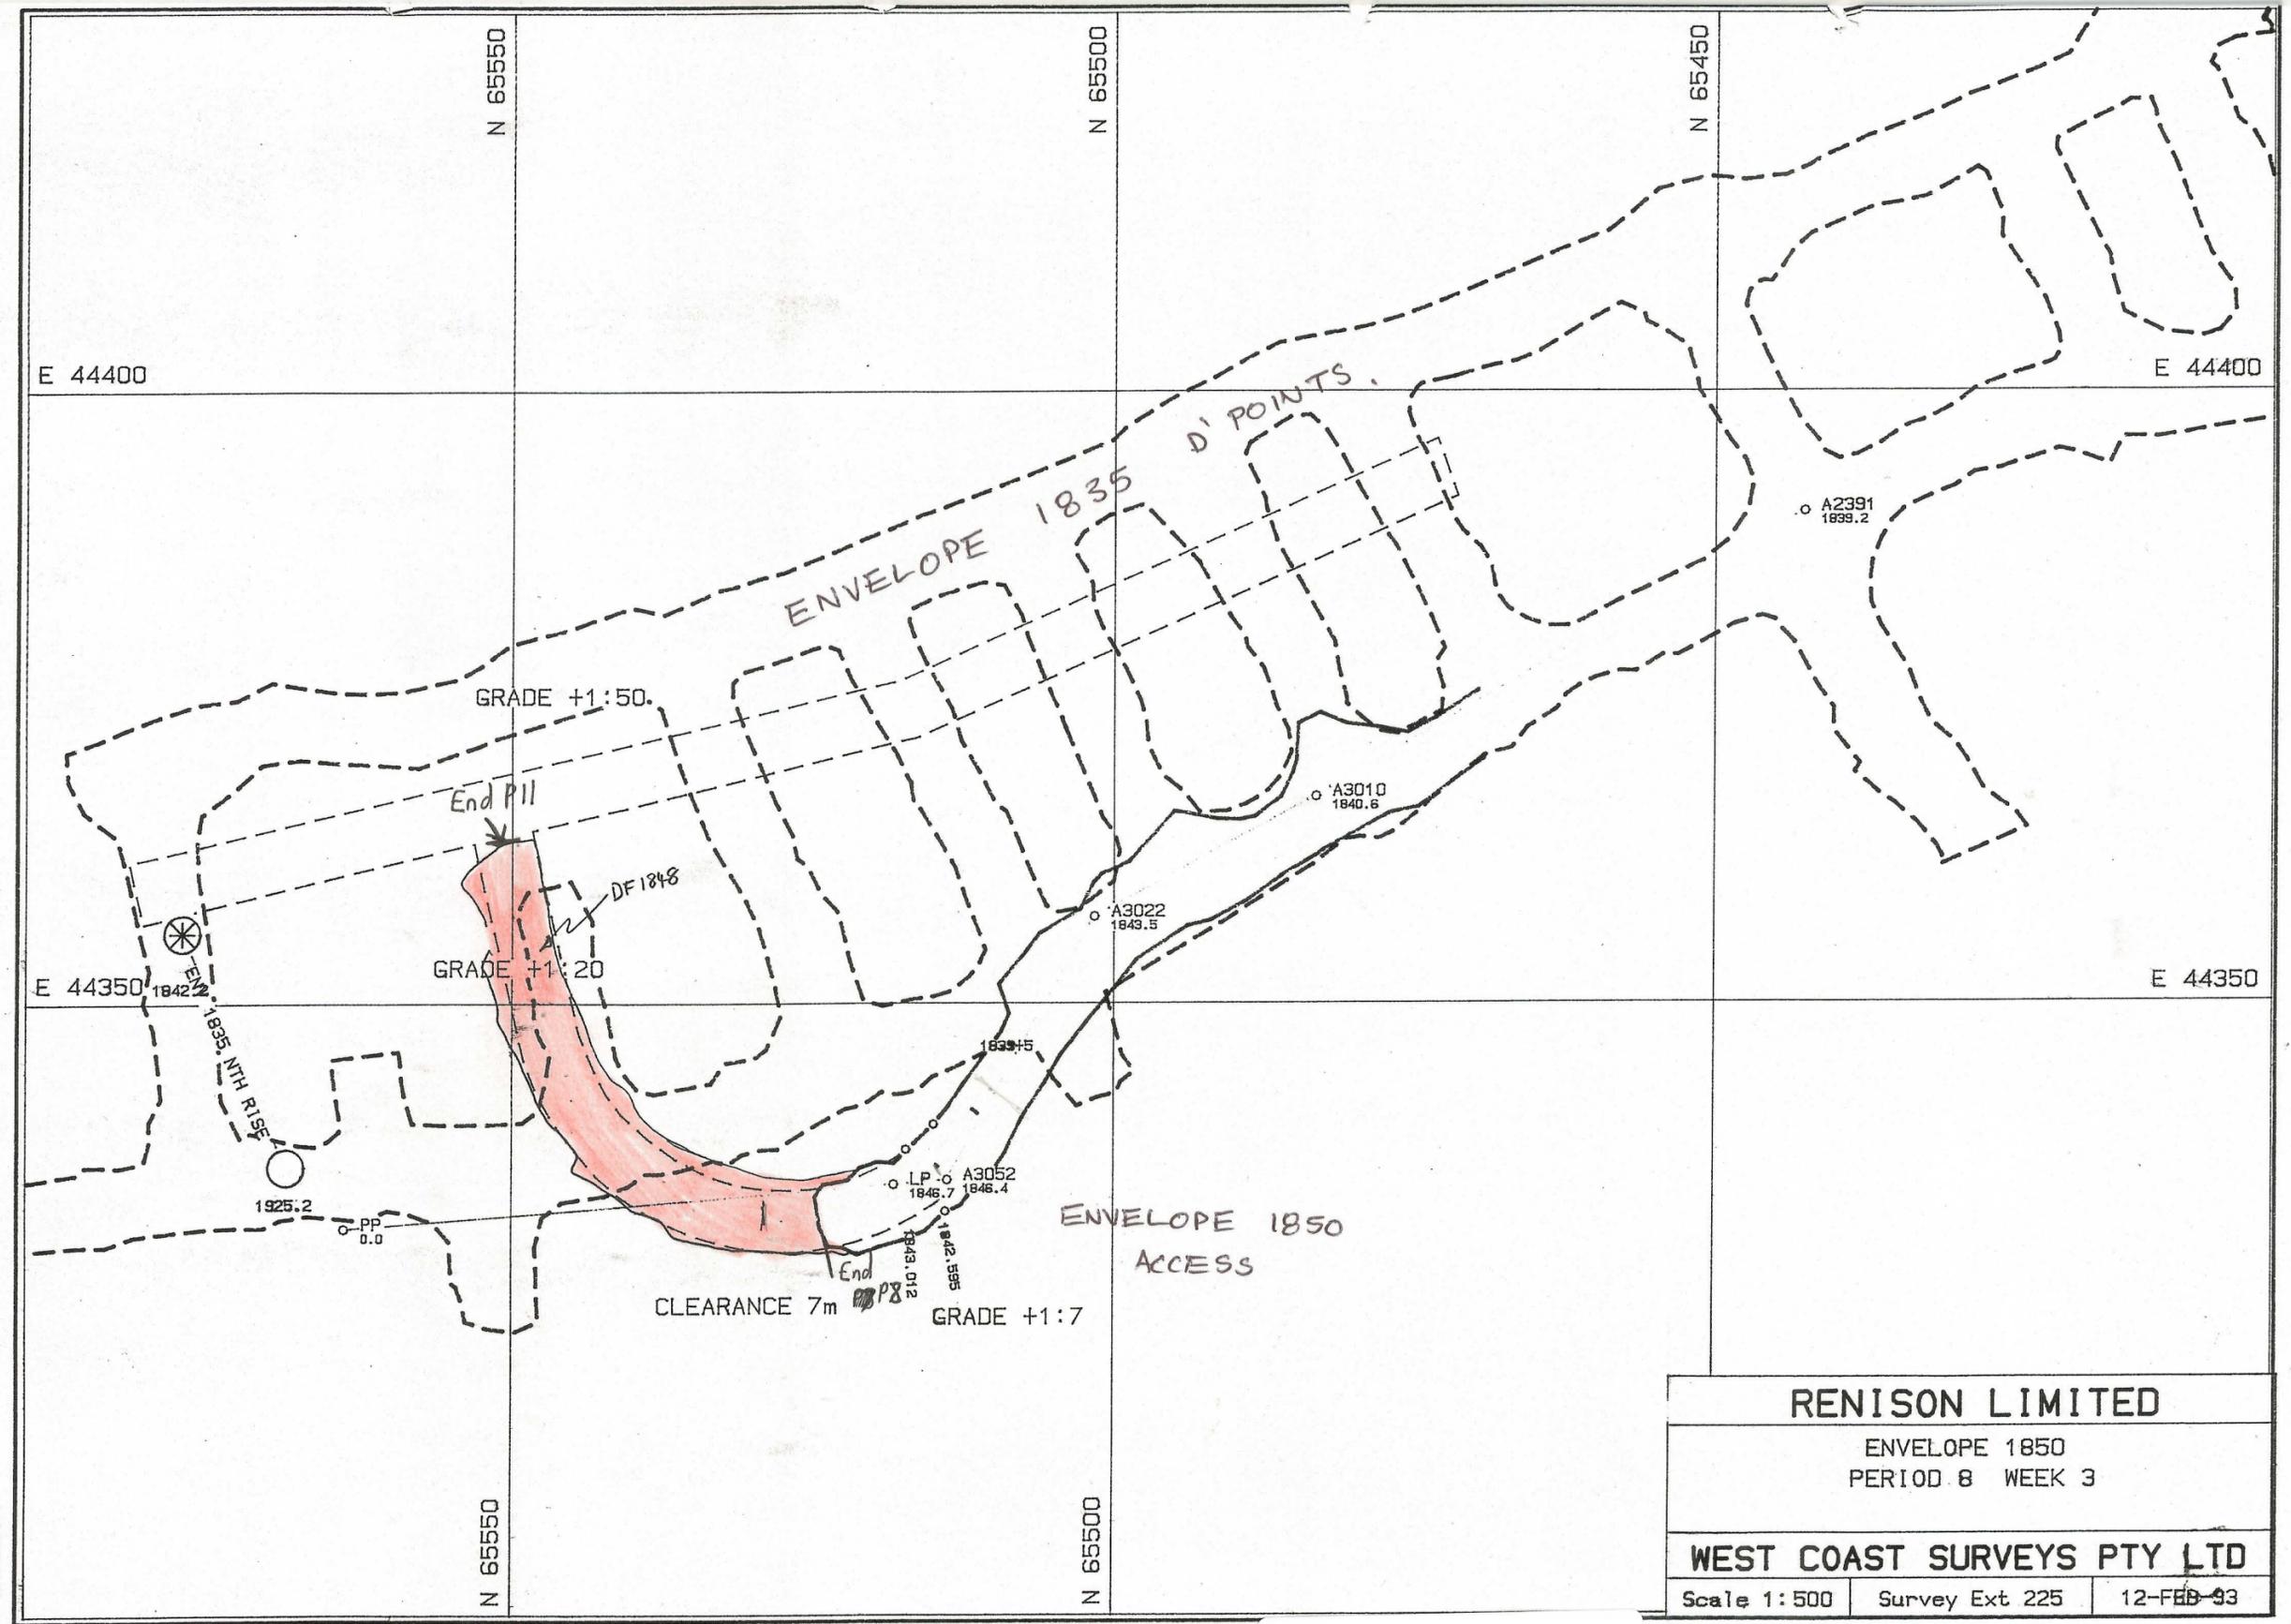

RENISON LIMITED		
ENVELOPE 1850 PERIOD 8 WEEK 3		
WEST COAST SURVEYS PTY LTD		
Scale 1:500	Survey Ext 225	12-FEB-93

ENVEL.C.PF

