


0376 - 096

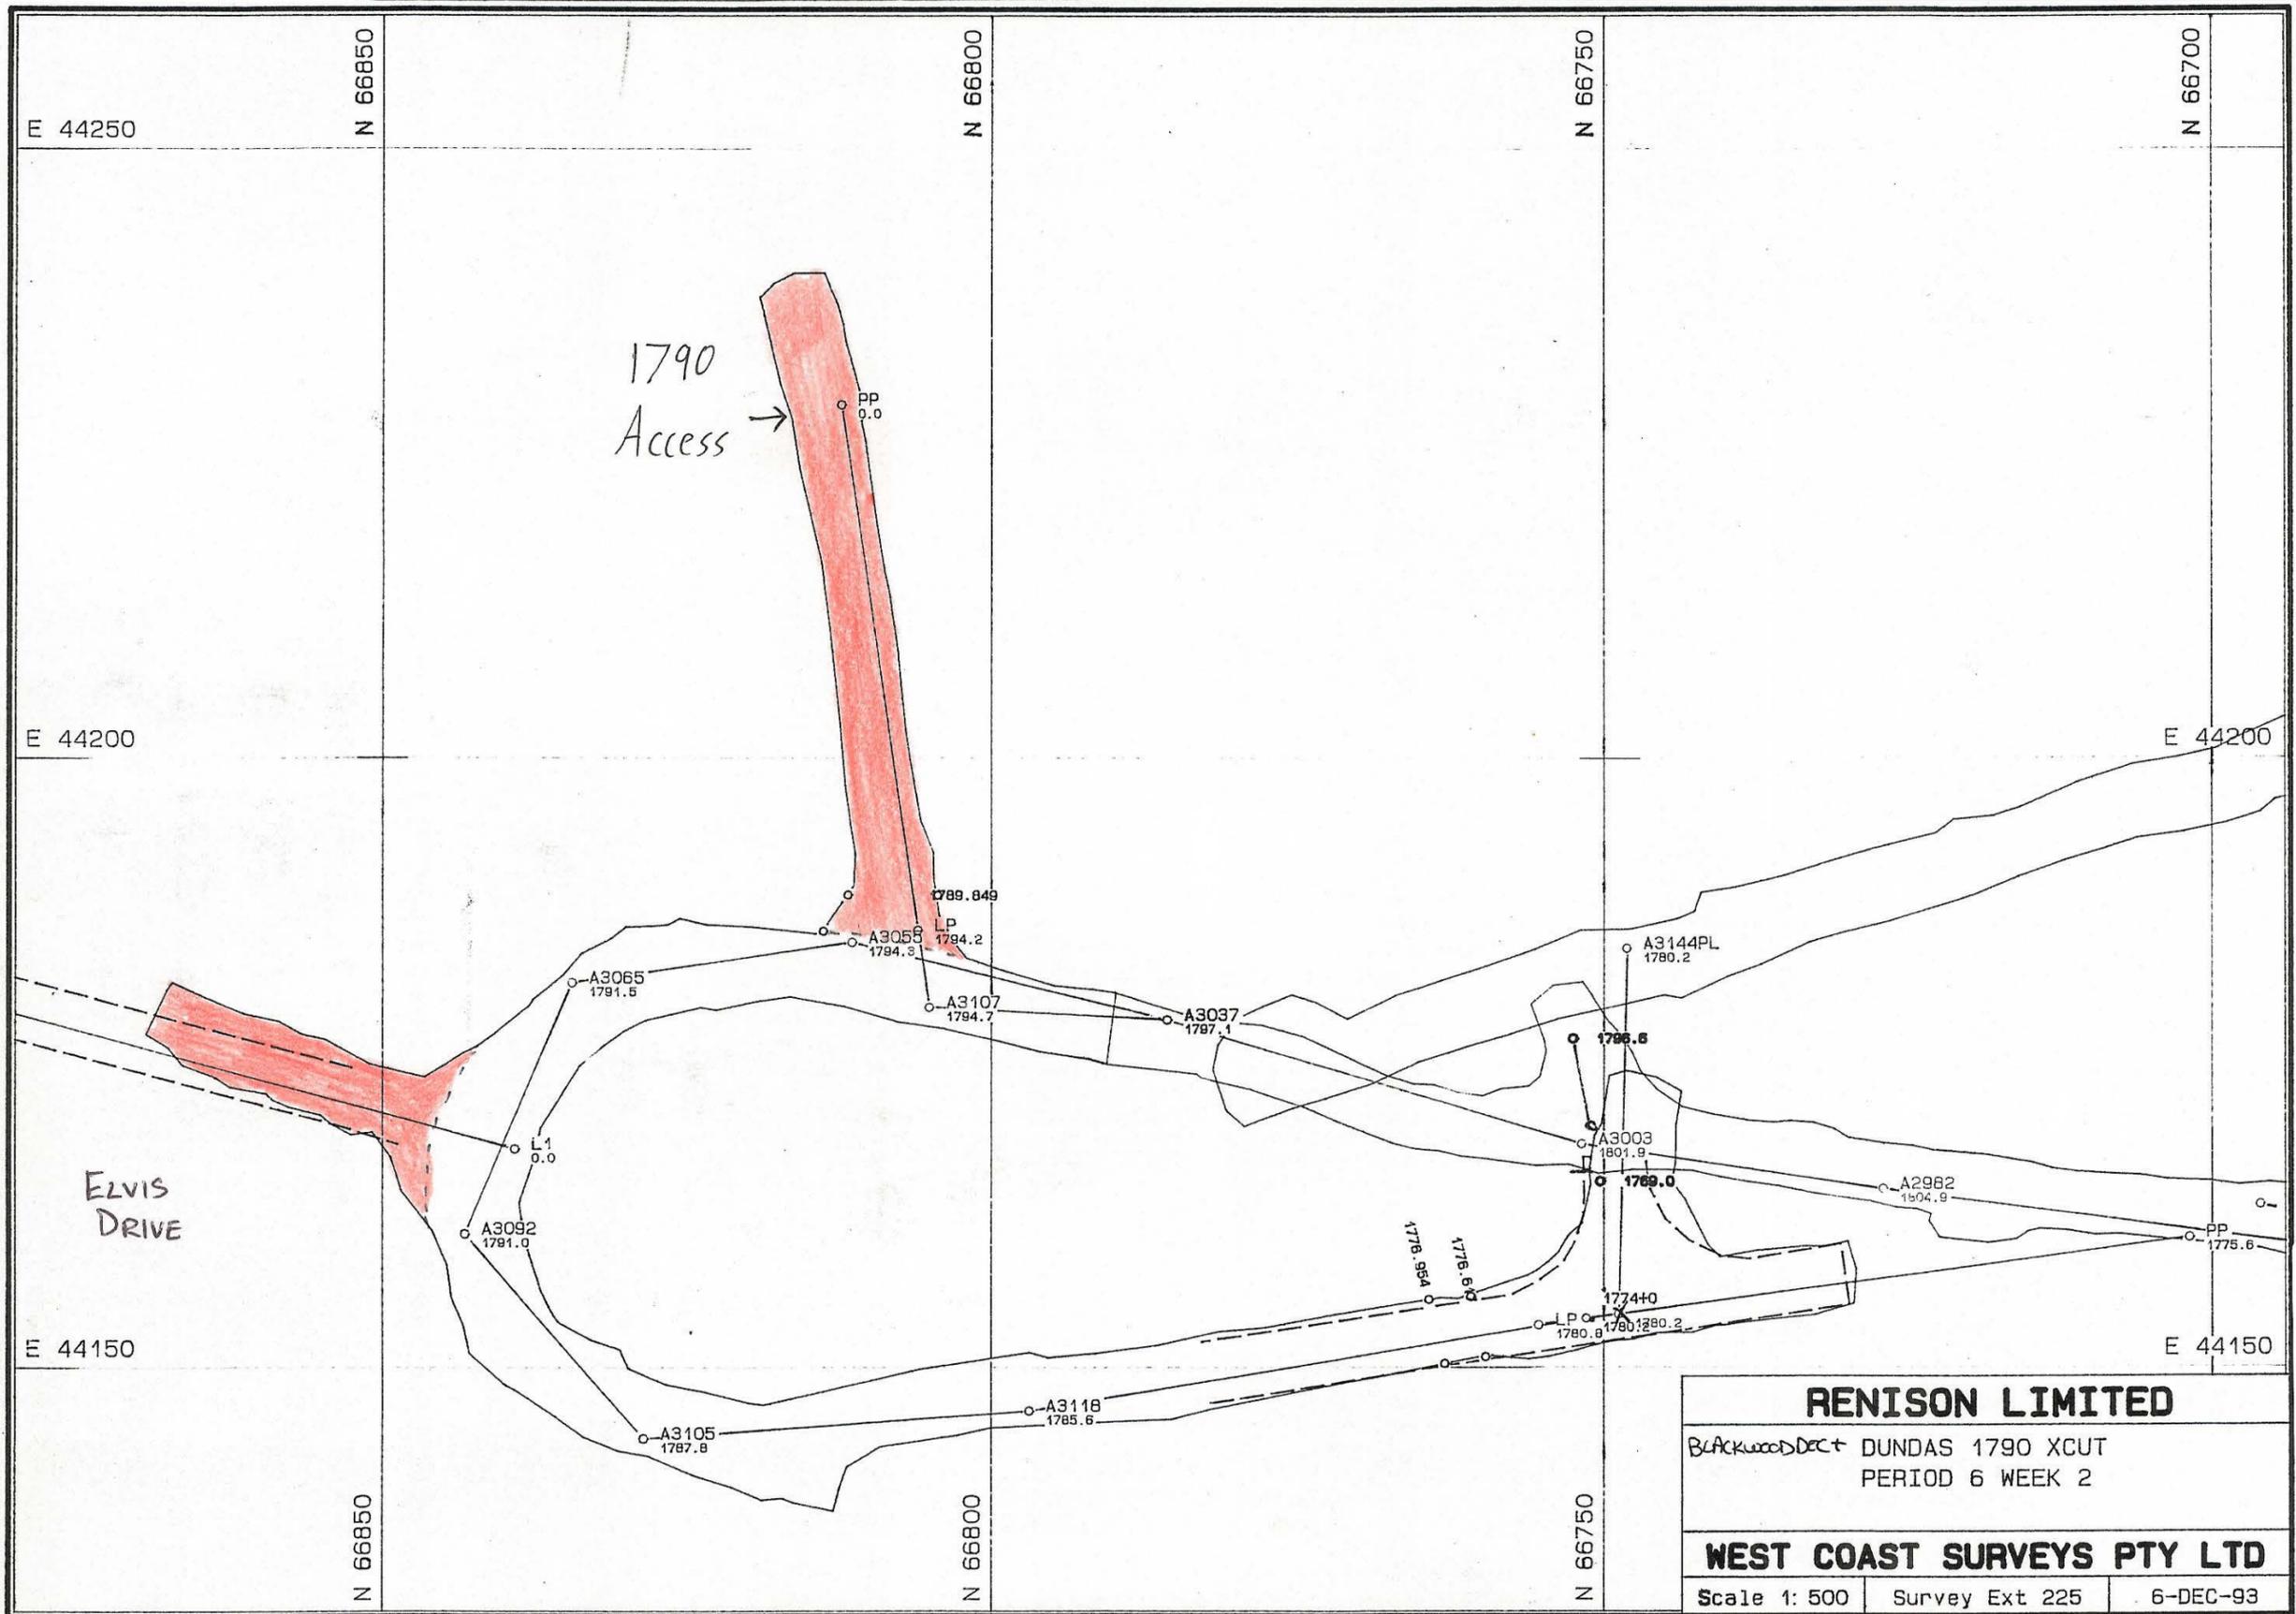

RENISON LIMITED		
BLACKWOOD DEC + DUNDAS 1790 XCUT PERIOD 6 WEEK 2		
WEST COAST SURVEYS PTY LTD		
Scale 1: 500	Survey Ext 225	6-DEC-93

5 cm

BLACKD.PF