


0376 - 097

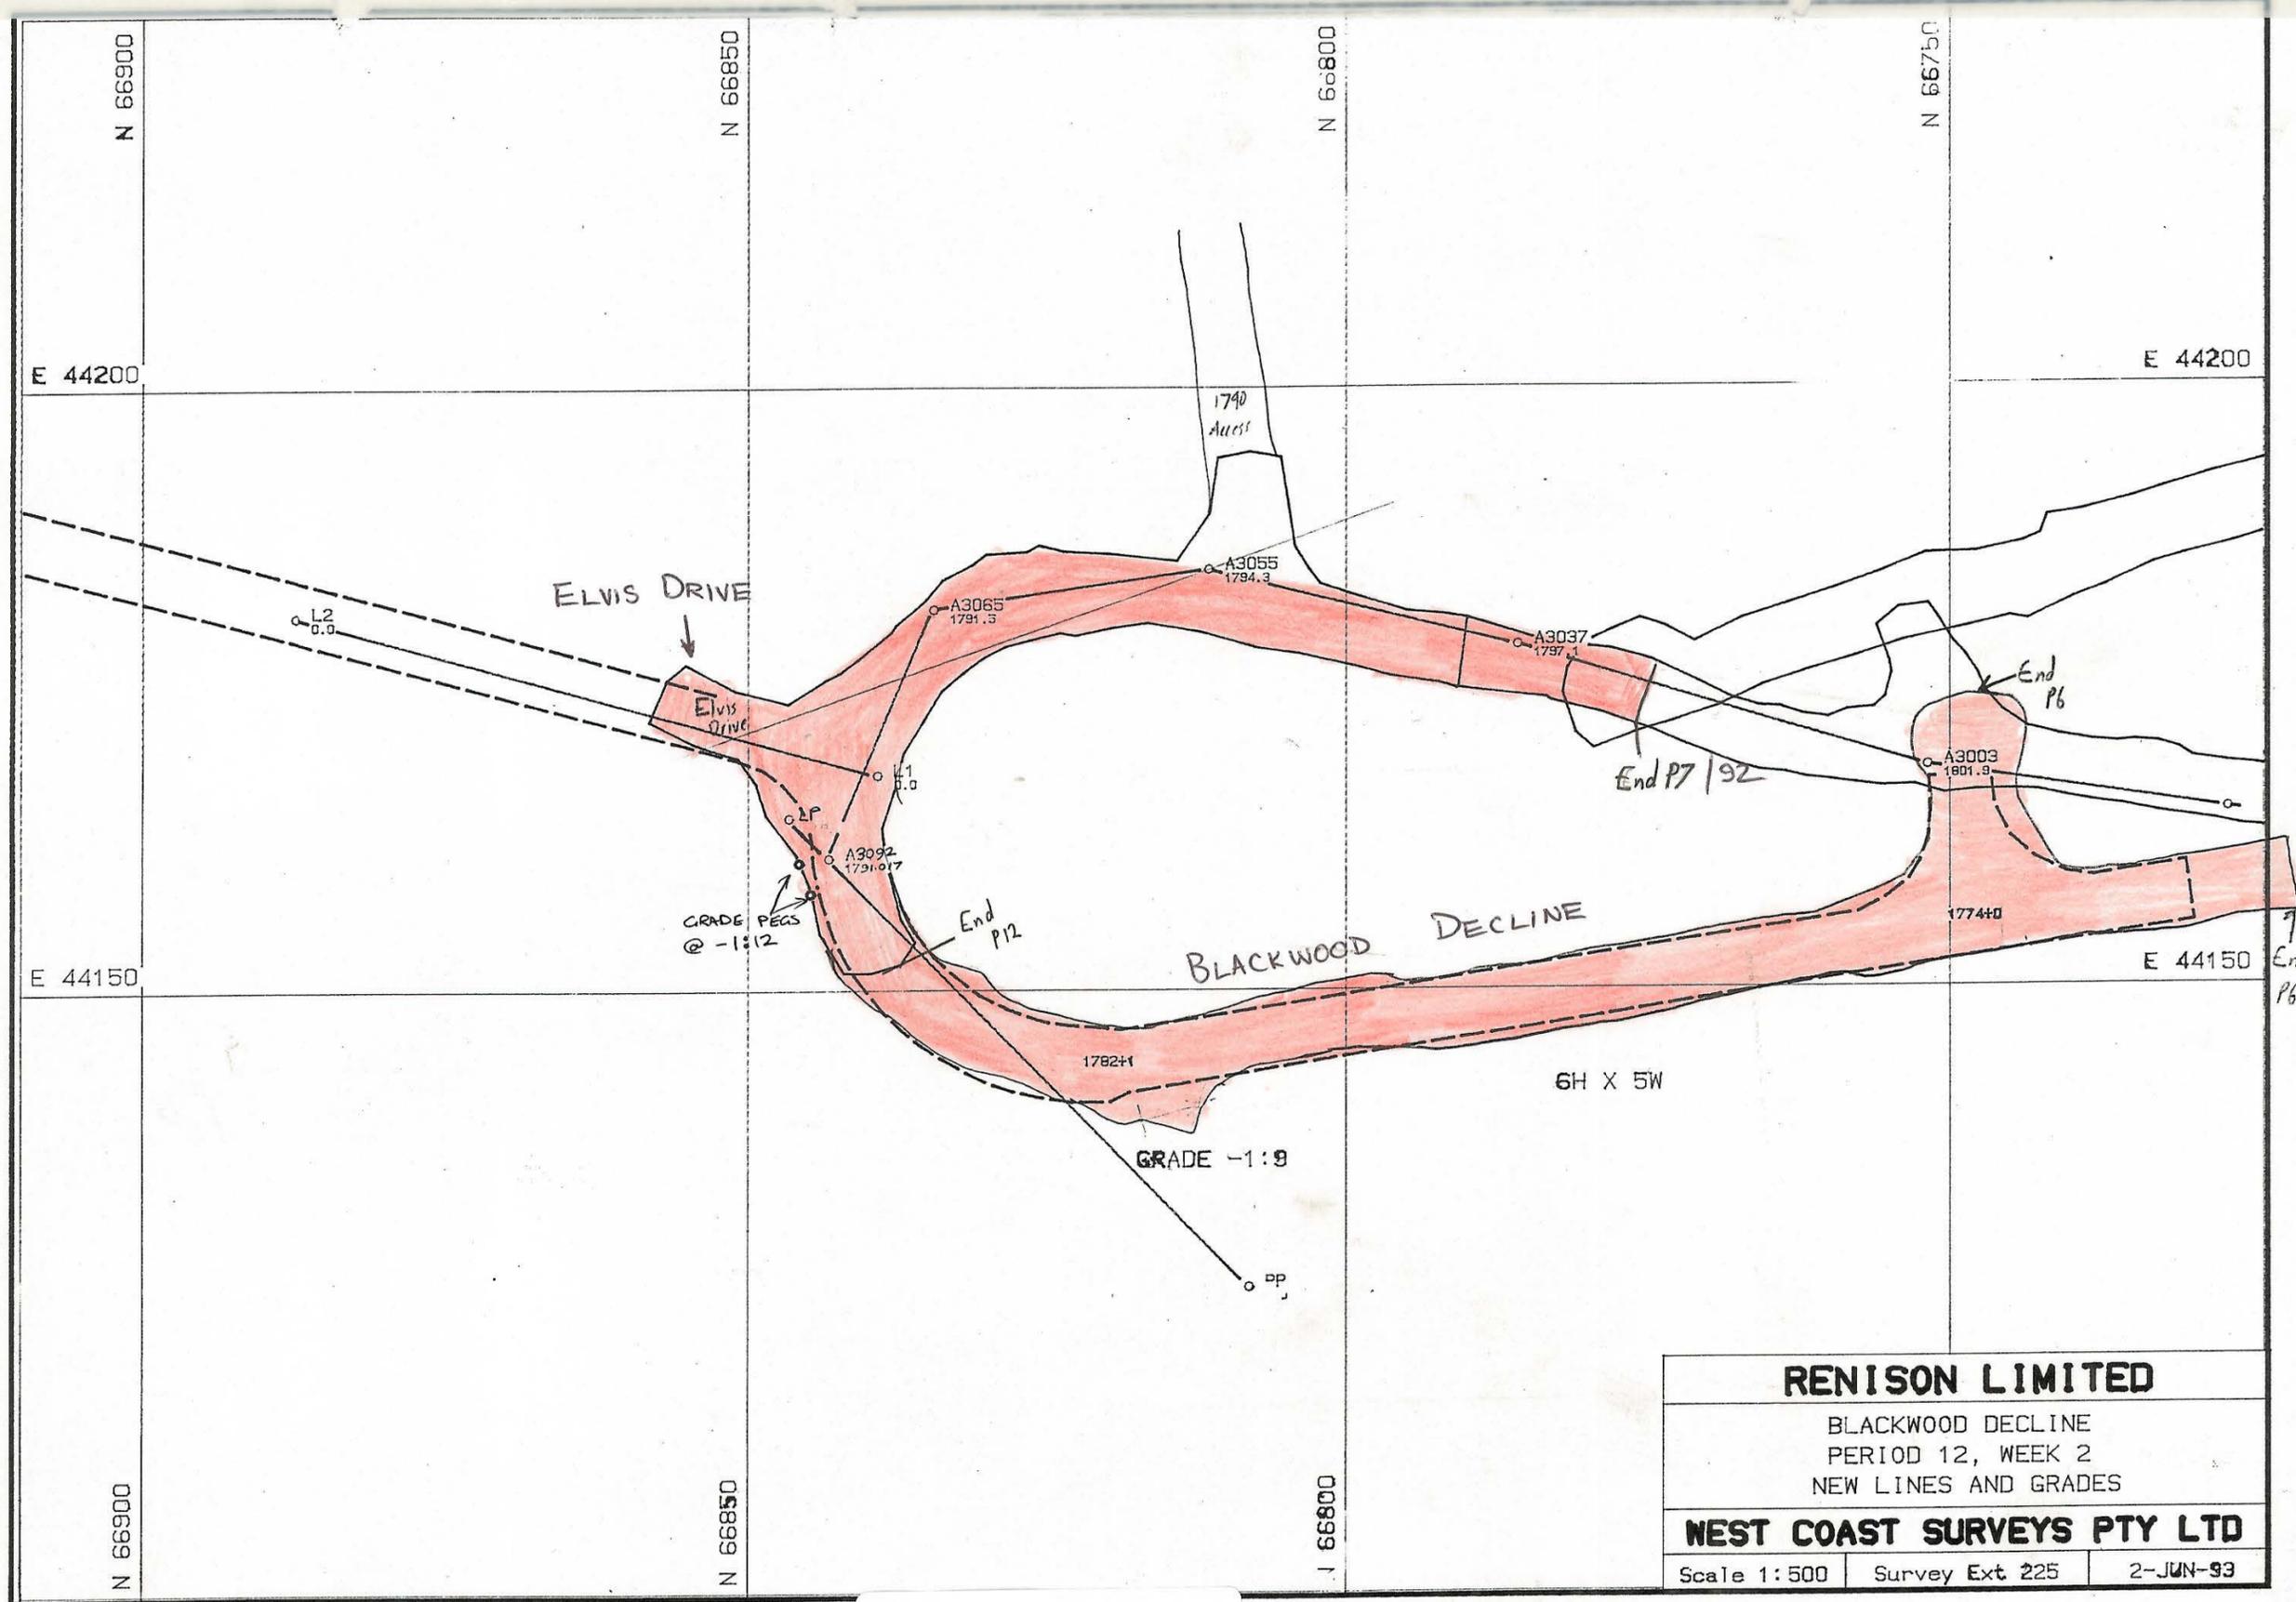

RENISON LIMITED		
BLACKWOOD DECLINE PERIOD 12, WEEK 2 NEW LINES AND GRADES		
WEST COAST SURVEYS PTY LTD		
Scale 1:500	Survey Ext 225	2-JUN-93

BLACKA.PF

5 cm