


0376-098

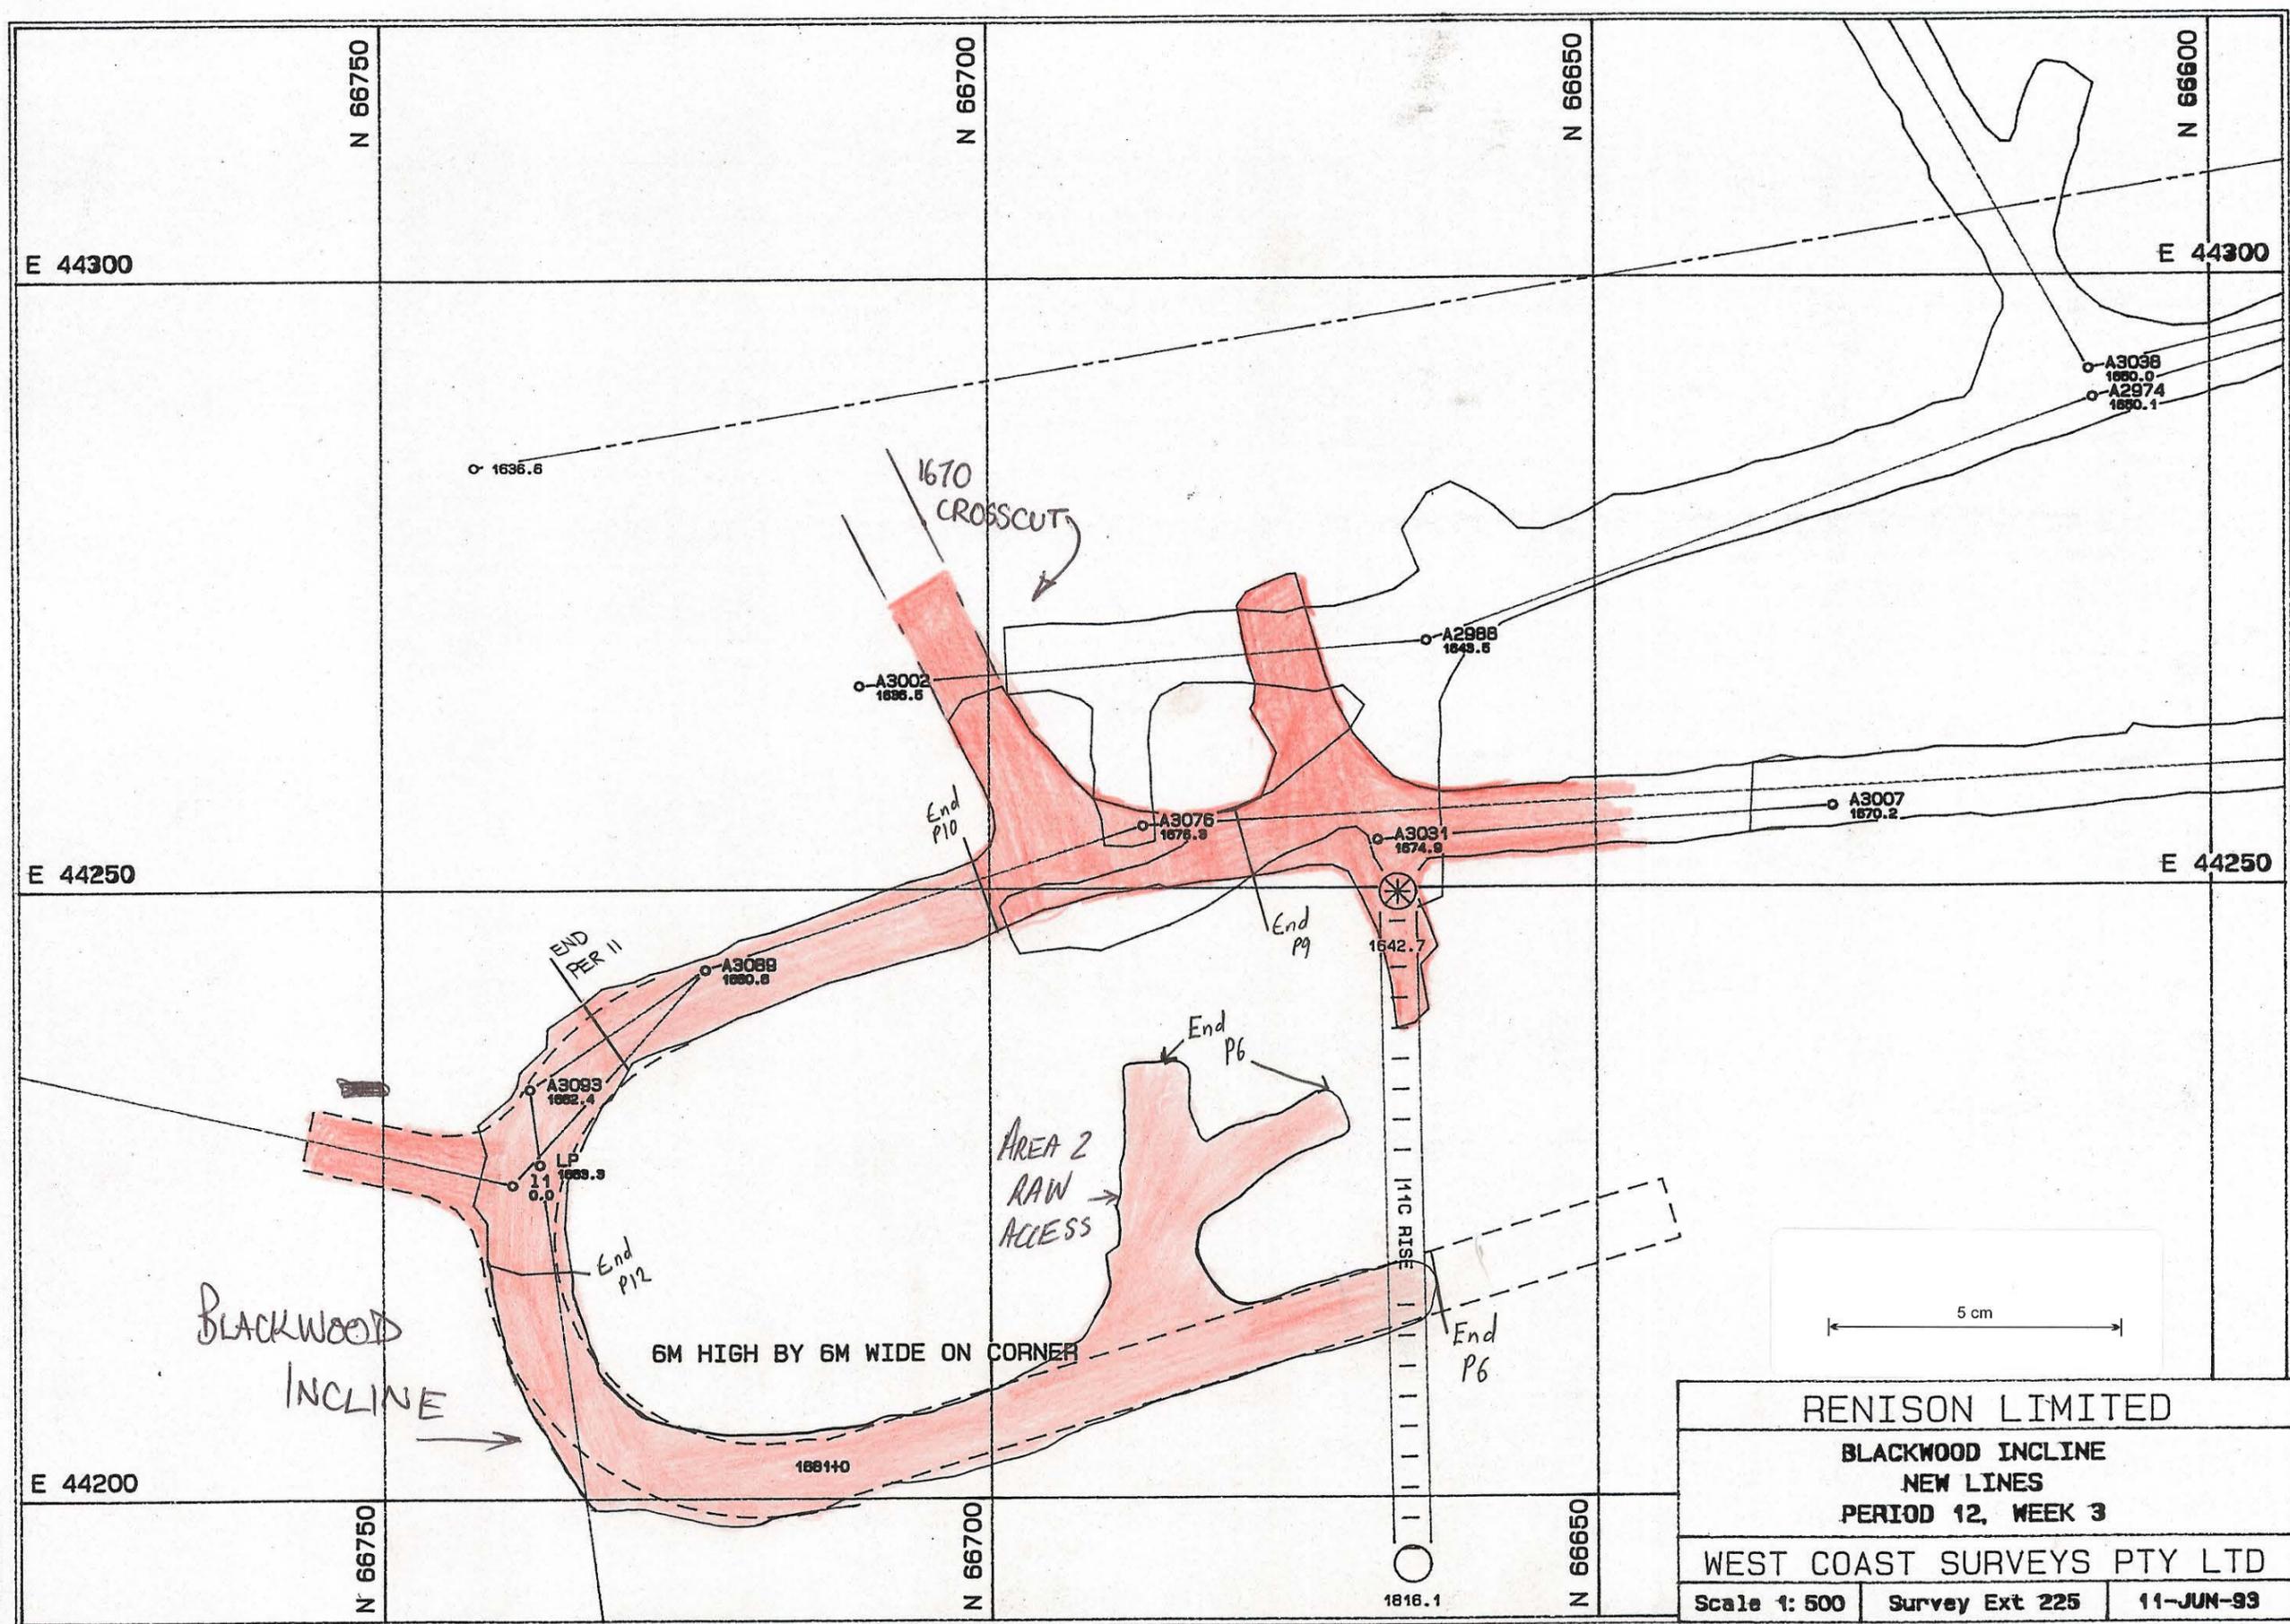

RENISON LIMITED		
BLACKWOOD INCLINE		
NEW LINES		
PERIOD 12, WEEK 3		
WEST COAST SURVEYS PTY LTD		
Scale 1: 500	Survey Ext 225	11-JUN-93

BLACKA.PF