


5 cm

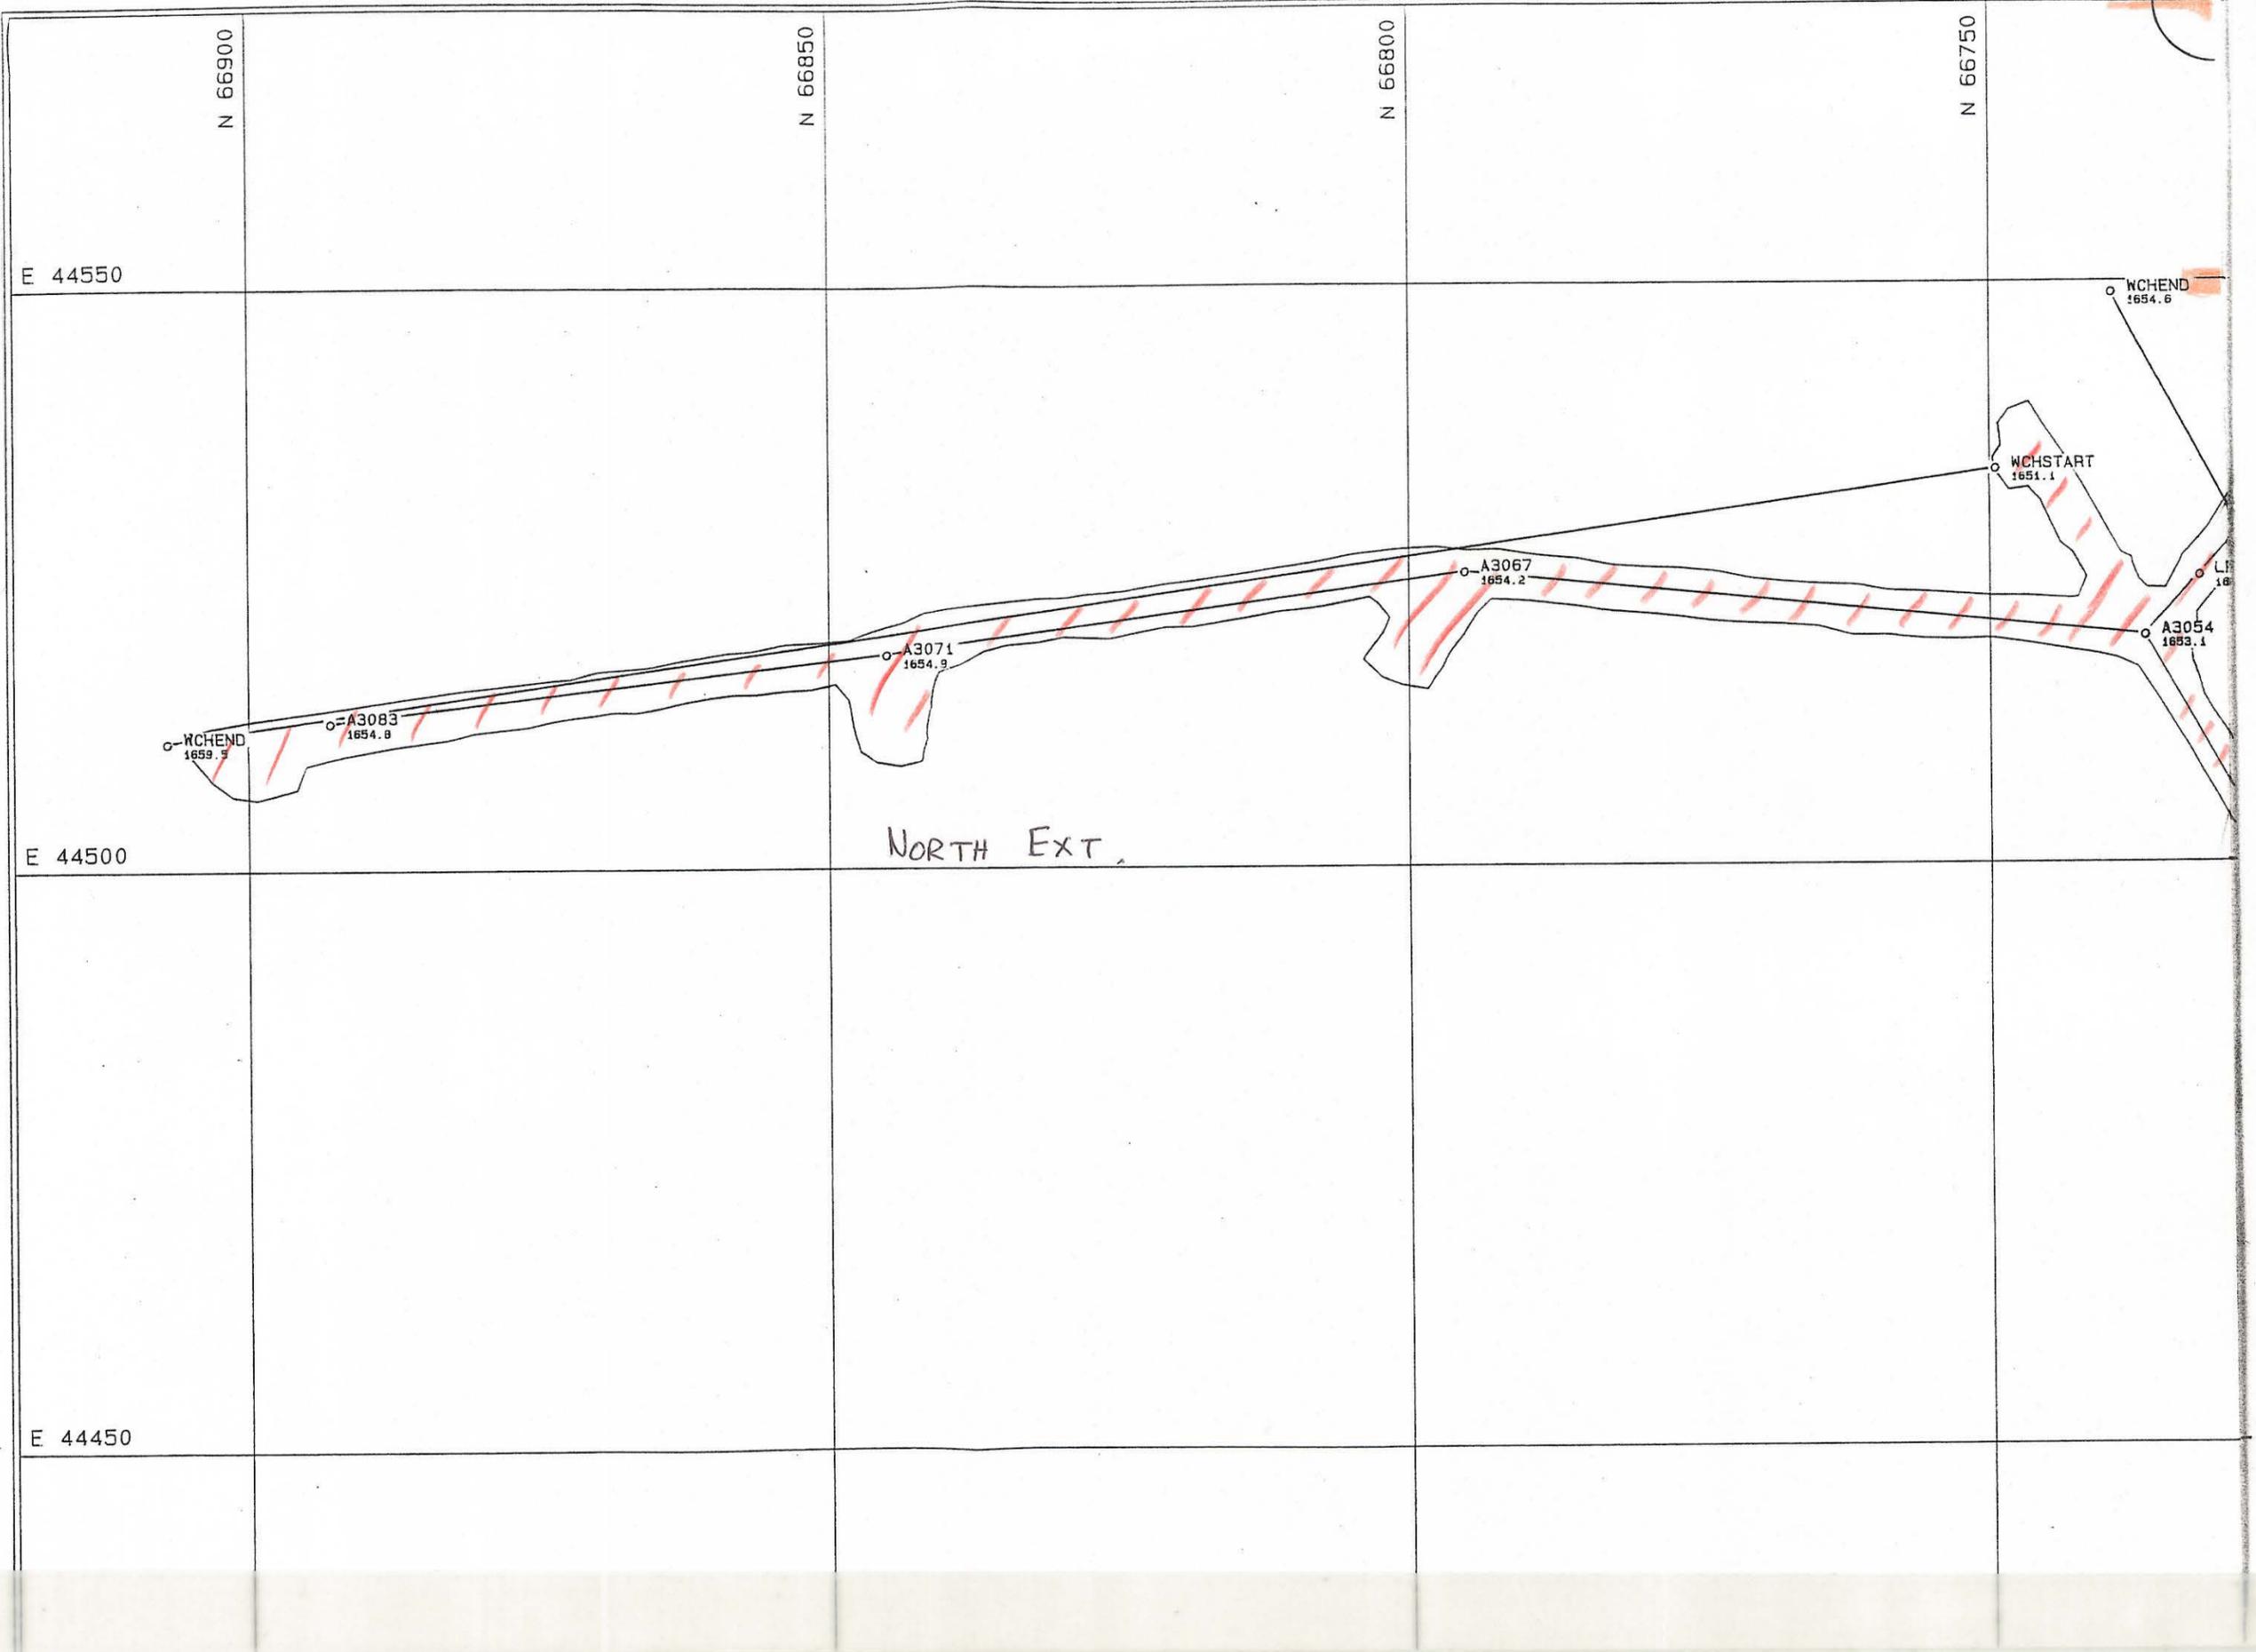

099-676