


0376-102

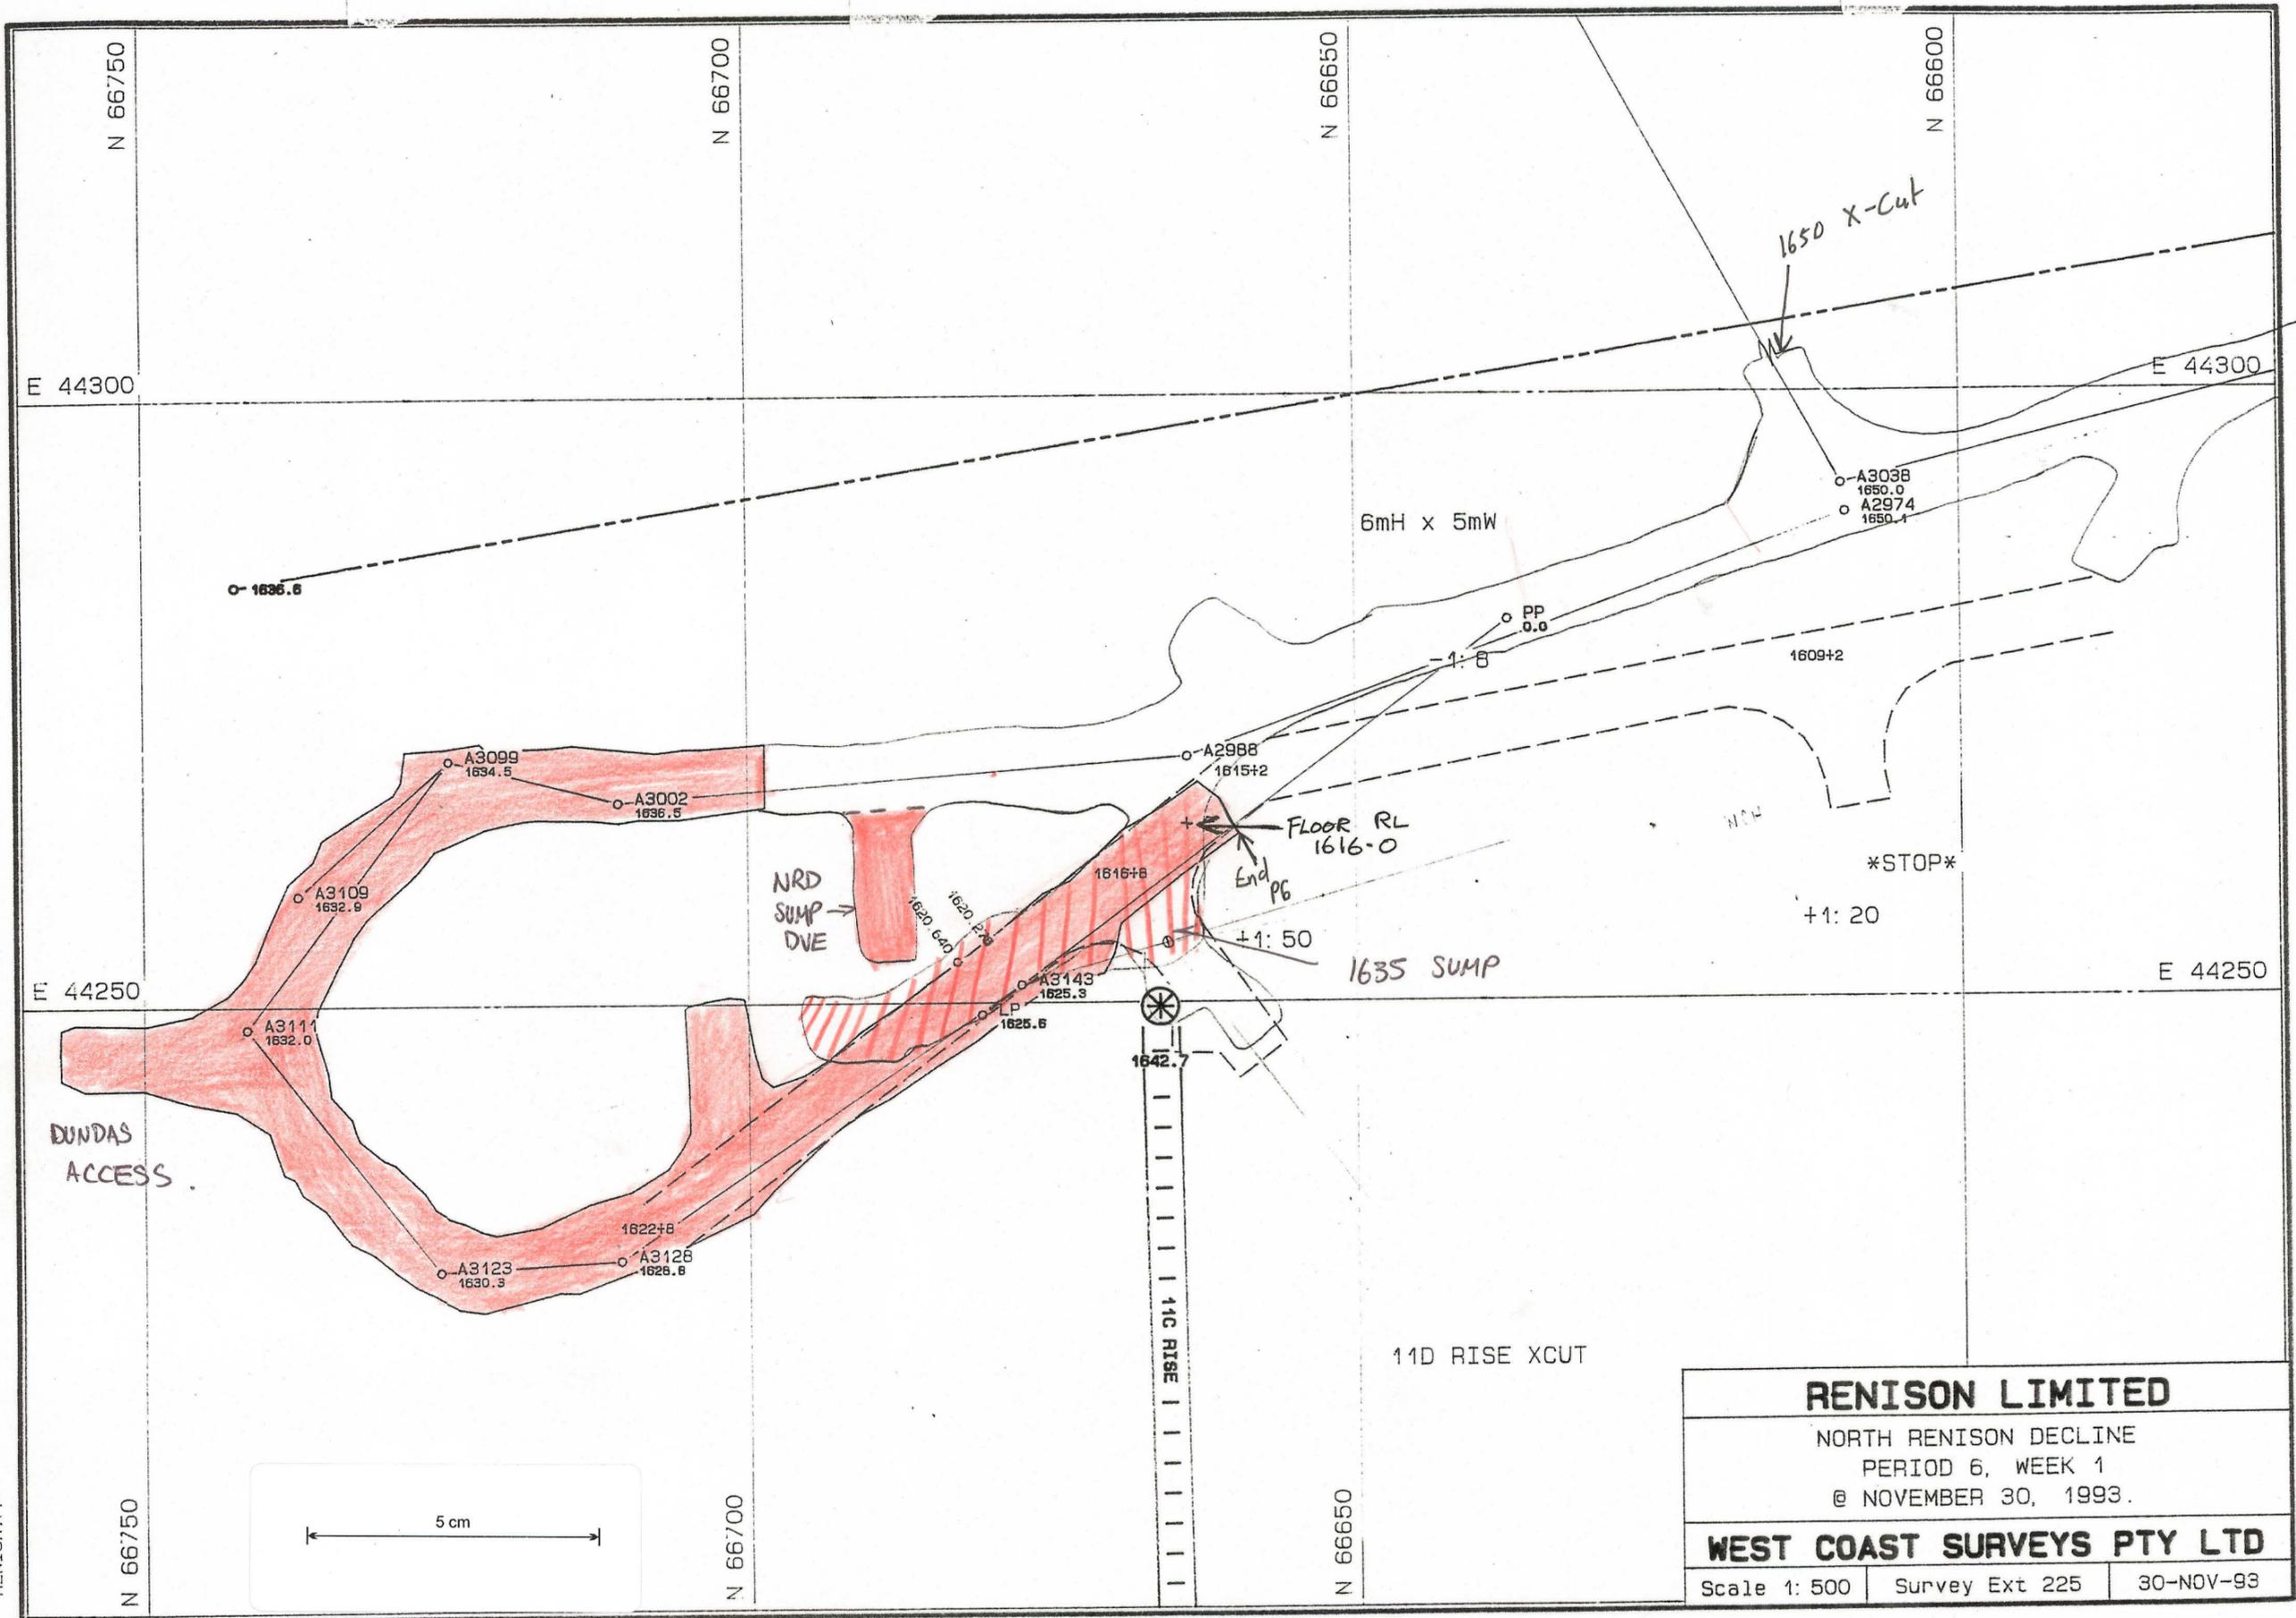

| | | |
|---|----------------|-----------|
| RENISON LIMITED | | |
| NORTH RENISON DECLINE PERIOD 6, WEEK 1 @ NOVEMBER 30, 1993. | | |
| WEST COAST SURVEYS PTY LTD | | |
| Scale 1: 500 | Survey Ext 225 | 30-NOV-93 |

RENISA .PF