


0376-103

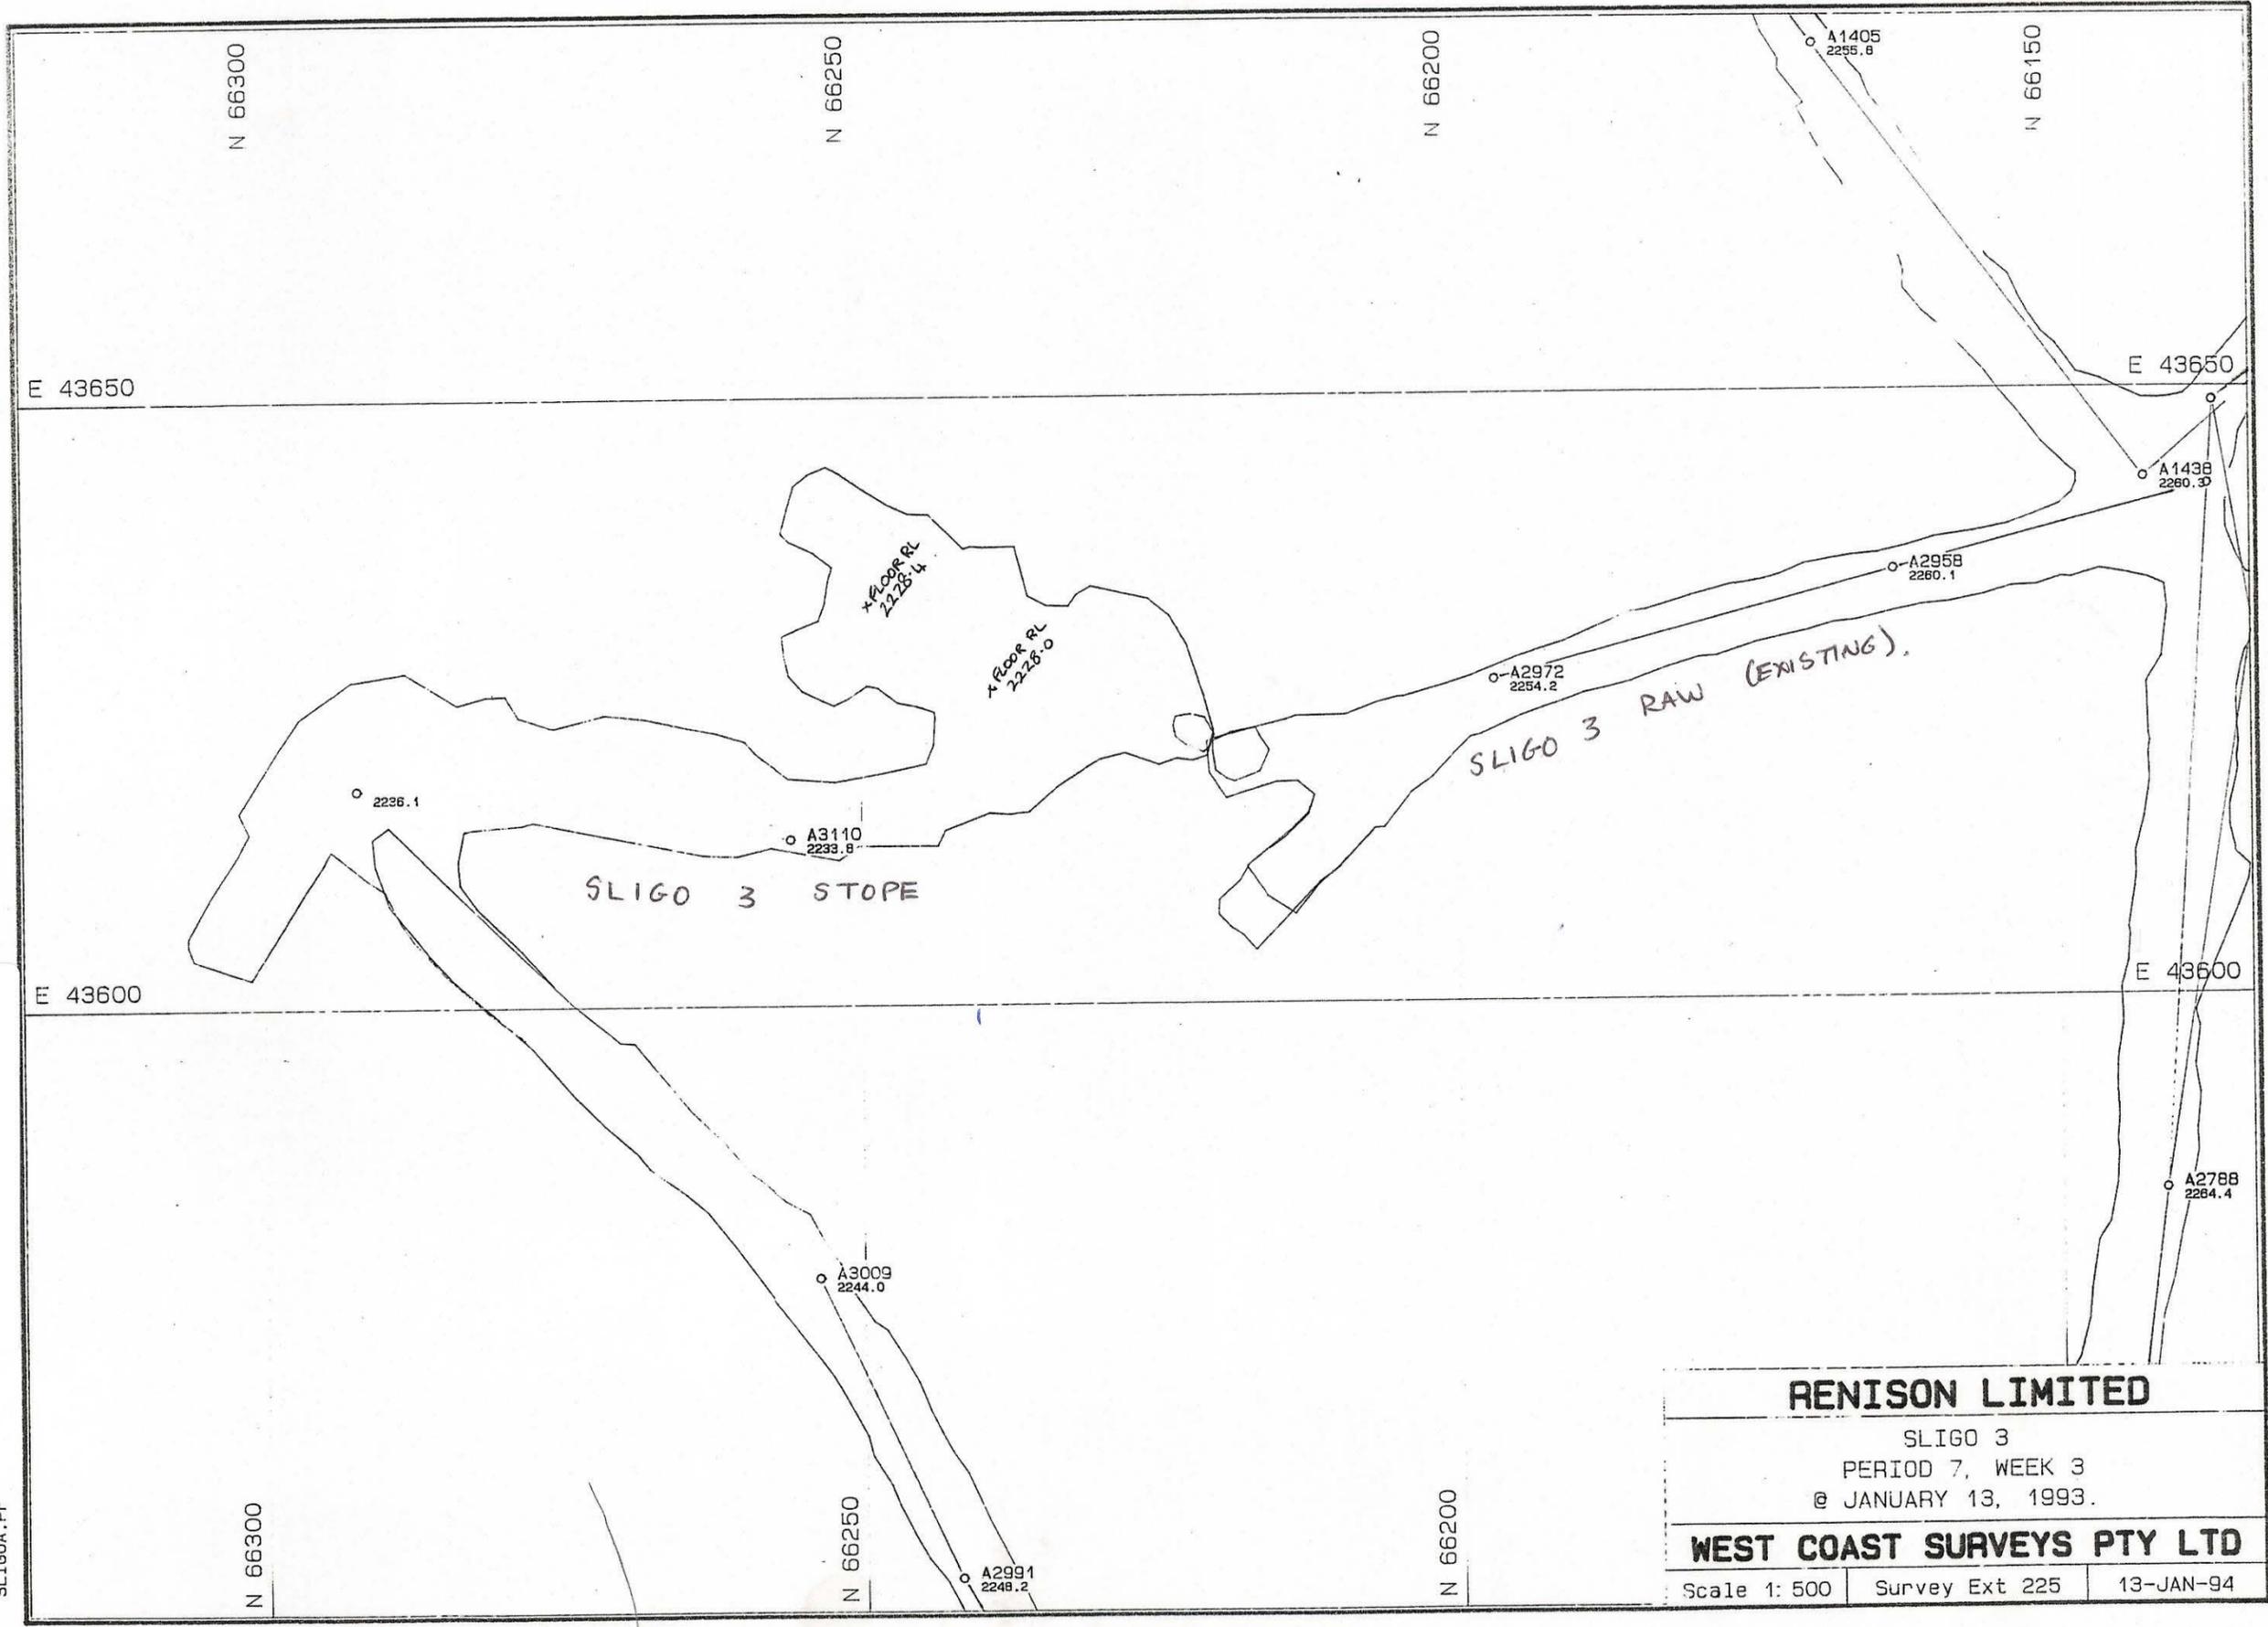

5 cm

RENISON LIMITED		
SLIGO 3		
PERIOD 7, WEEK 3		
@ JANUARY 13, 1993.		
WEST COAST SURVEYS PTY LTD		
Scale 1: 500	Survey Ext 225	13-JAN-94

SLIG0A.PF

26