


0376 - 105

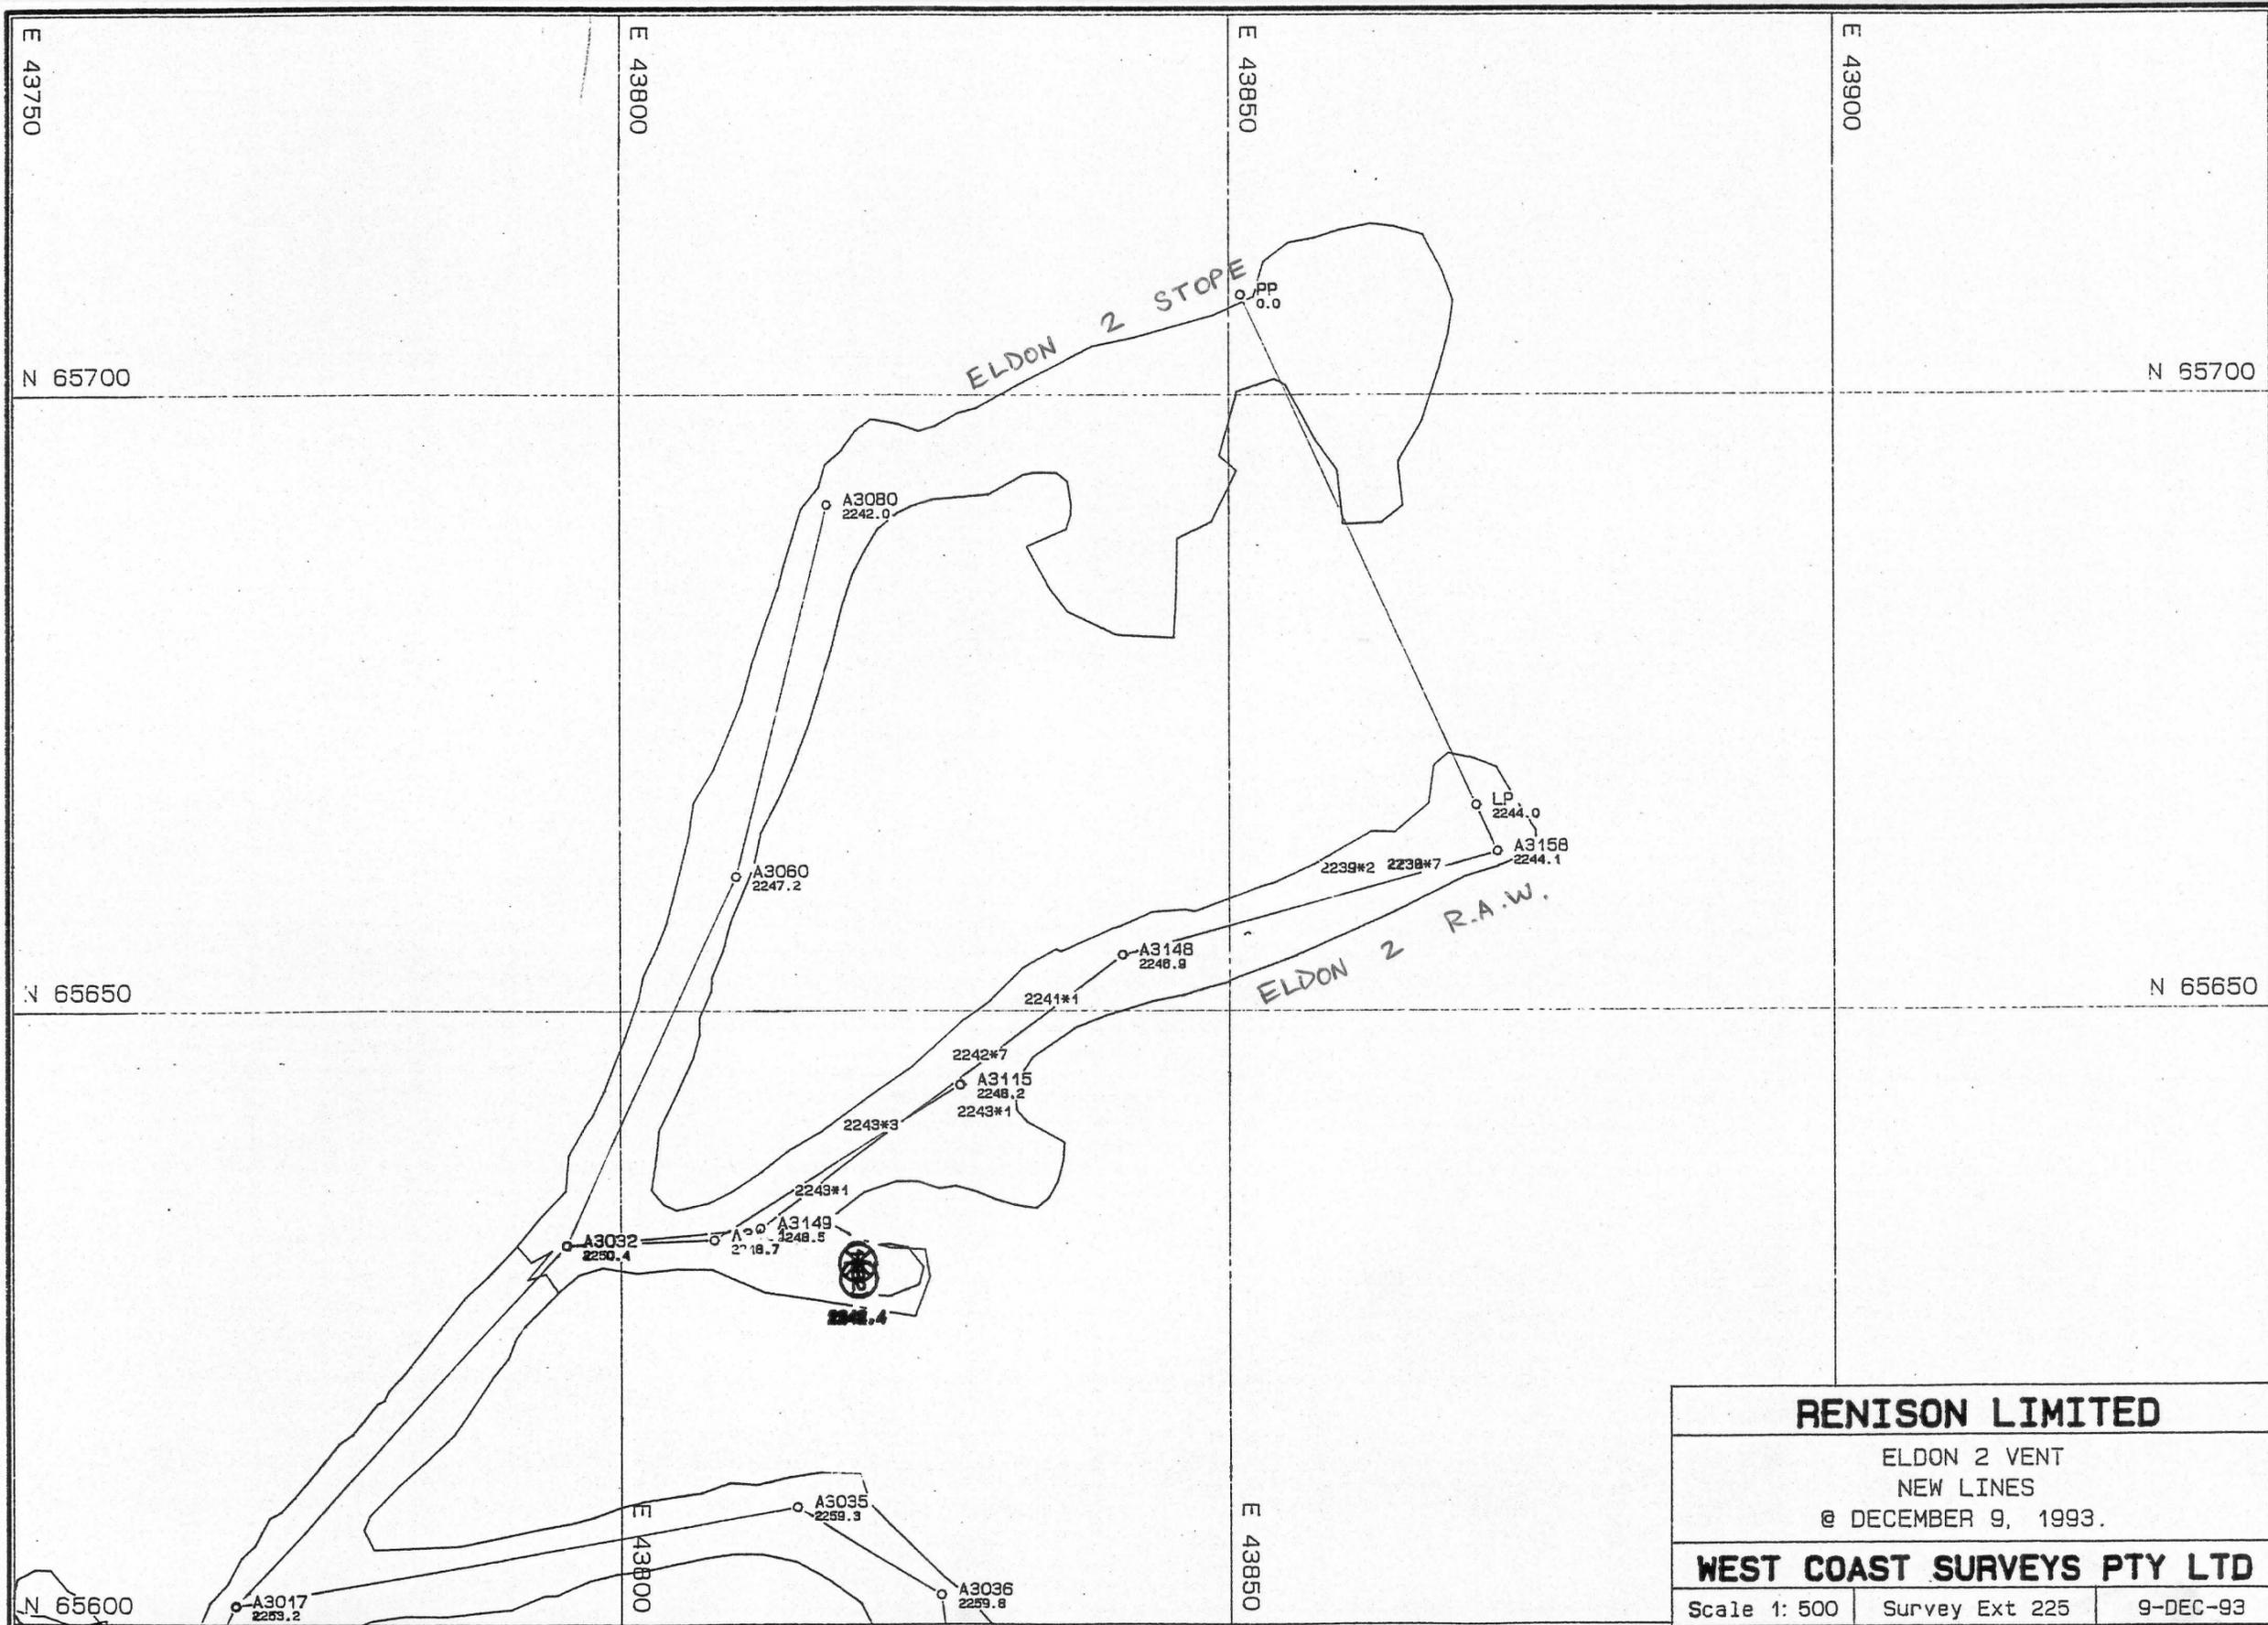

RENISON LIMITED		
ELDON 2 VENT NEW LINES @ DECEMBER 9, 1993.		
WEST COAST SURVEYS PTY LTD		
Scale 1: 500	Survey Ext 225	9-DEC-93

ELDONC.PF