
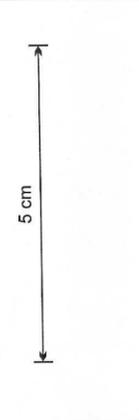


0326-107

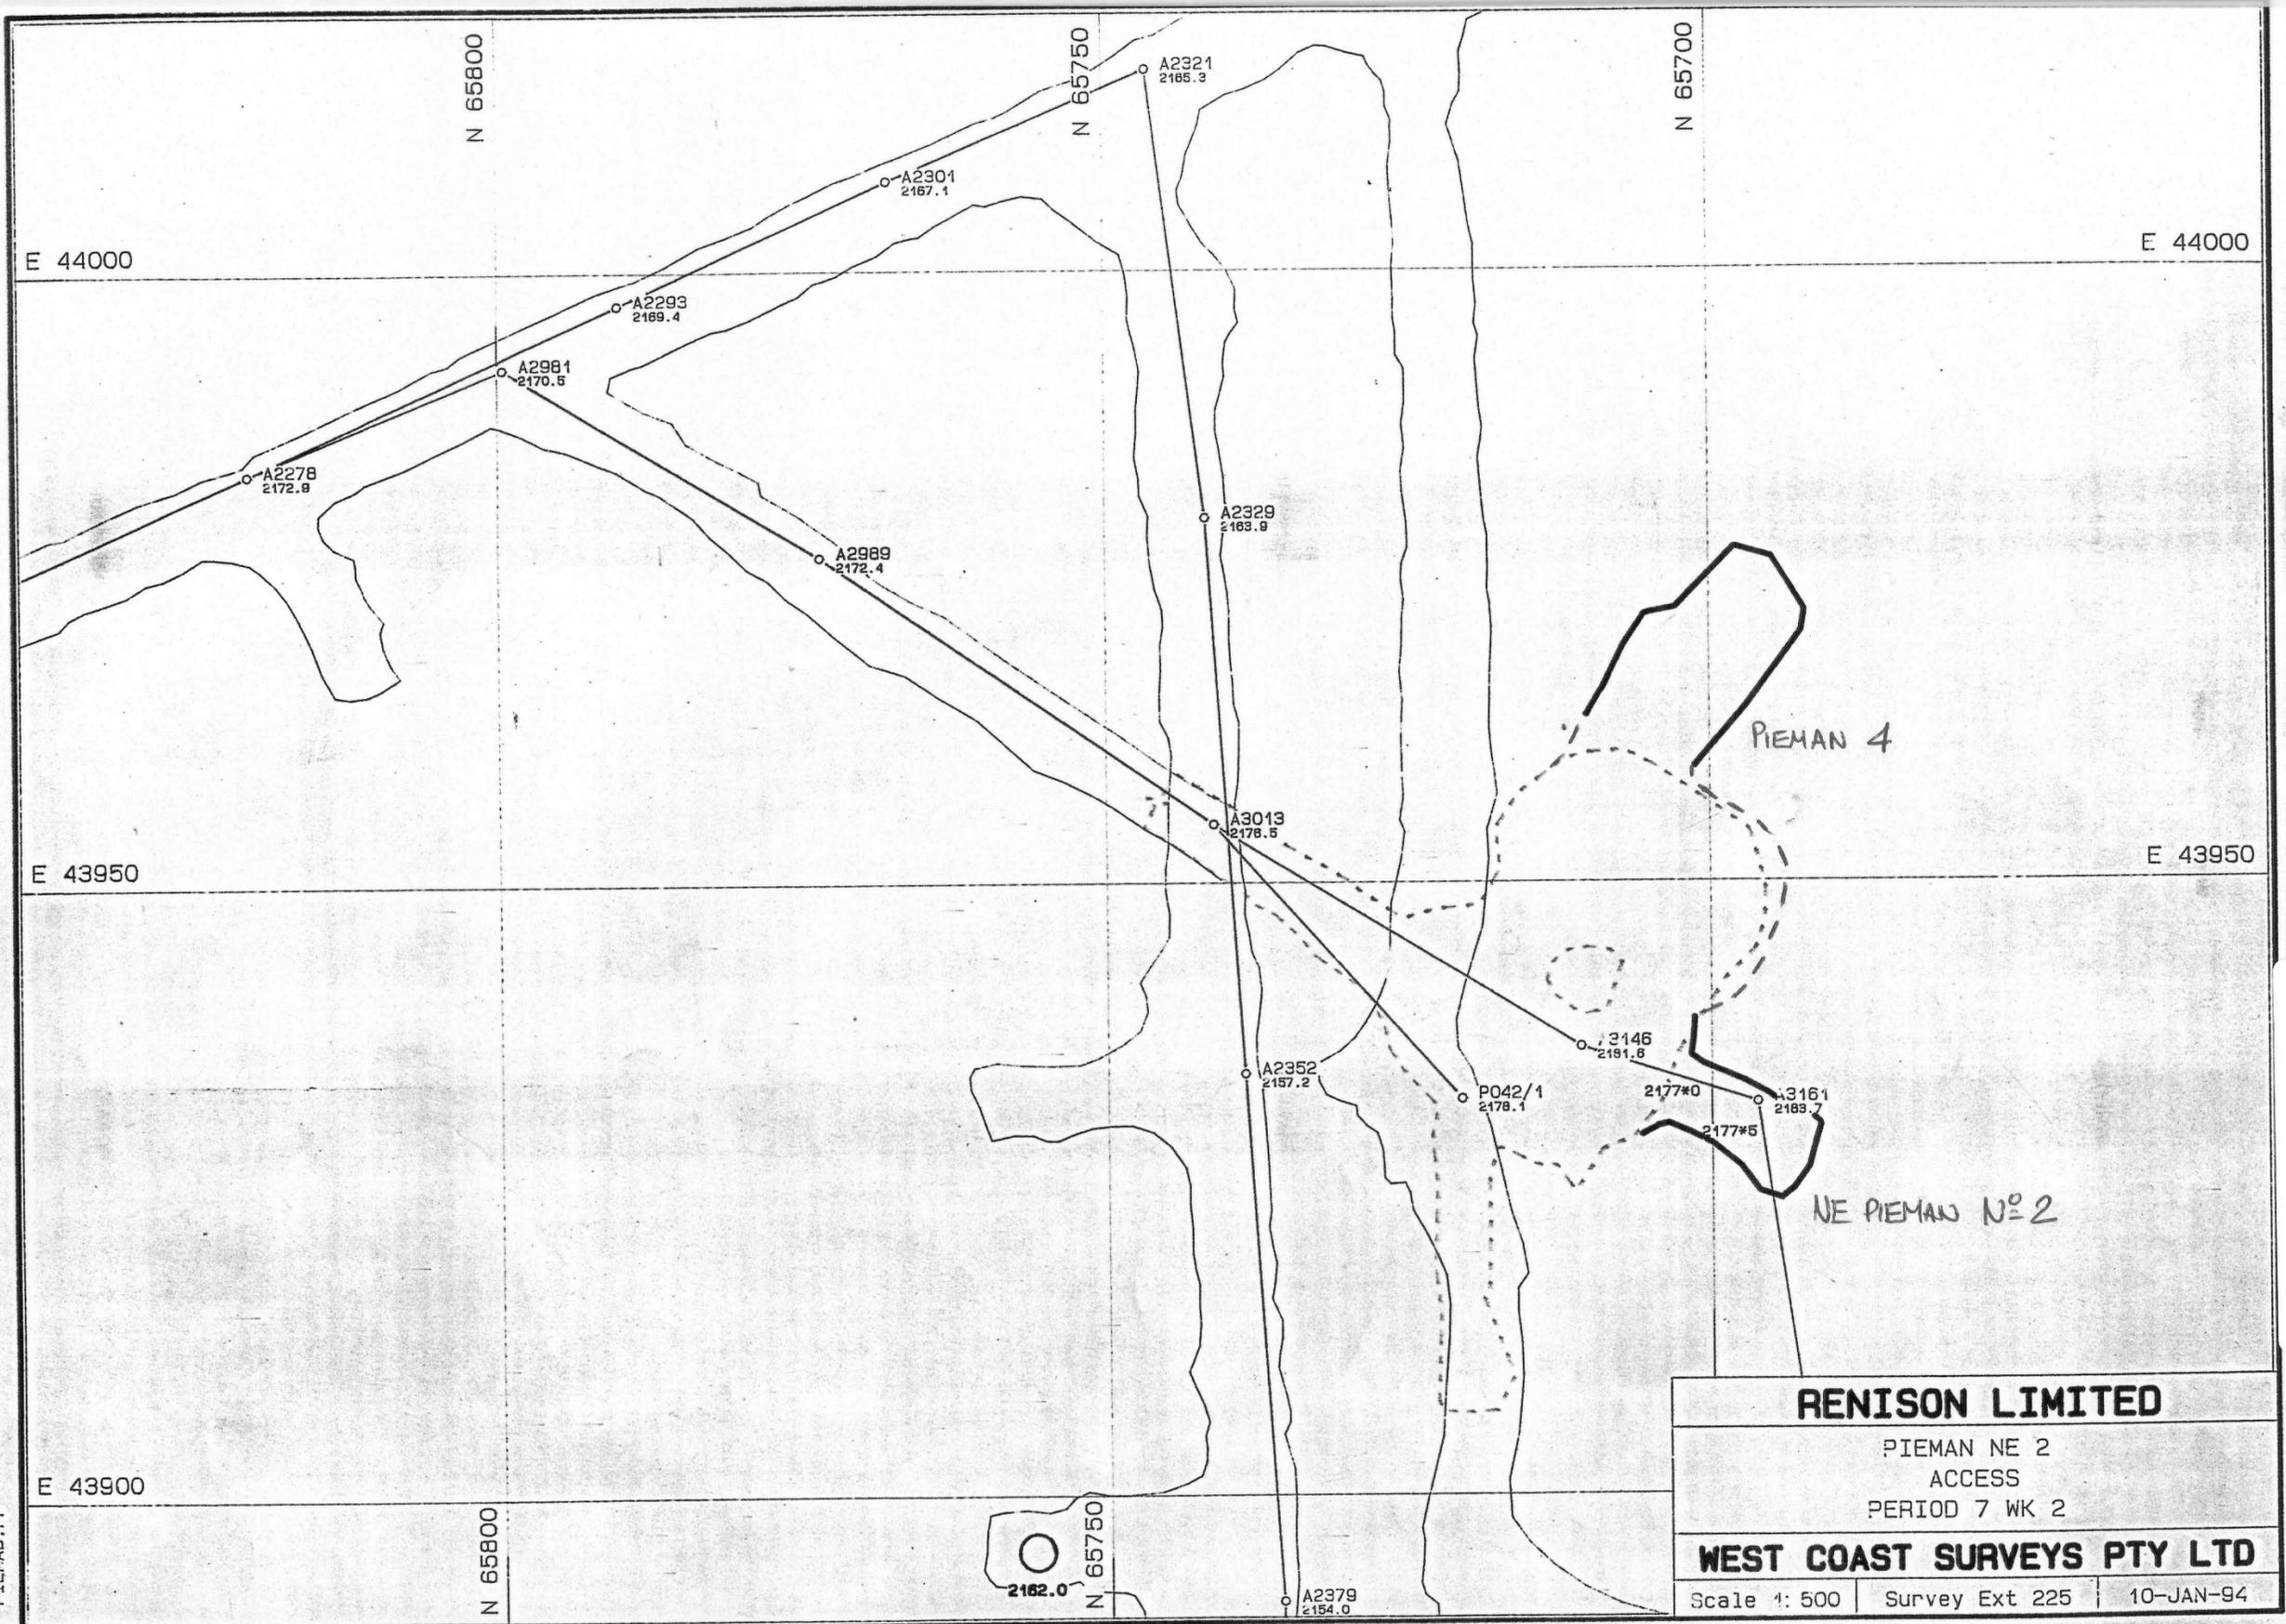

PIEMAN.PF