


0376 - 108

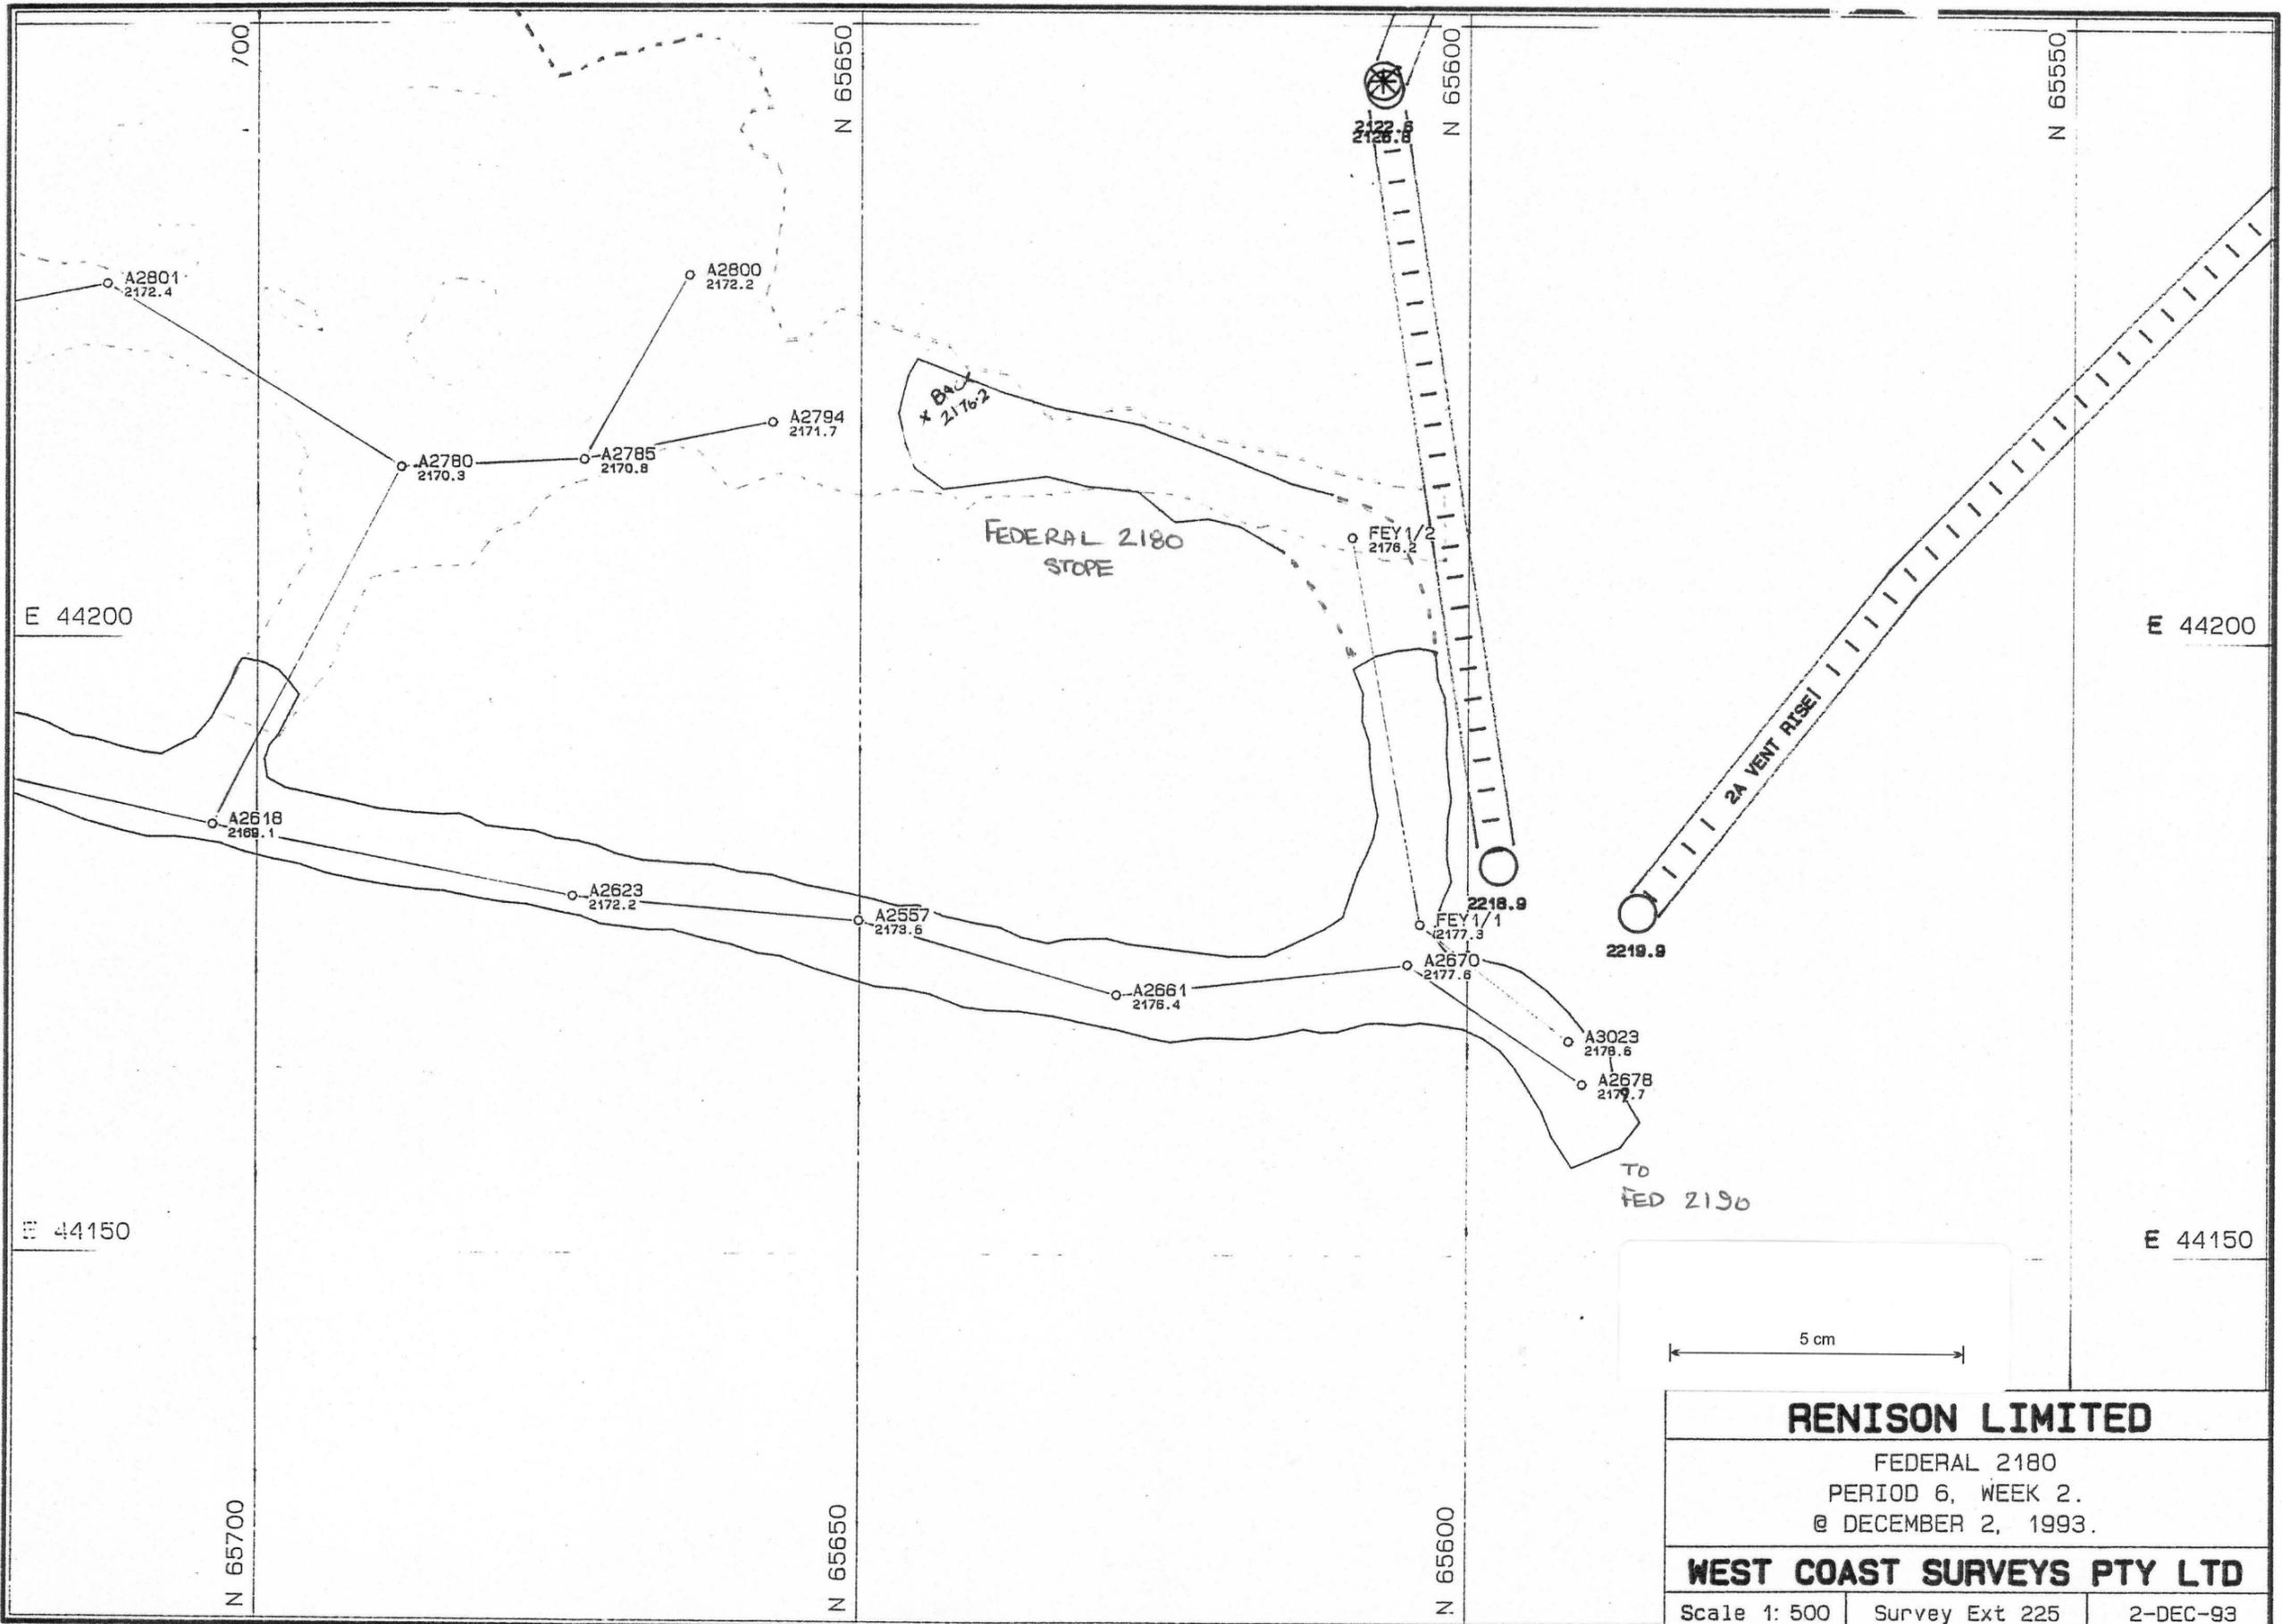

**RENISON LIMITED**

FEDERAL 2180  
PERIOD 6, WEEK 2.  
@ DECEMBER 2, 1993.

**WEST COAST SURVEYS PTY LTD**

Scale 1: 500    Survey Ext 225    2-DEC-93

FED21A.PF