


0376-109

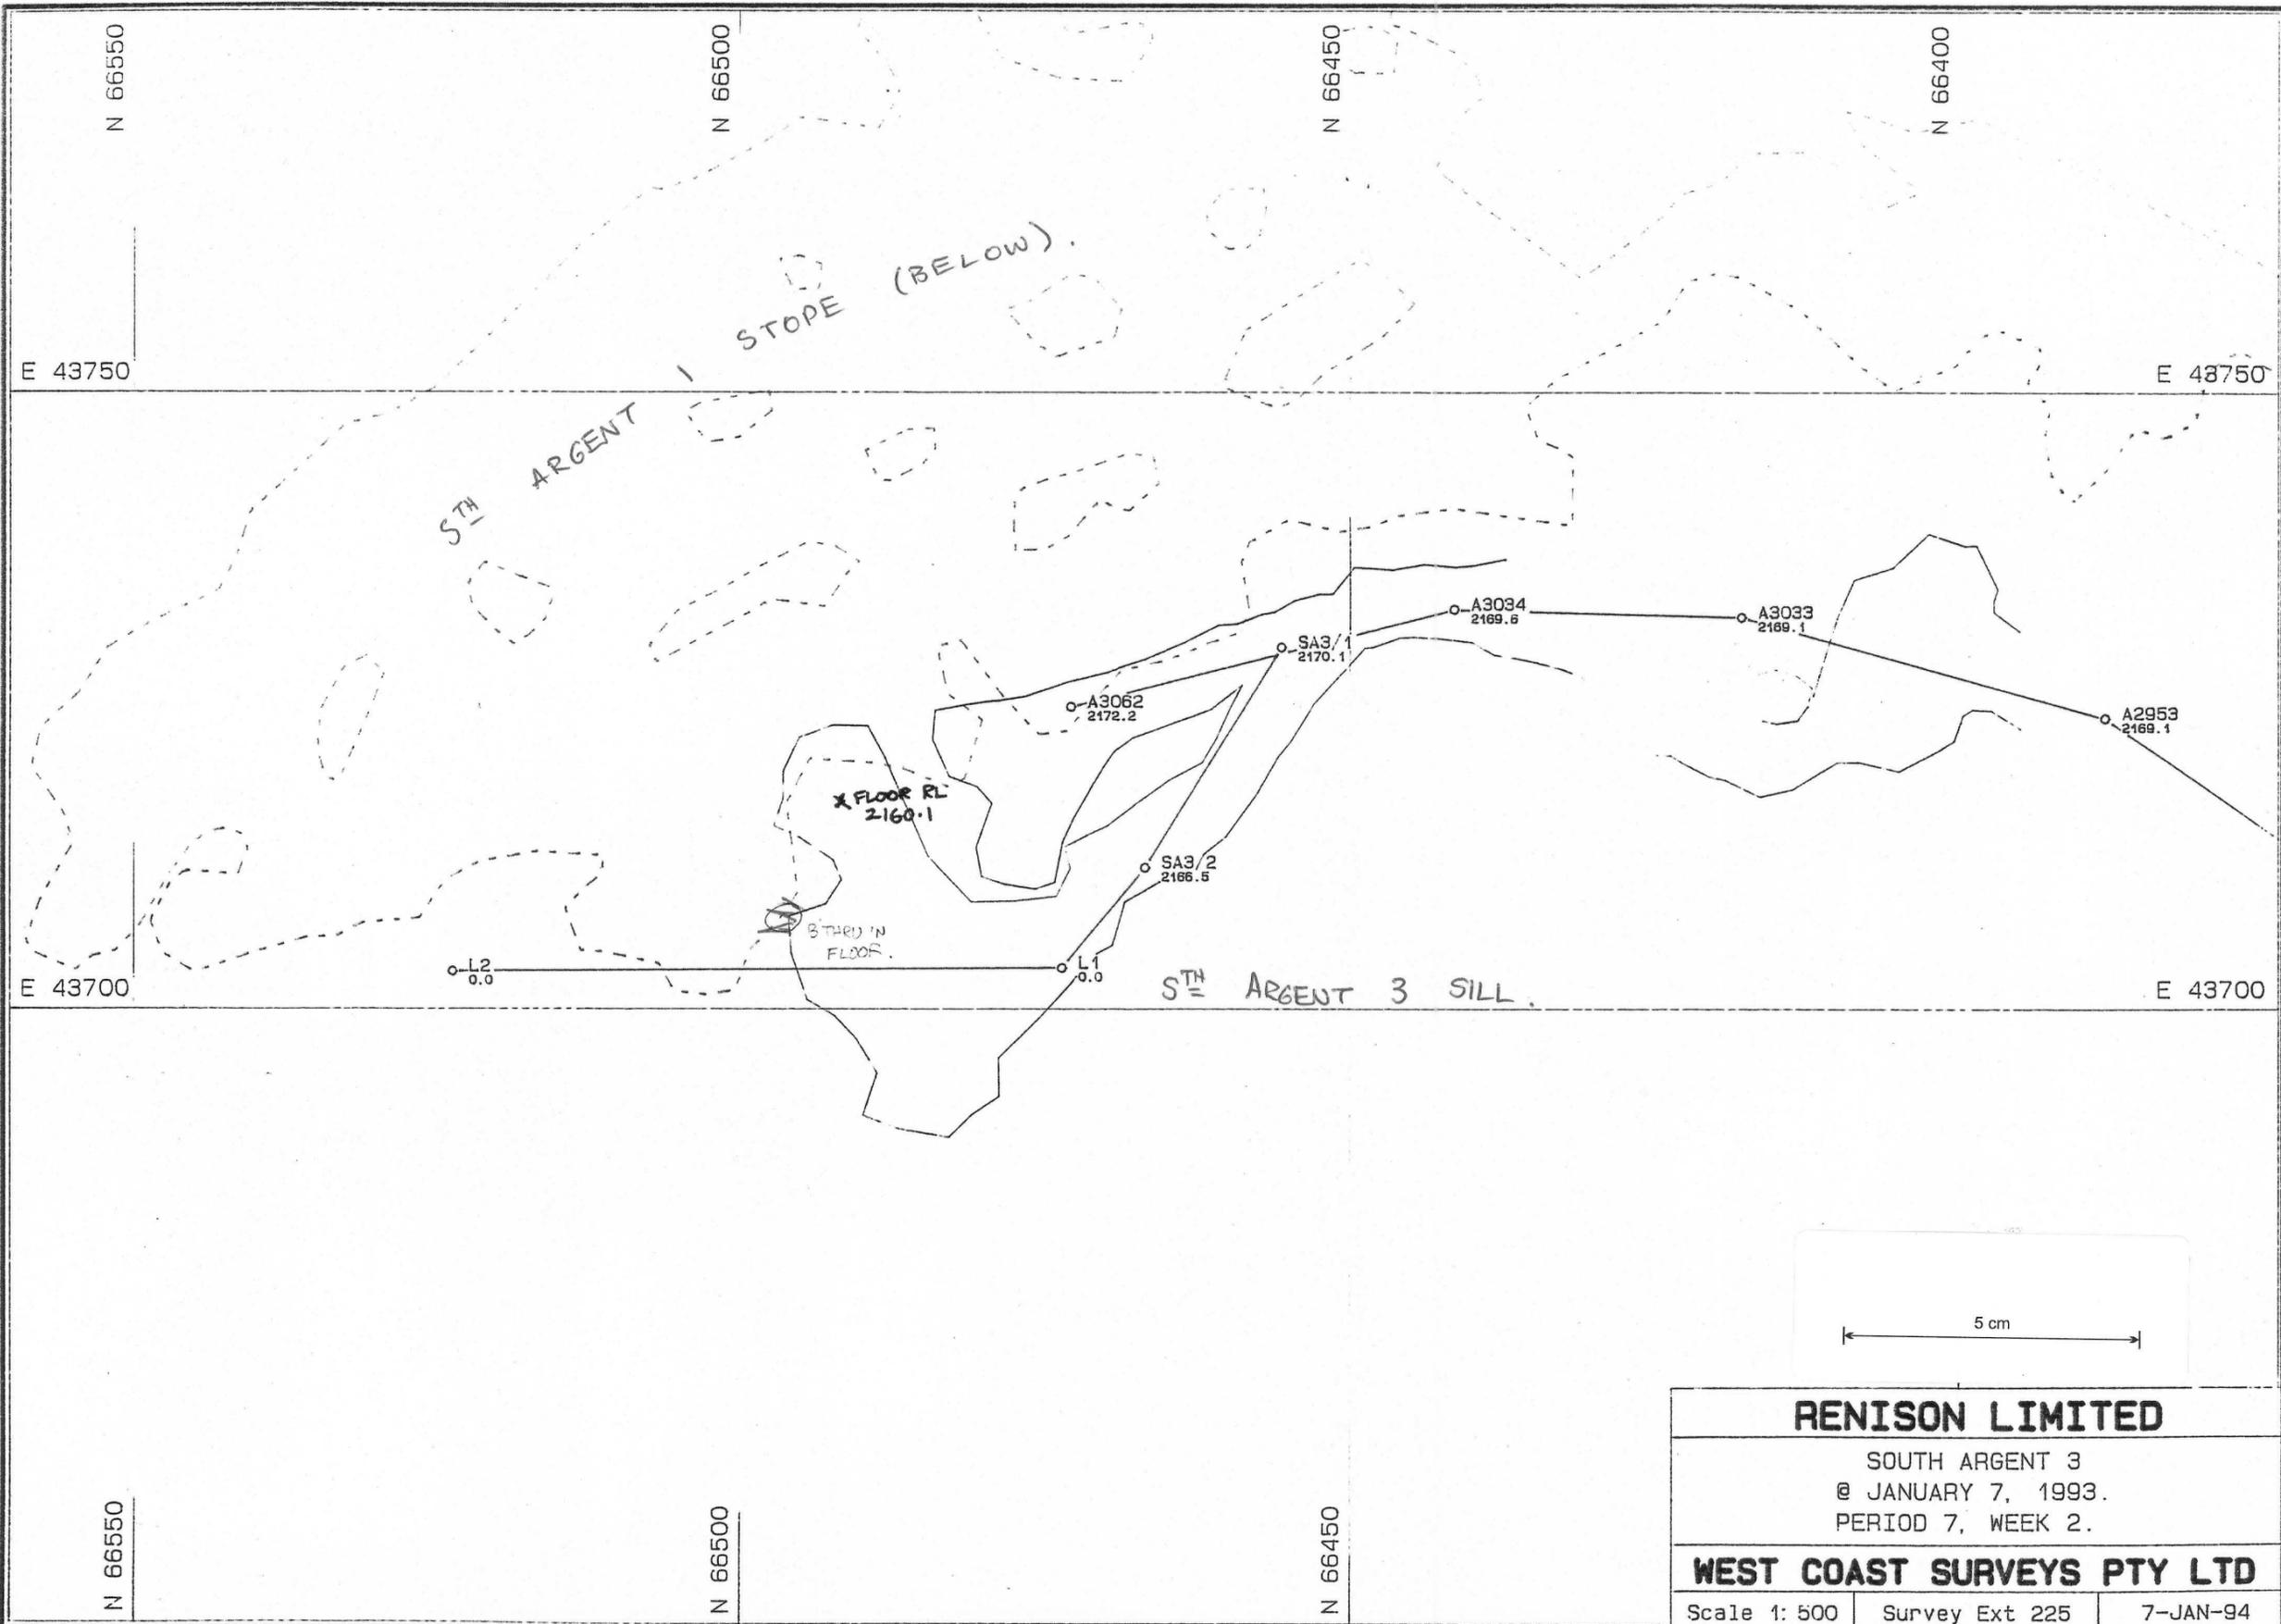

5 cm

<b>RENISON LIMITED</b>		
SOUTH ARGENT 3 @ JANUARY 7, 1993. PERIOD 7, WEEK 2.		
<b>WEST COAST SURVEYS PTY LTD</b>		
Scale 1: 500	Survey Ext 225	7-JAN-94

SOUTH.A.PF