


0376 - 110

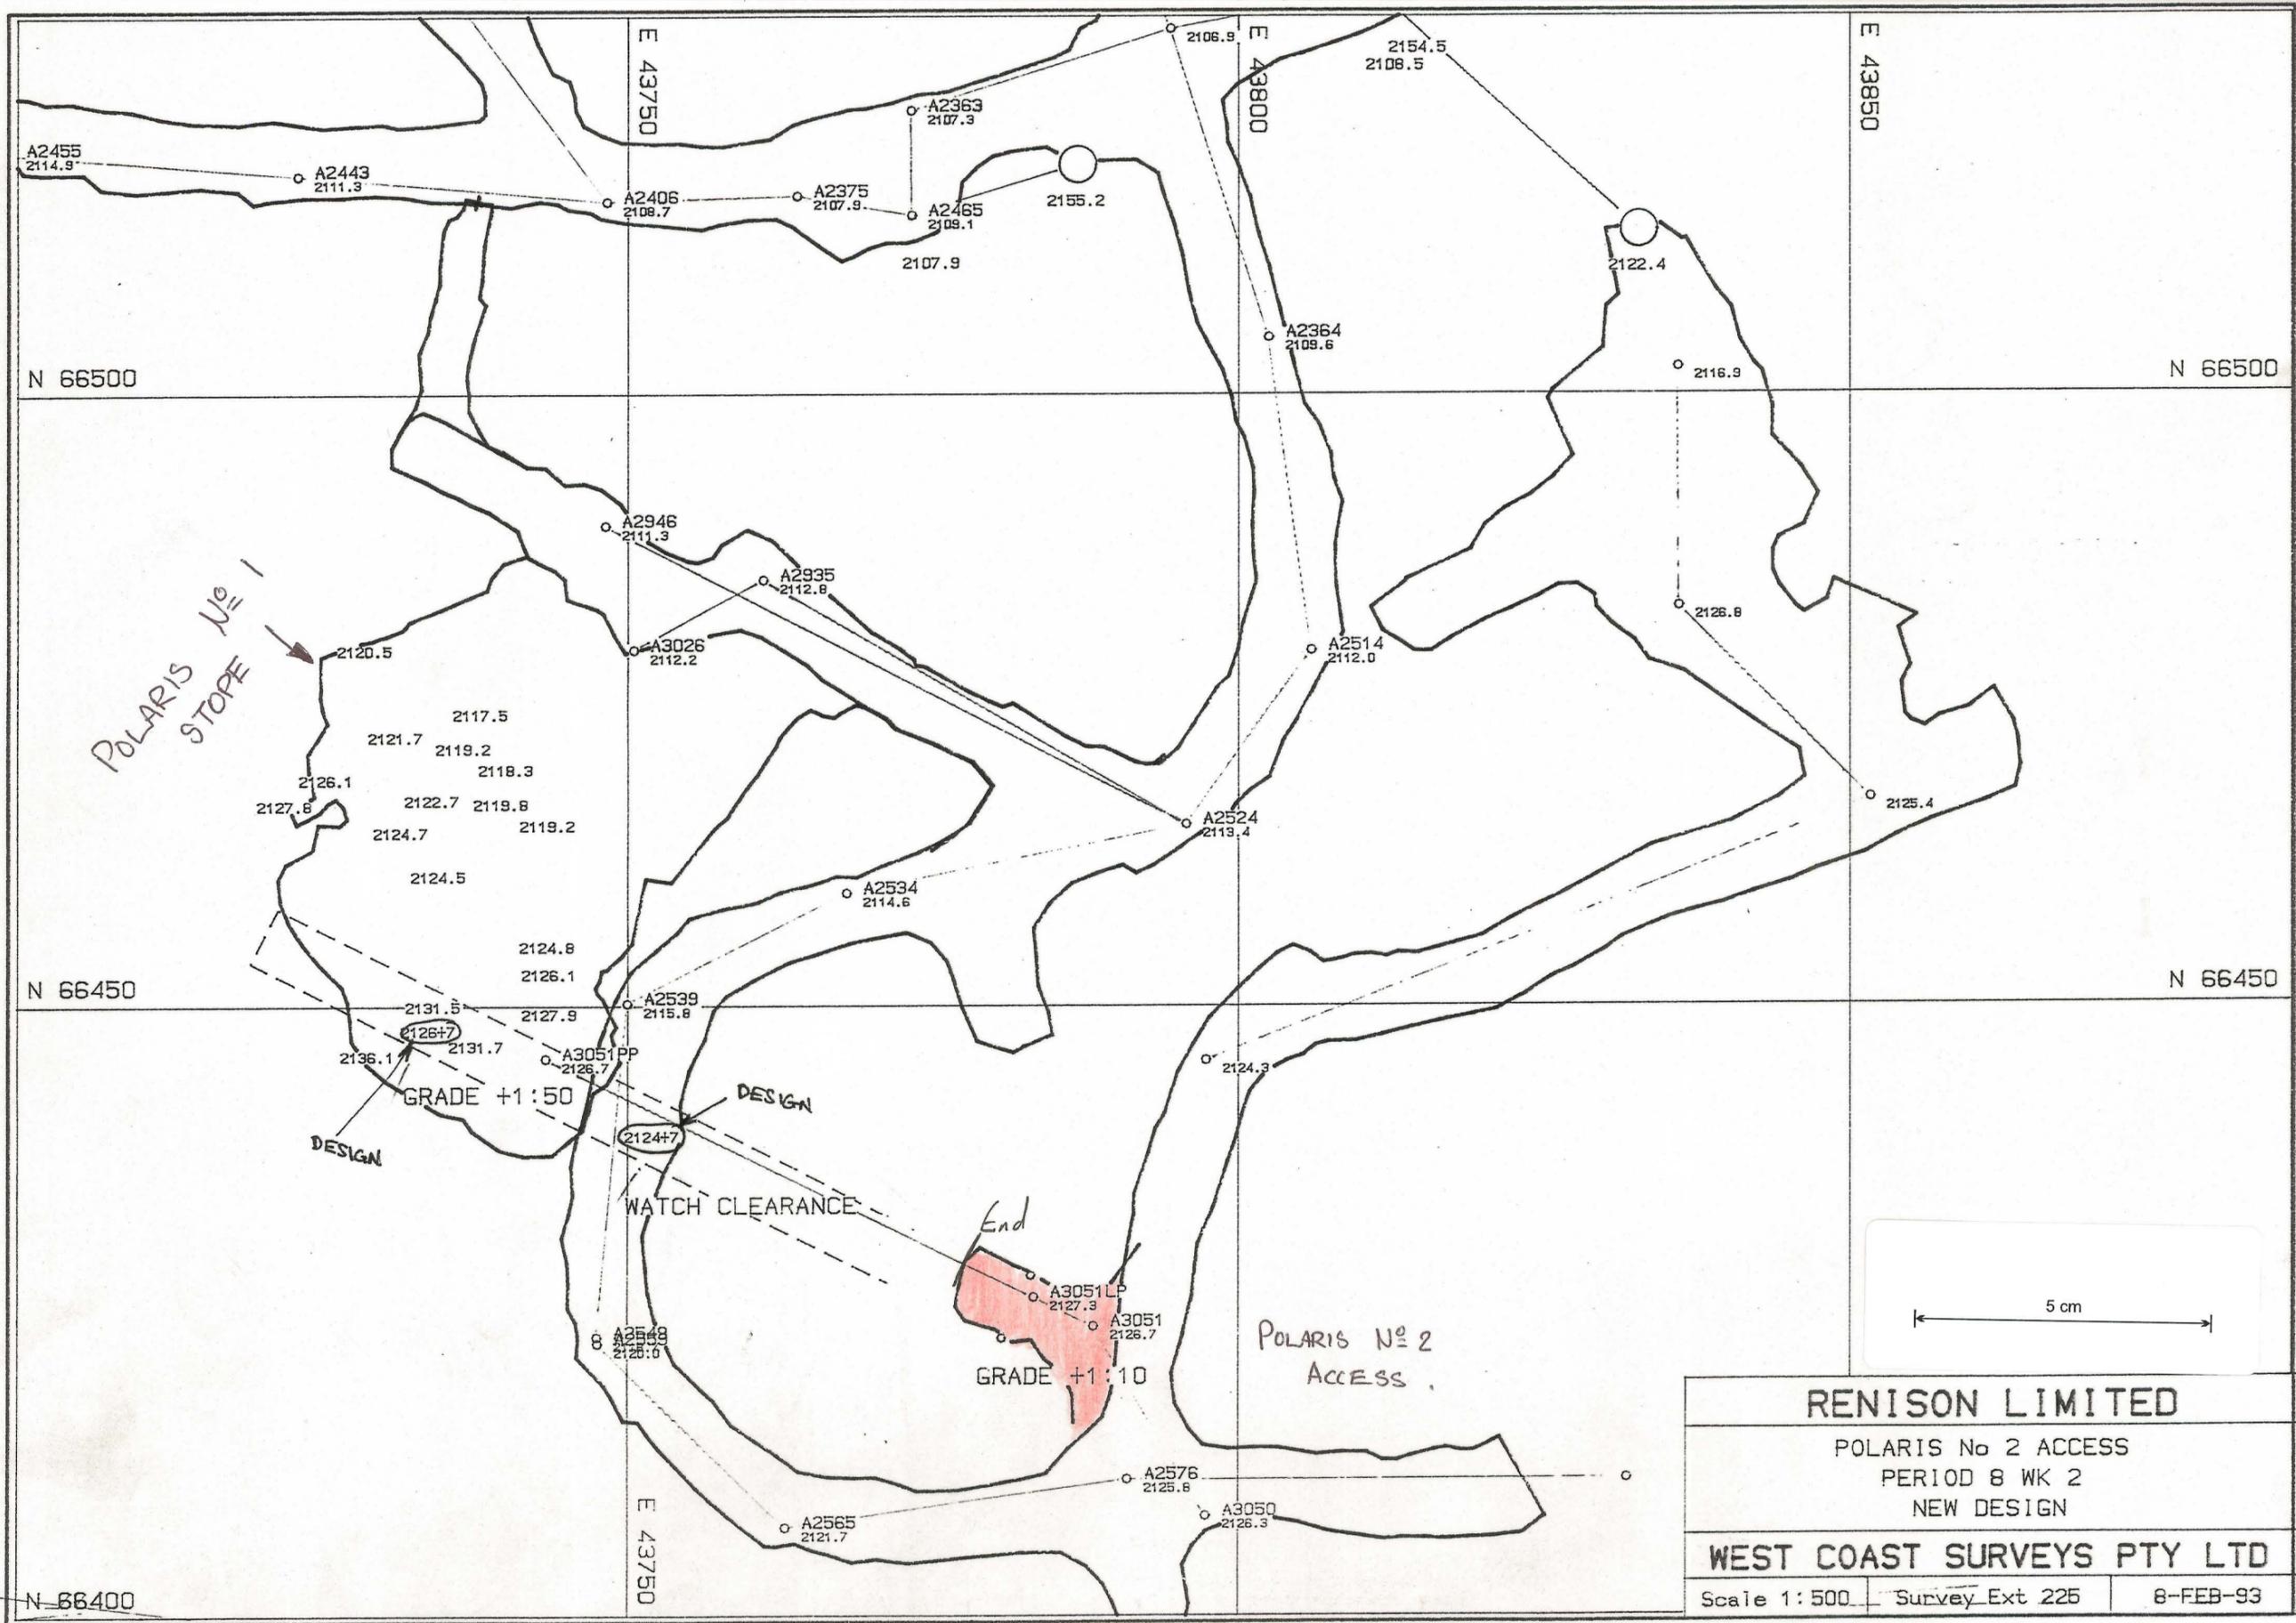

| | | |
|-----------------------------------|----------------|----------|
| RENISON LIMITED | | |
| POLARIS No 2 ACCESS | | |
| PERIOD 8 WK 2 | | |
| NEW DESIGN | | |
| WEST COAST SURVEYS PTY LTD | | |
| Scale 1:500 | Survey Ext 225 | 8-FEB-93 |

POLARB.PF