


0376 - 112

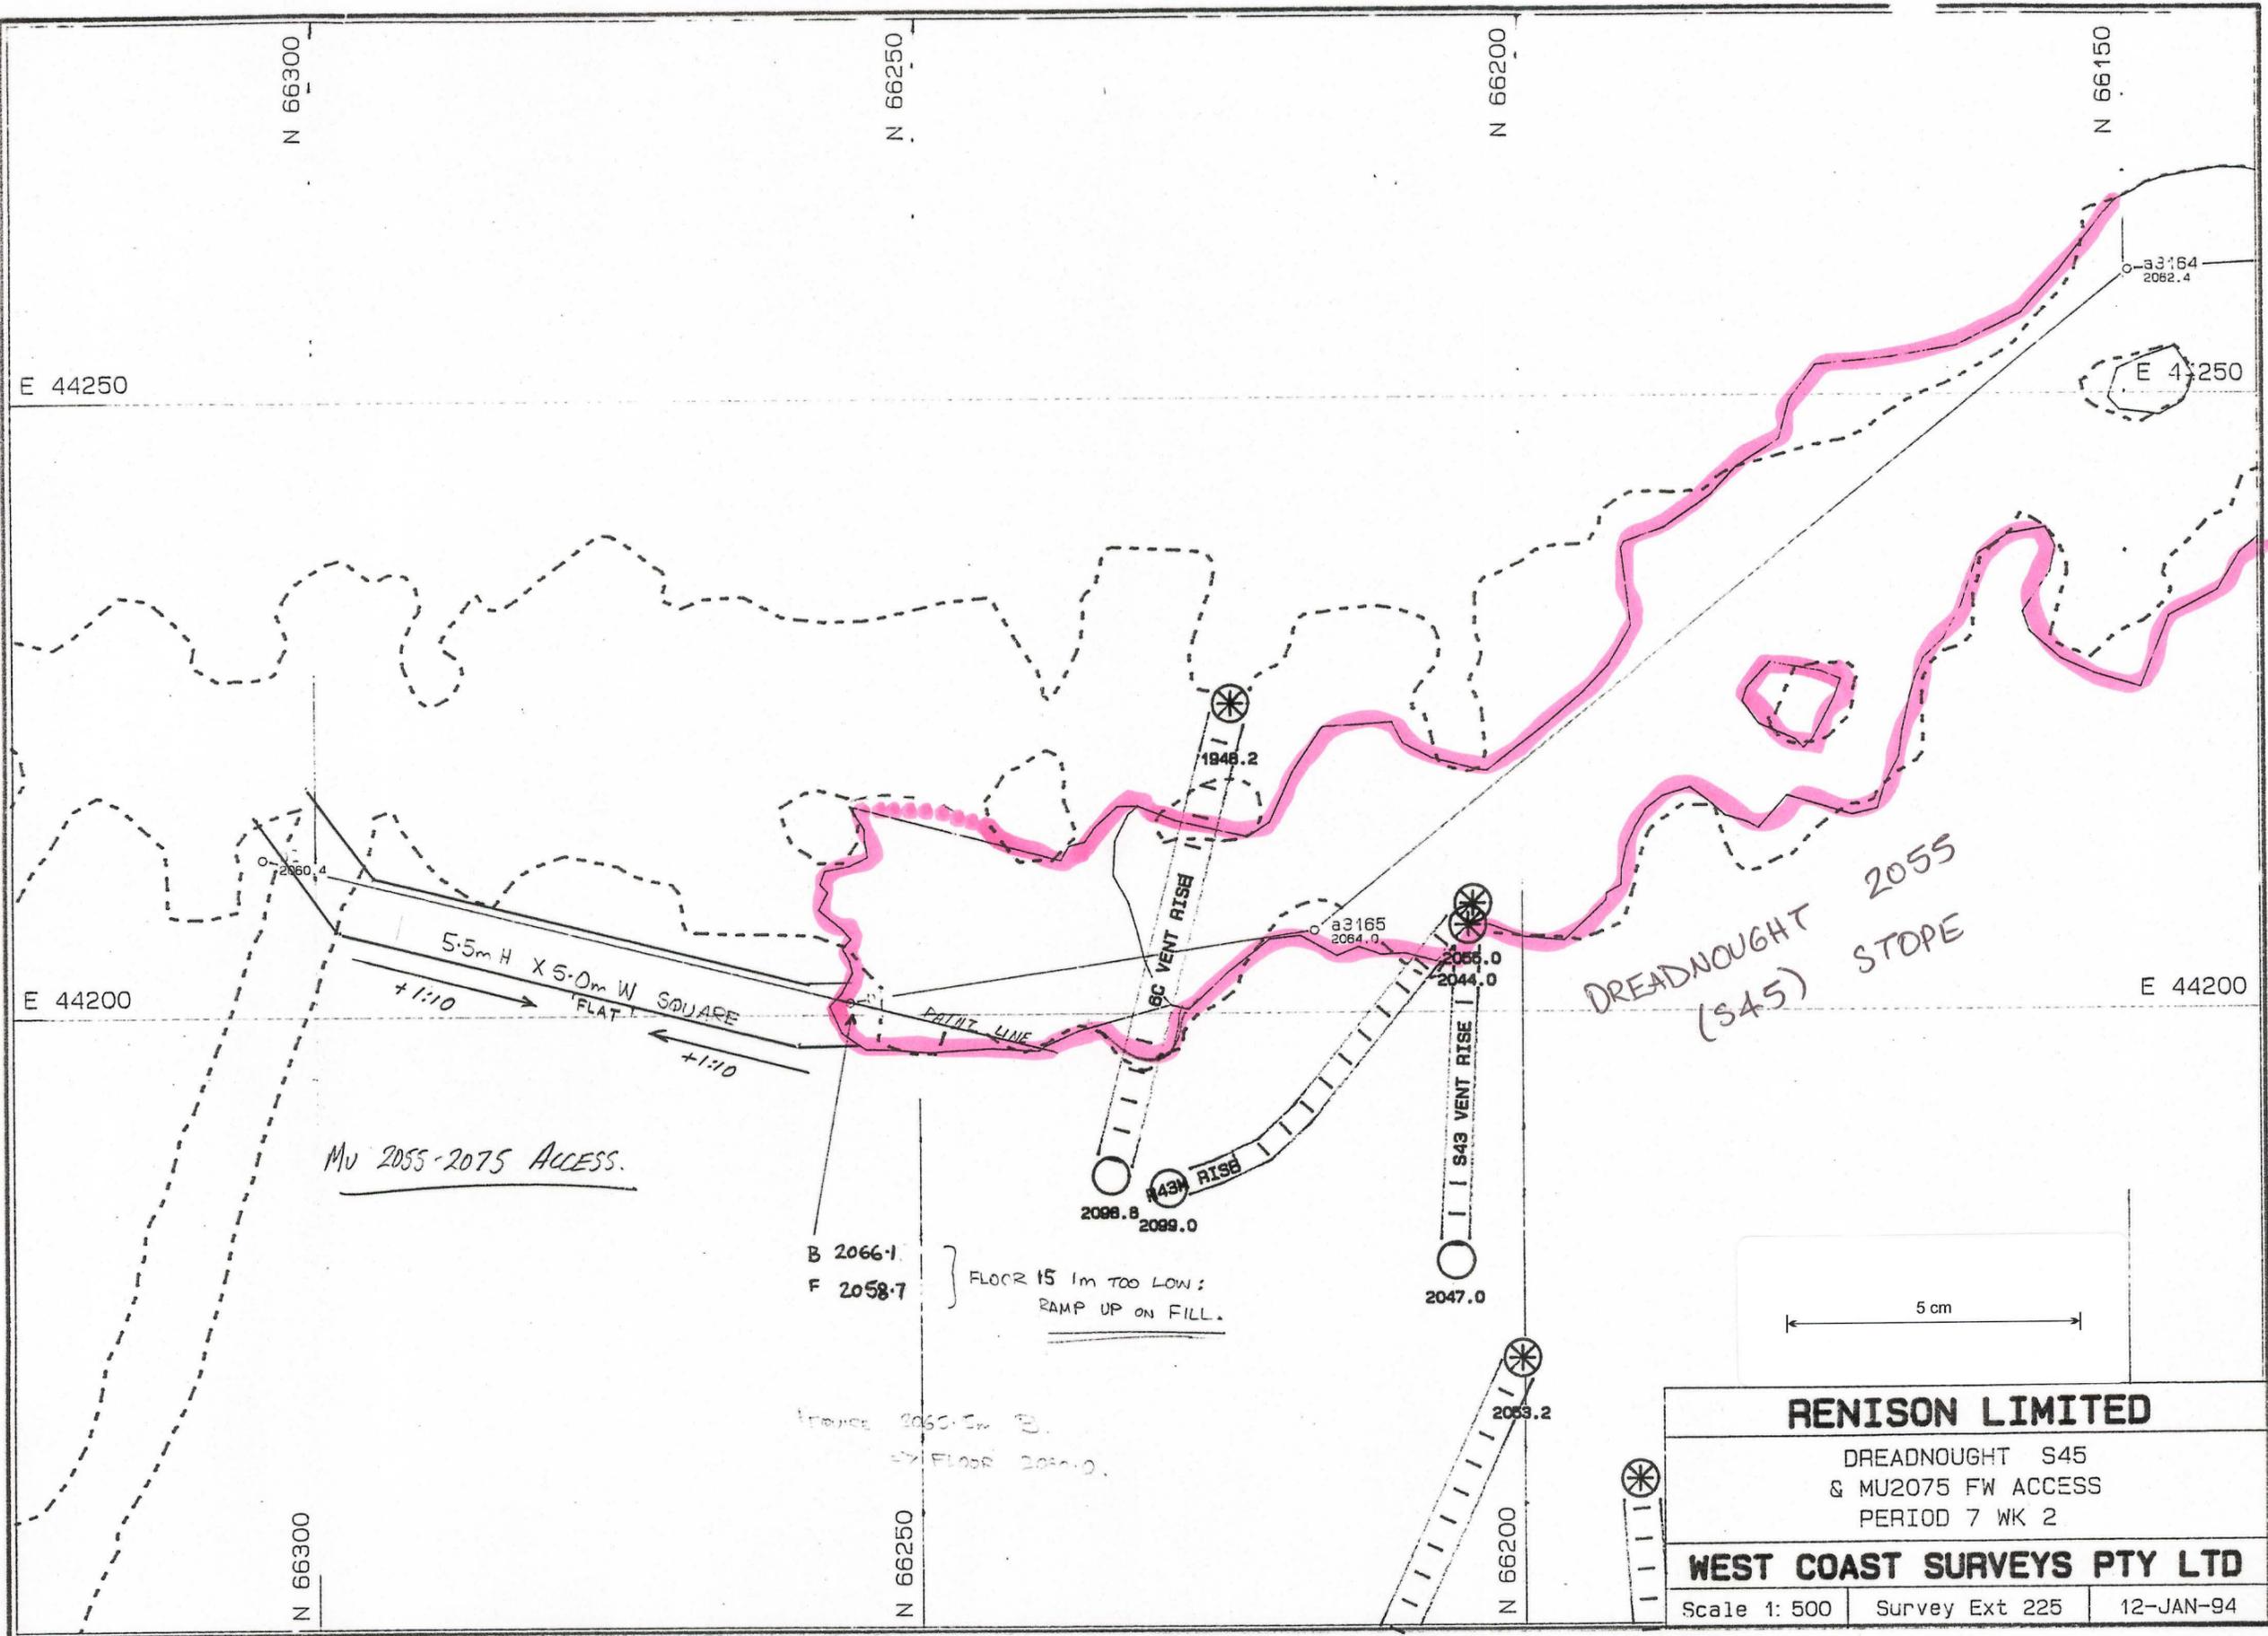

MU 2055-2075 ACCESS.

B 2066.1
F 2058.7 } FLOOR 15 1m TOO LOW:
RAMP UP ON FILL.

RENISON LIMITED

DREADNOUGHT S45
& MU2075 FW ACCESS
PERIOD 7 WK 2

WEST COAST SURVEYS PTY LTD

Scale 1: 500 | Survey Ext 225 | 12-JAN-94

DREADD.PF