


0376-113

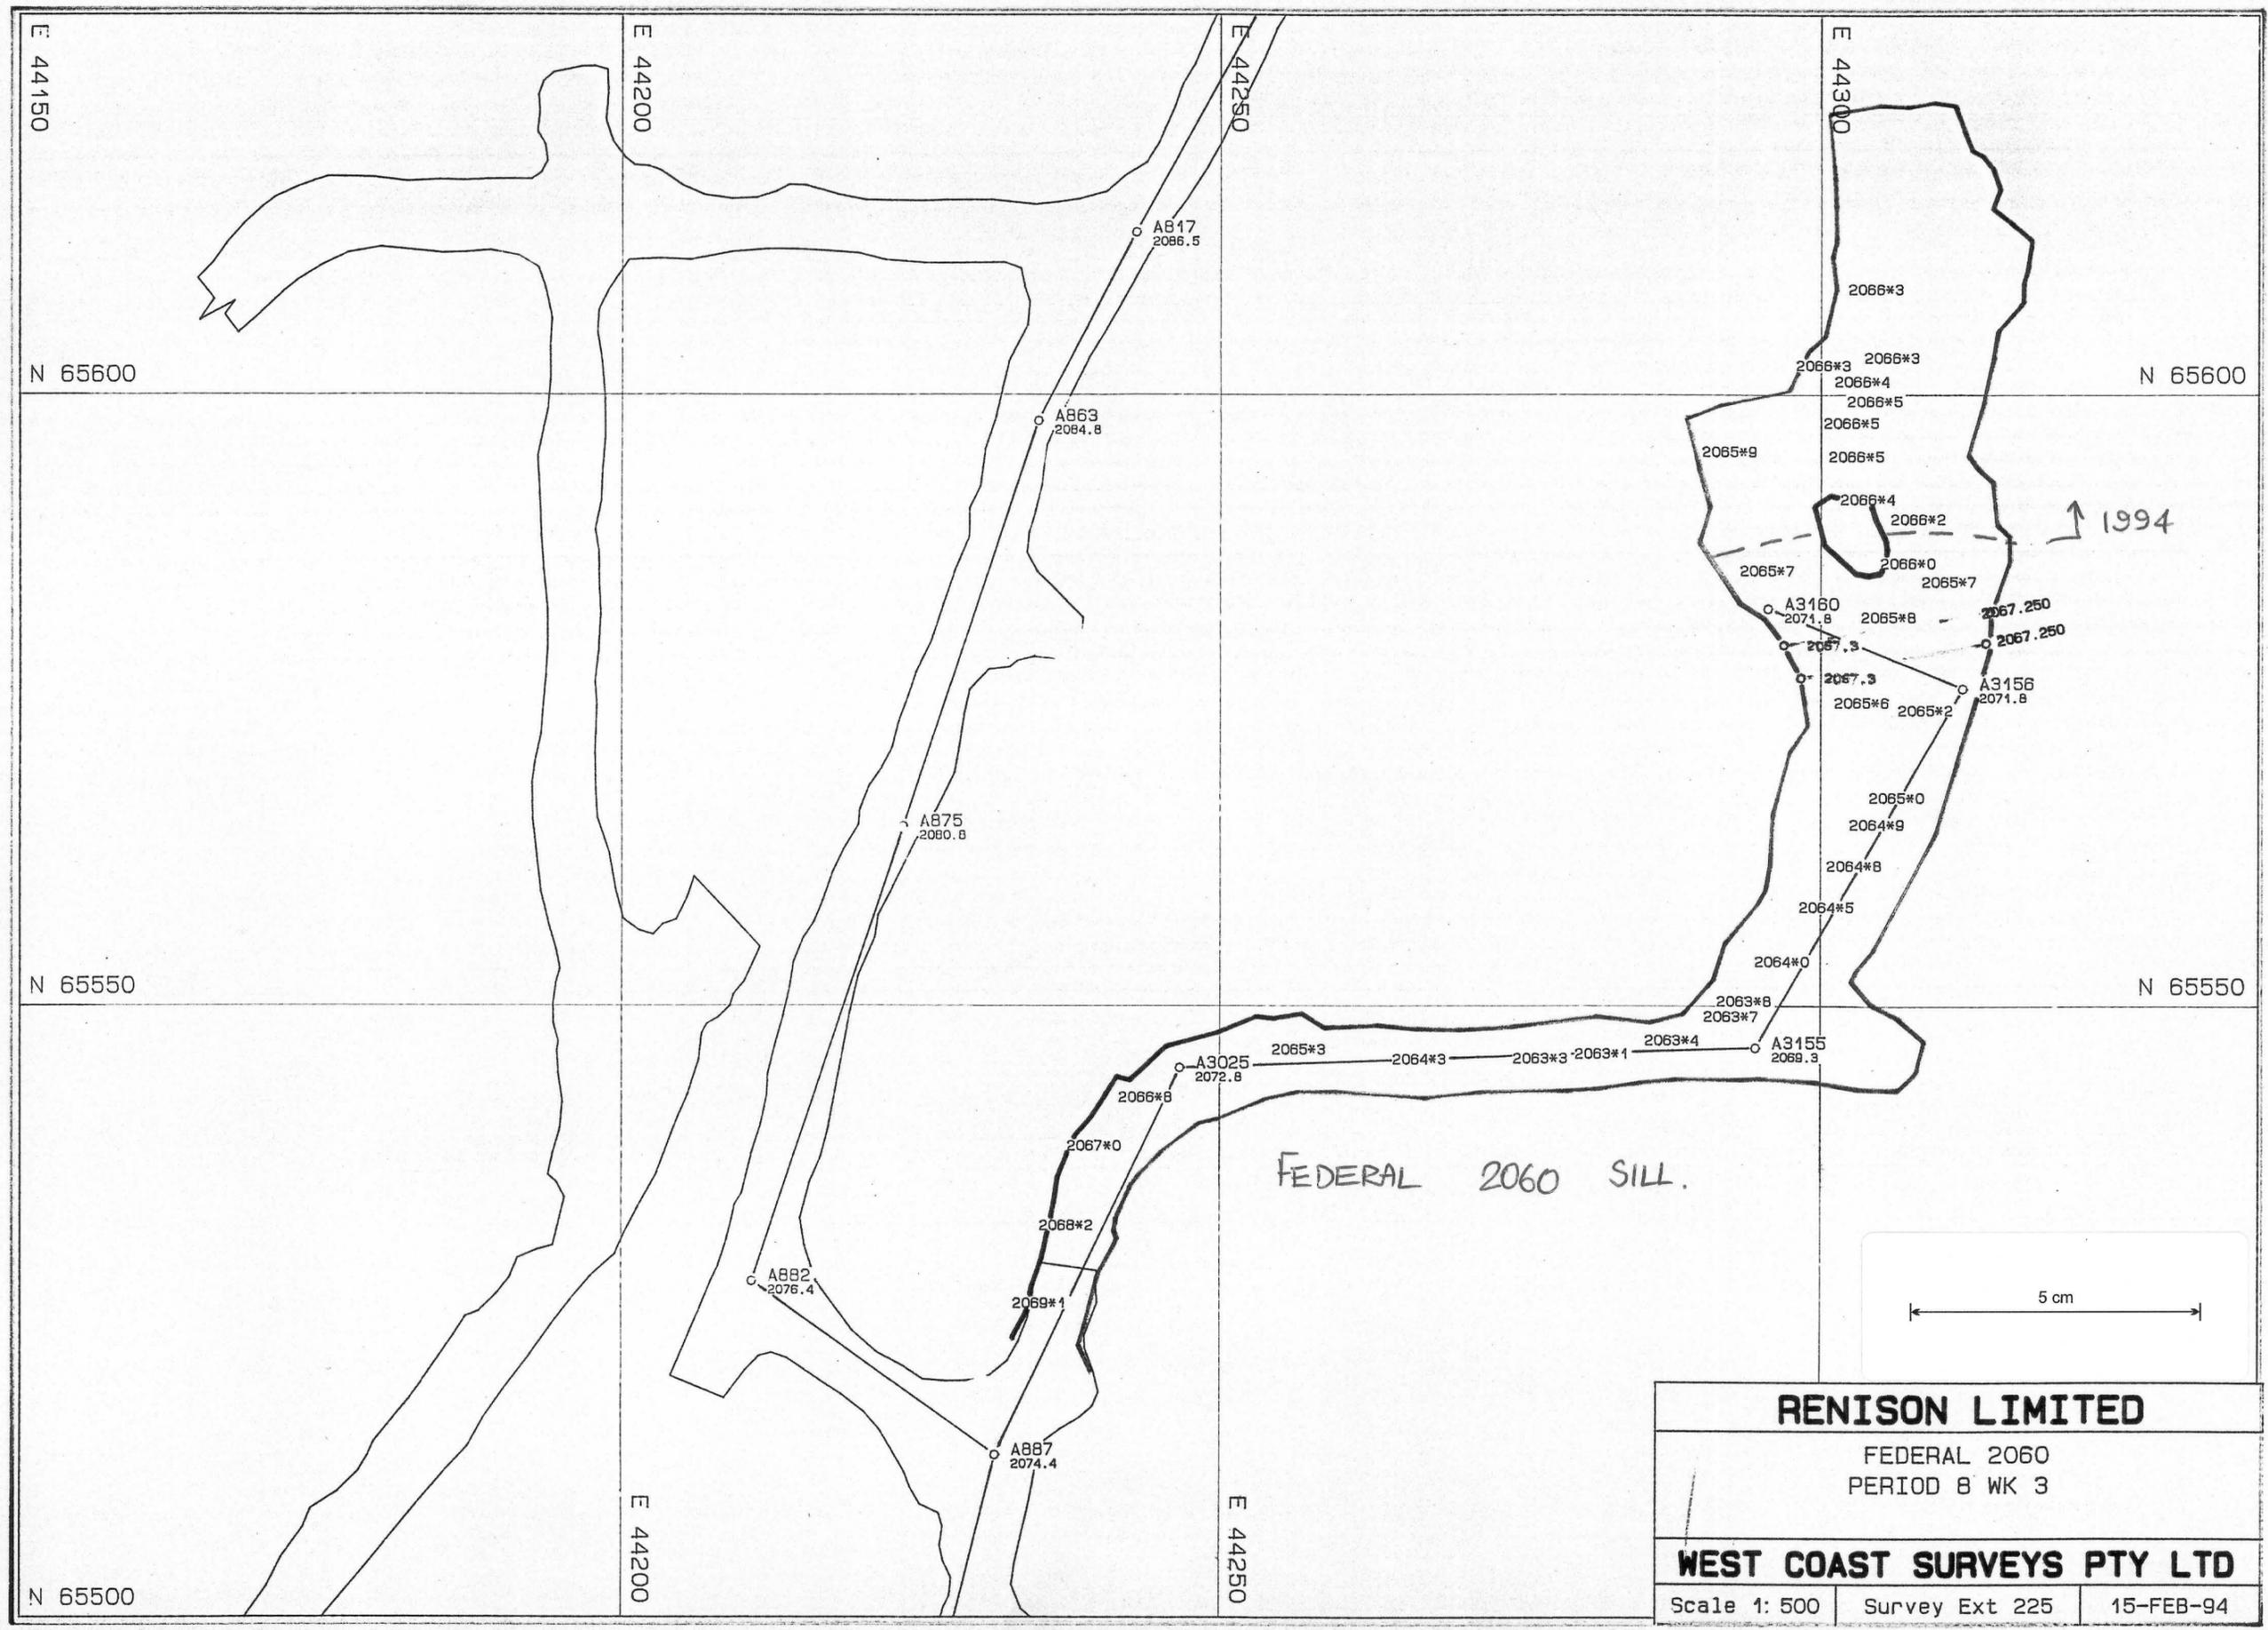

RENISON LIMITED

FEDERAL 2060
PERIOD 8 WK 3

WEST COAST SURVEYS PTY LTD

Scale 1: 500	Survey Ext 225	15-FEB-94
--------------	----------------	-----------

FEDERB.PF