


0376 - 114

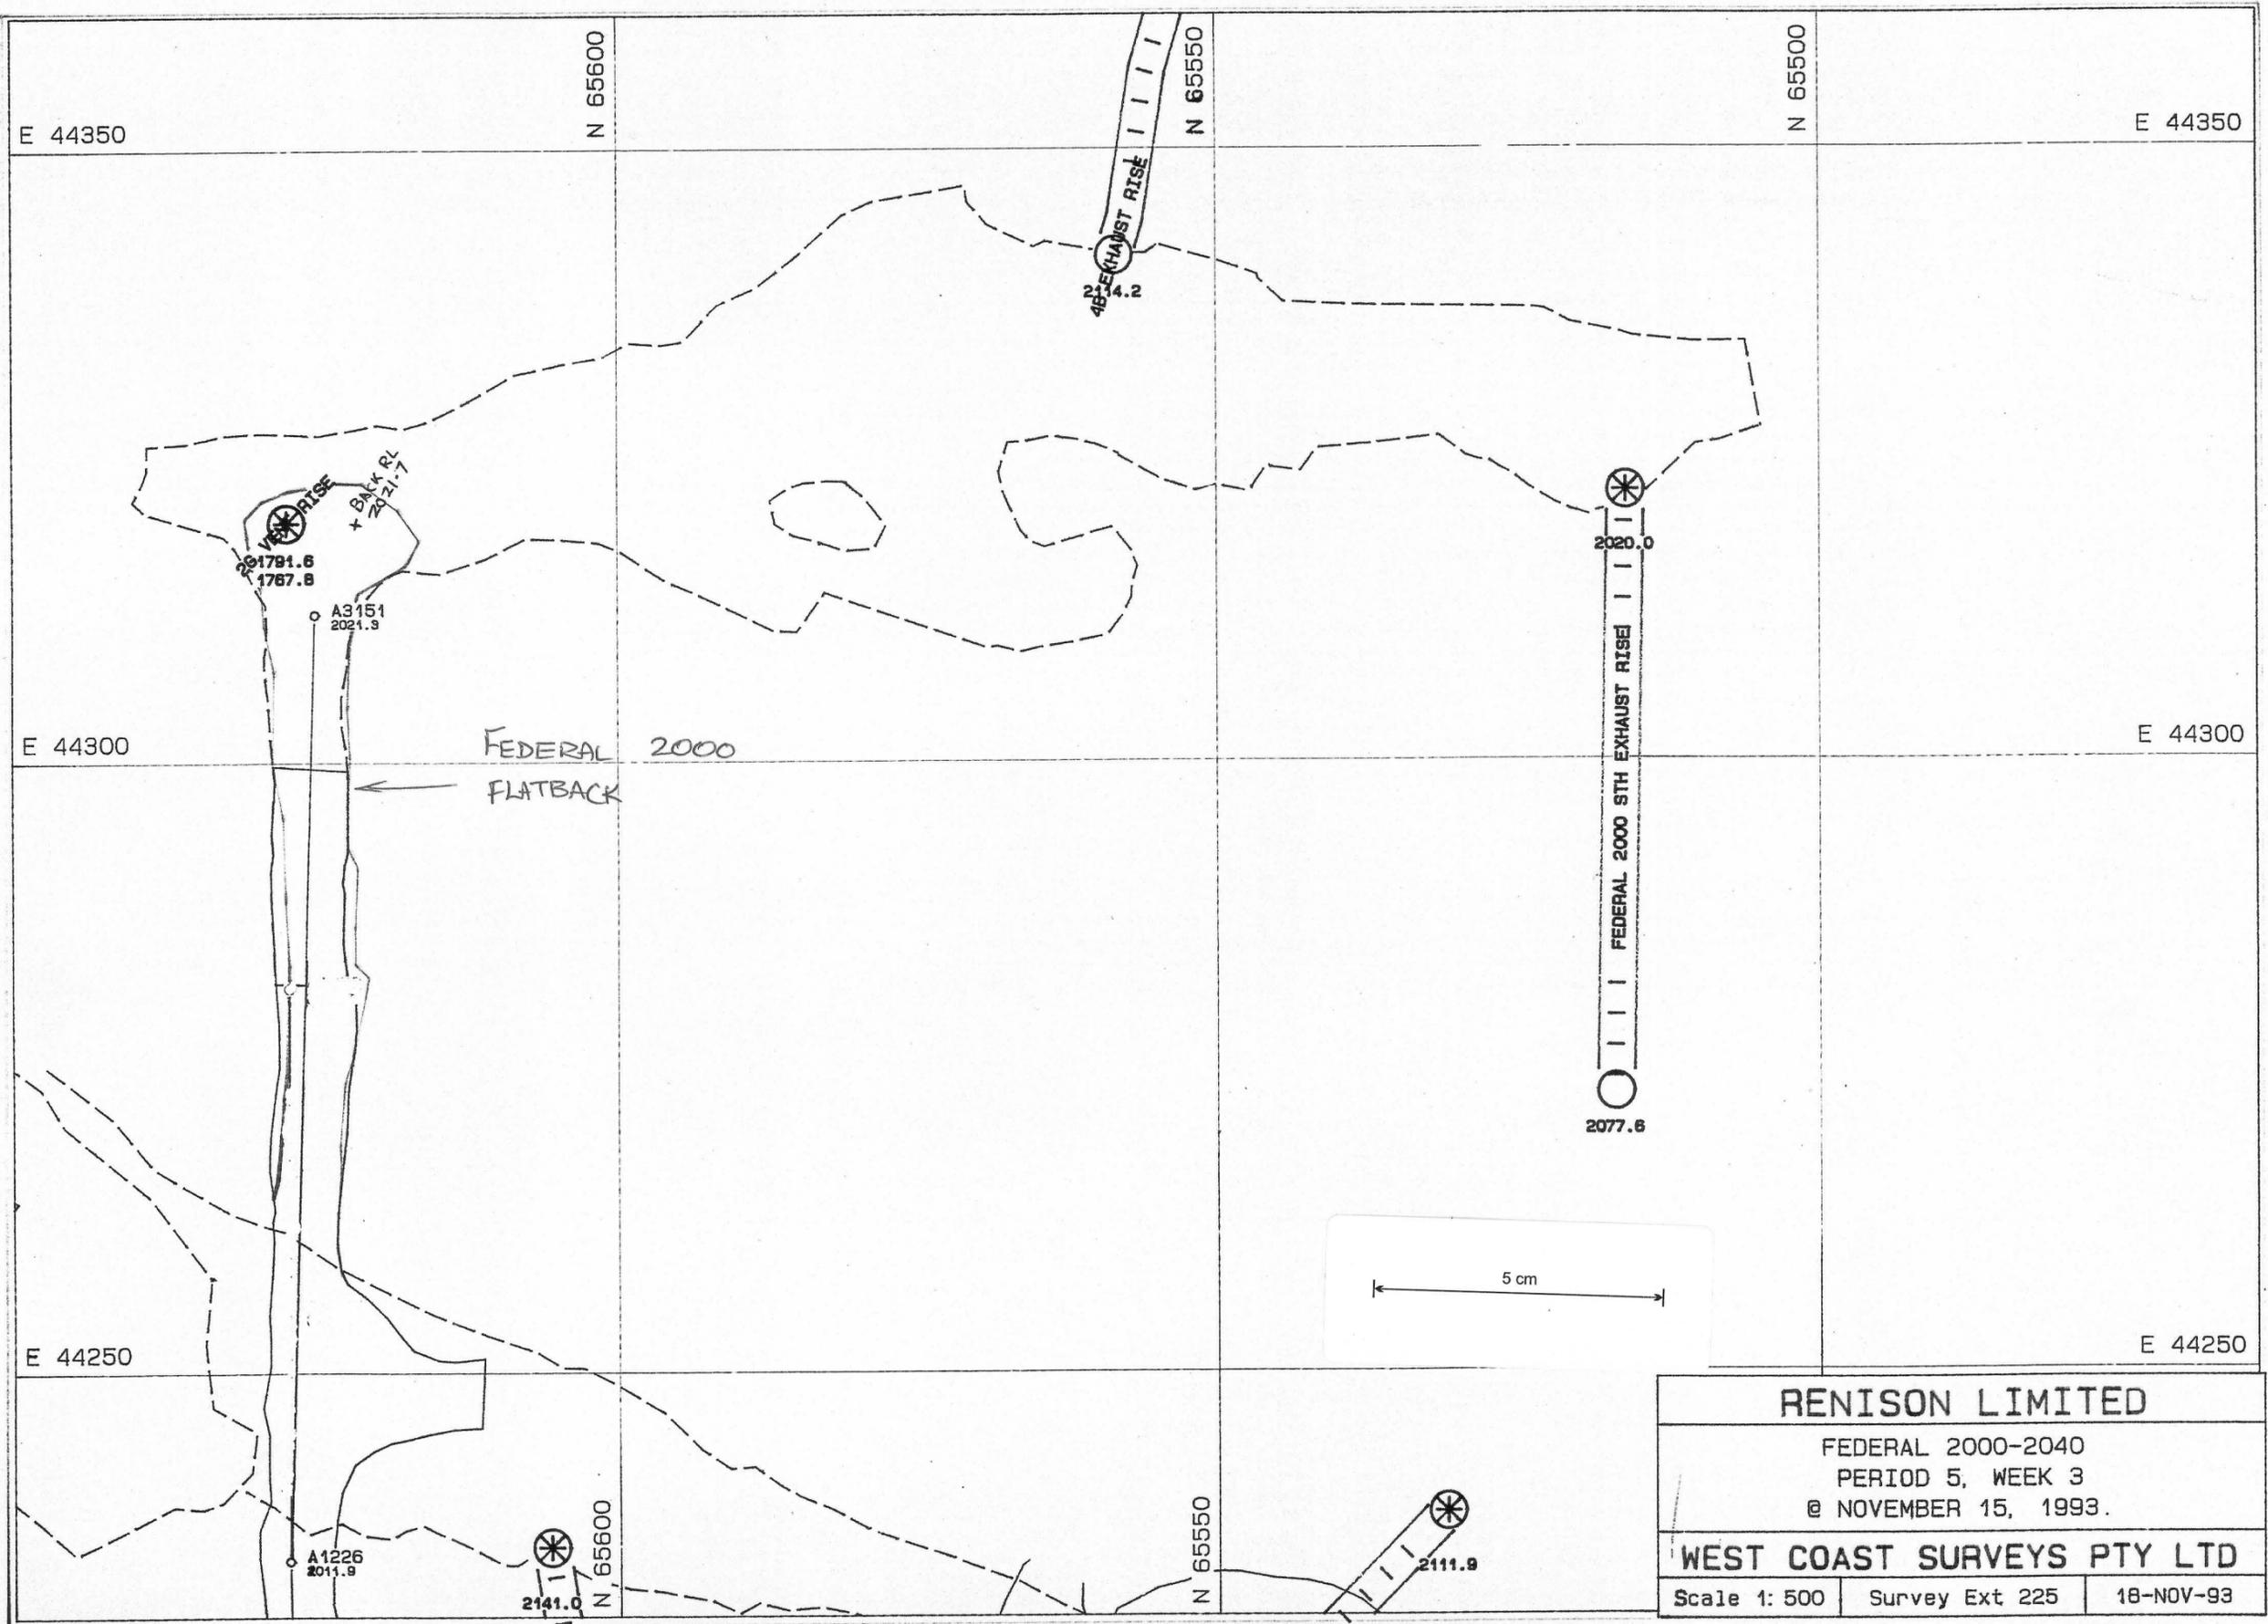

RENISON LIMITED		
FEDERAL 2000-2040 PERIOD 5, WEEK 3 @ NOVEMBER 15, 1993.		
WEST COAST SURVEYS PTY LTD		
Scale 1: 500	Survey Ext 225	18-NOV-93