
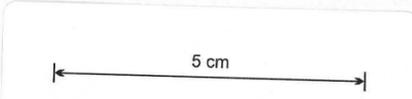


0376-115

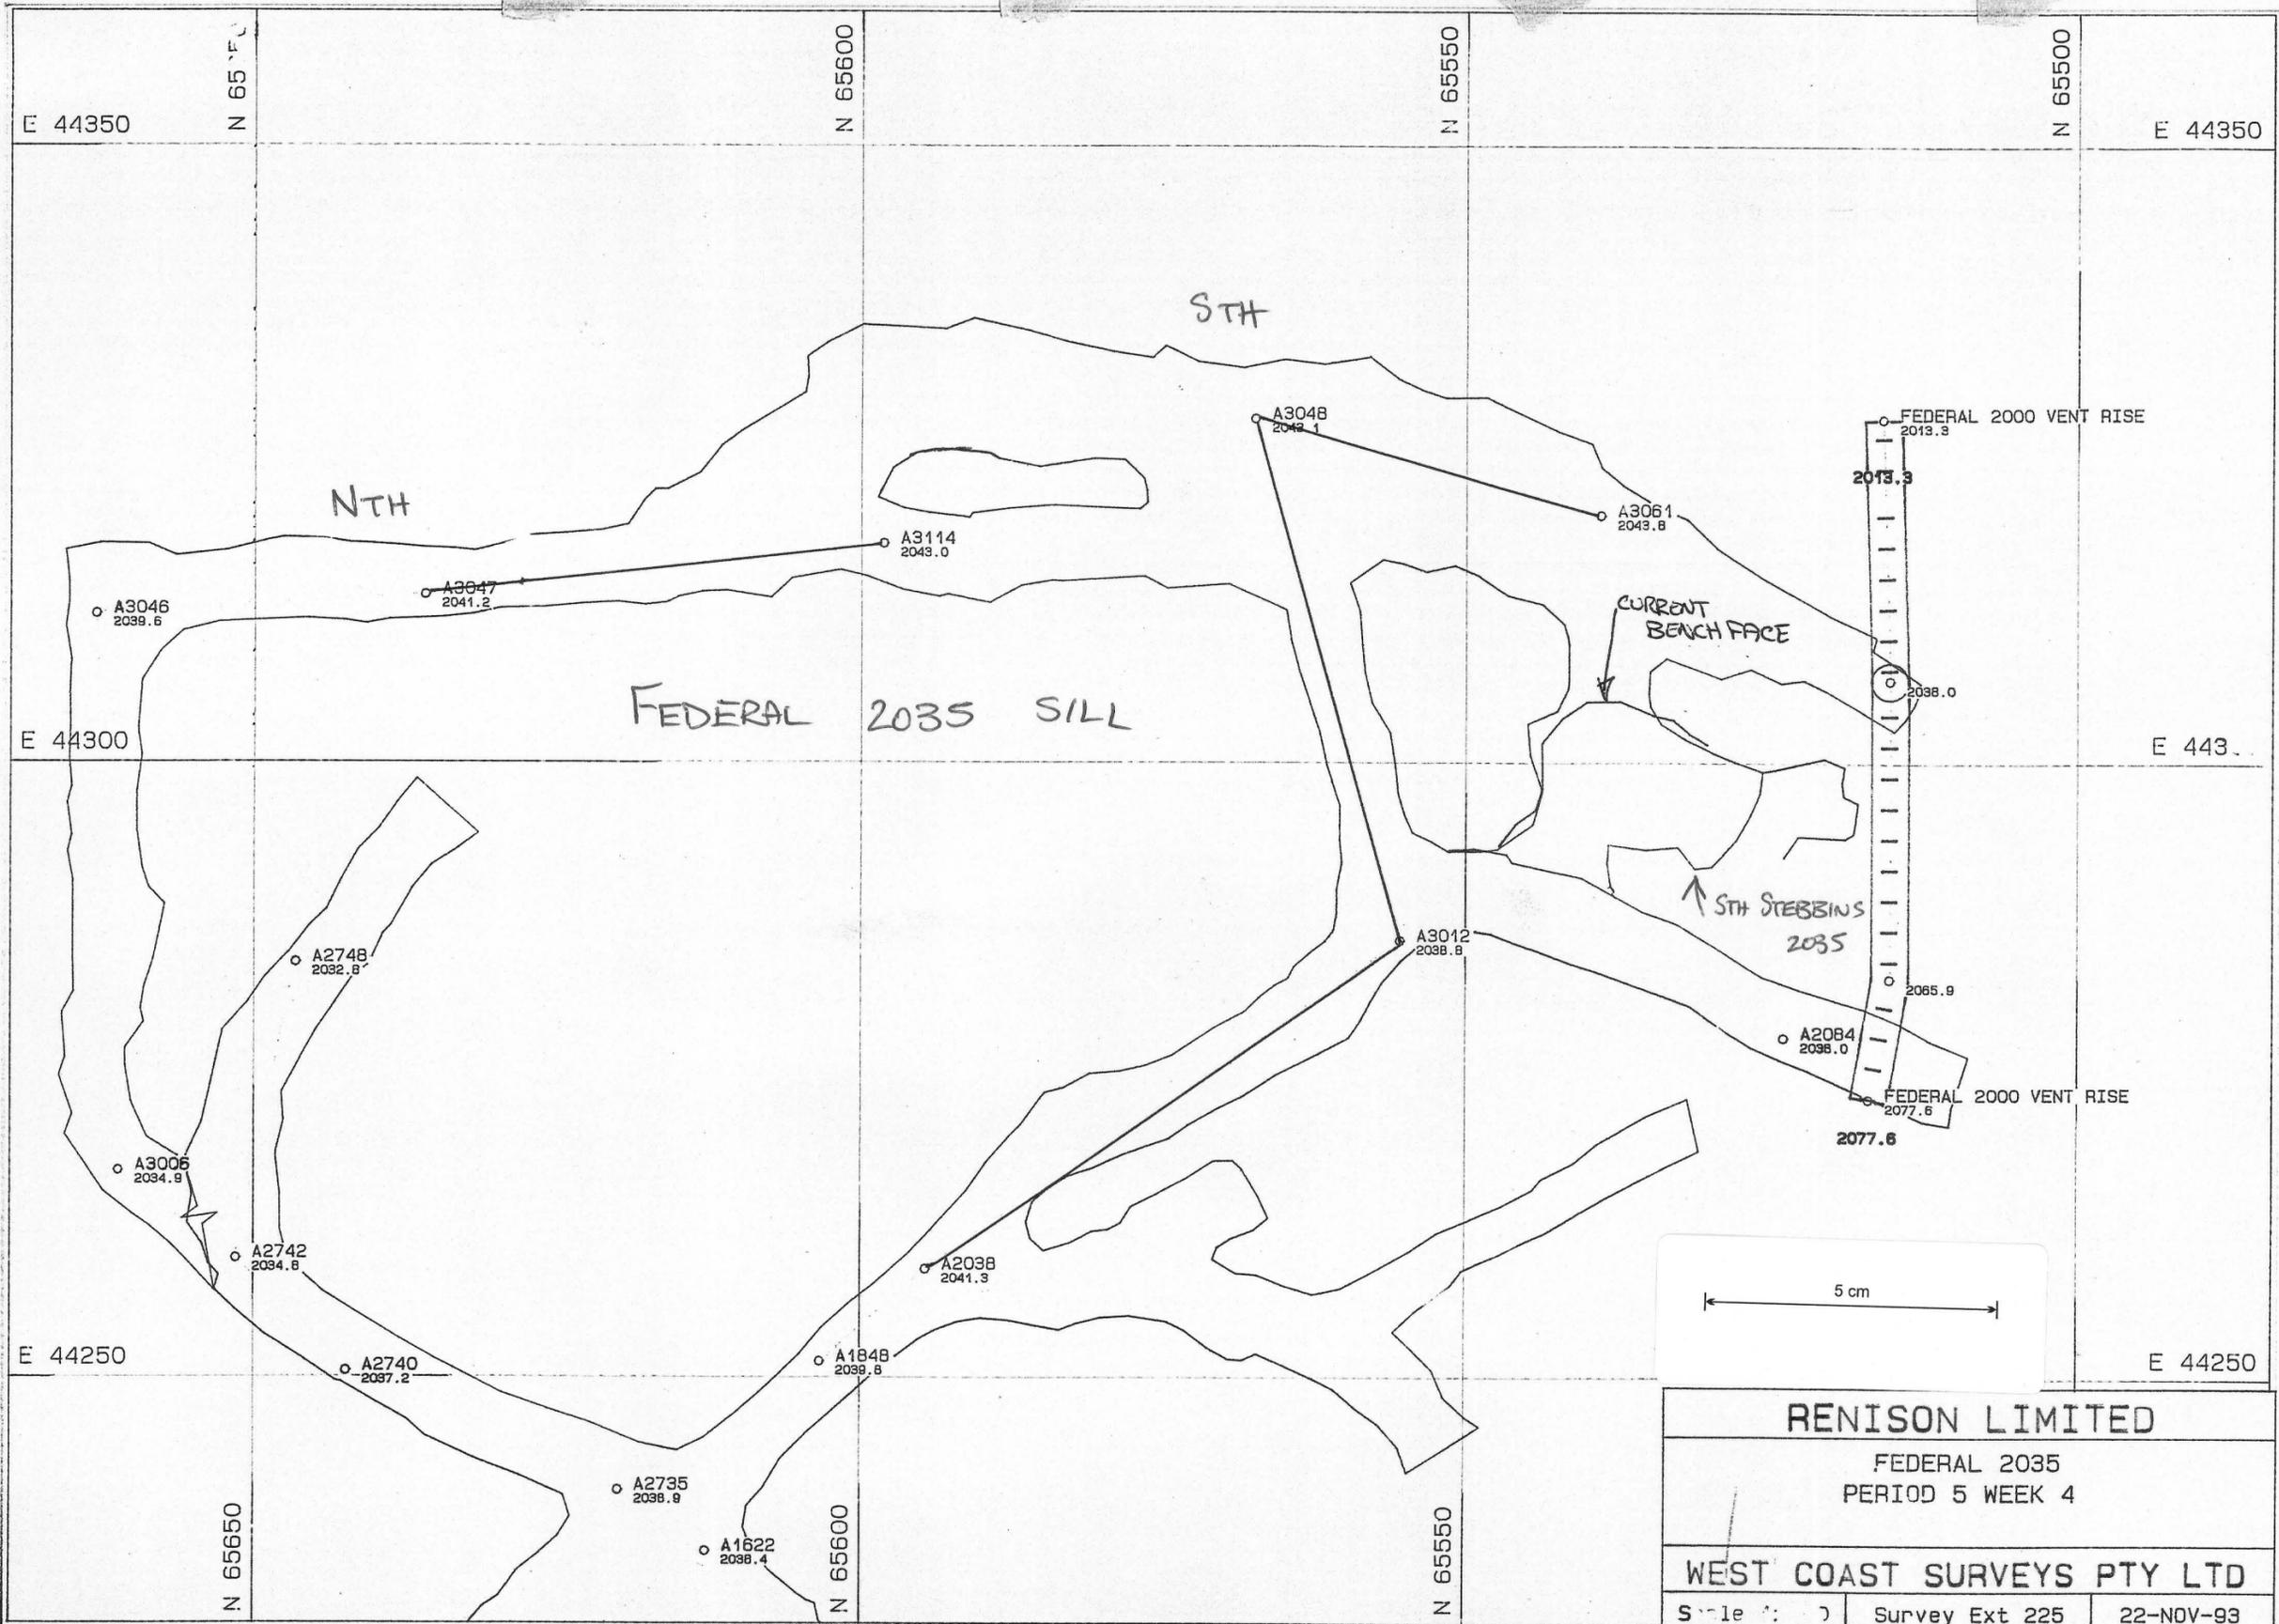

RENISON LIMITED		
FEDERAL 2035 PERIOD 5 WEEK 4		
WEST COAST SURVEYS PTY LTD		
Scale 1: 100	Survey Ext 225	22-NOV-93

FEDERA.PF