


0376 - 116

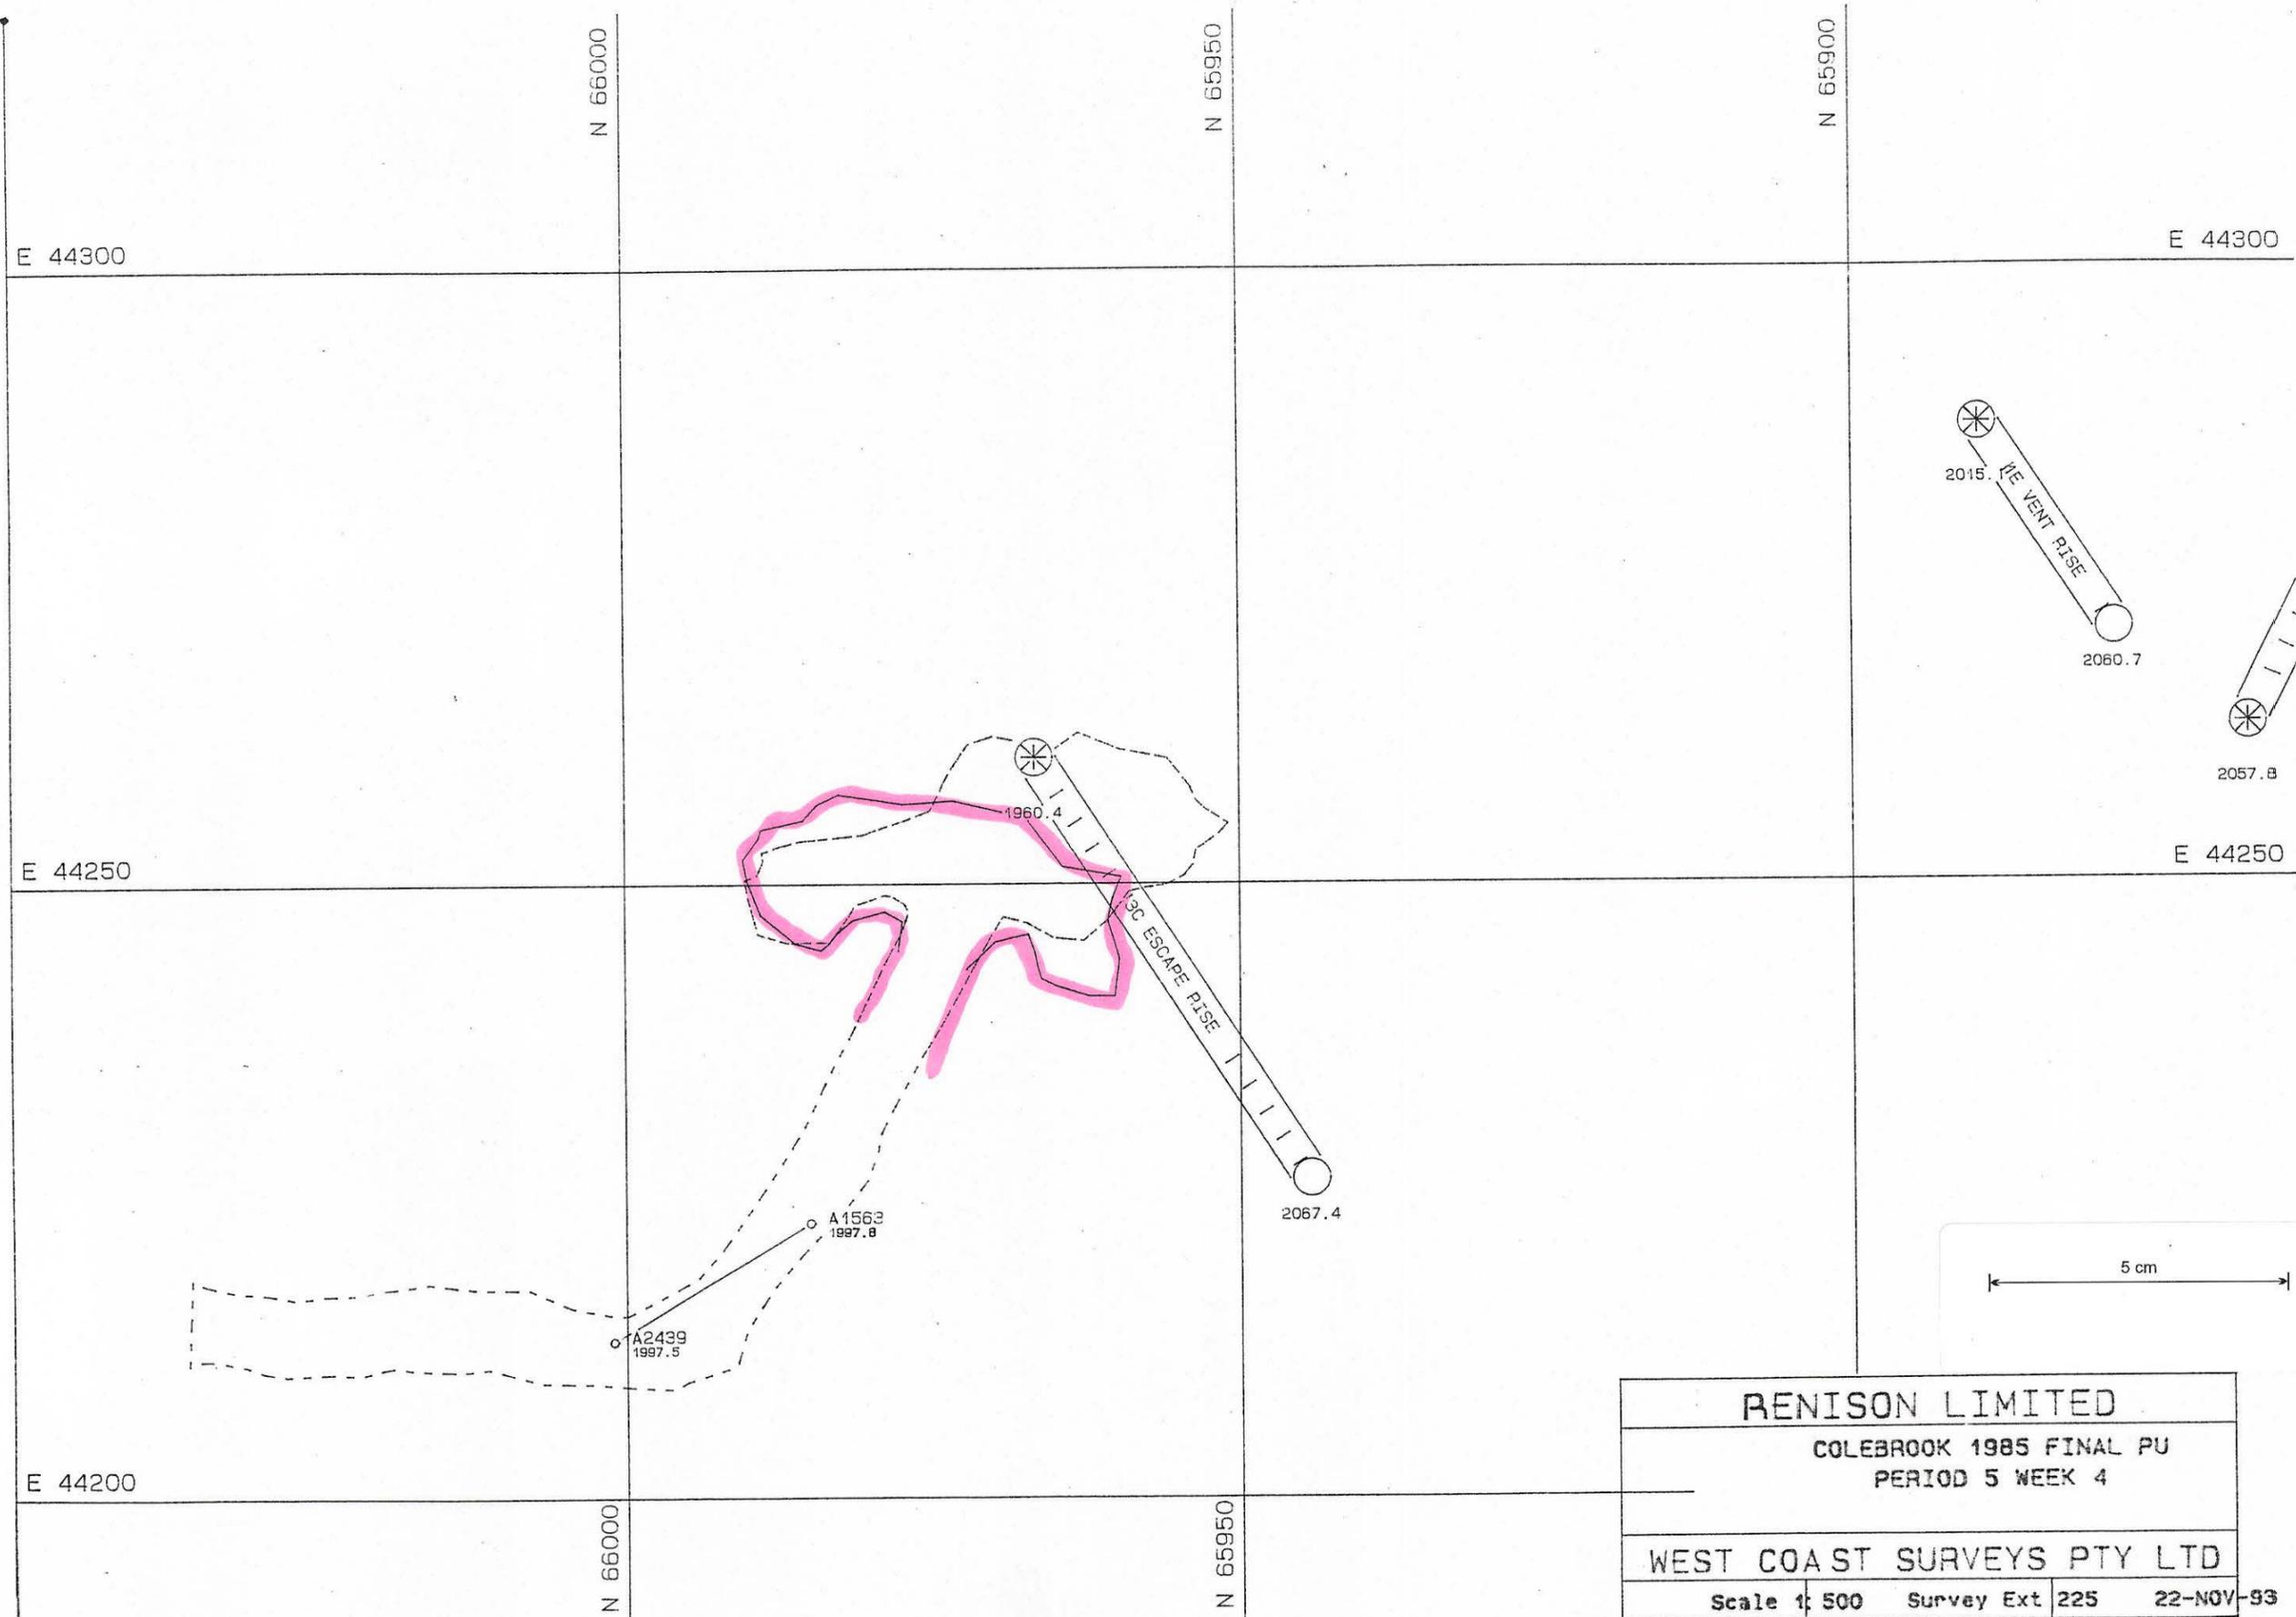

RENISON LIMITED			
COLEBROOK 1985 FINAL PU			
PERIOD 5 WEEK 4			
WEST COAST SURVEYS PTY LTD			
Scale 1:500	Survey Ext	225	22-NOV-93