


0376-117

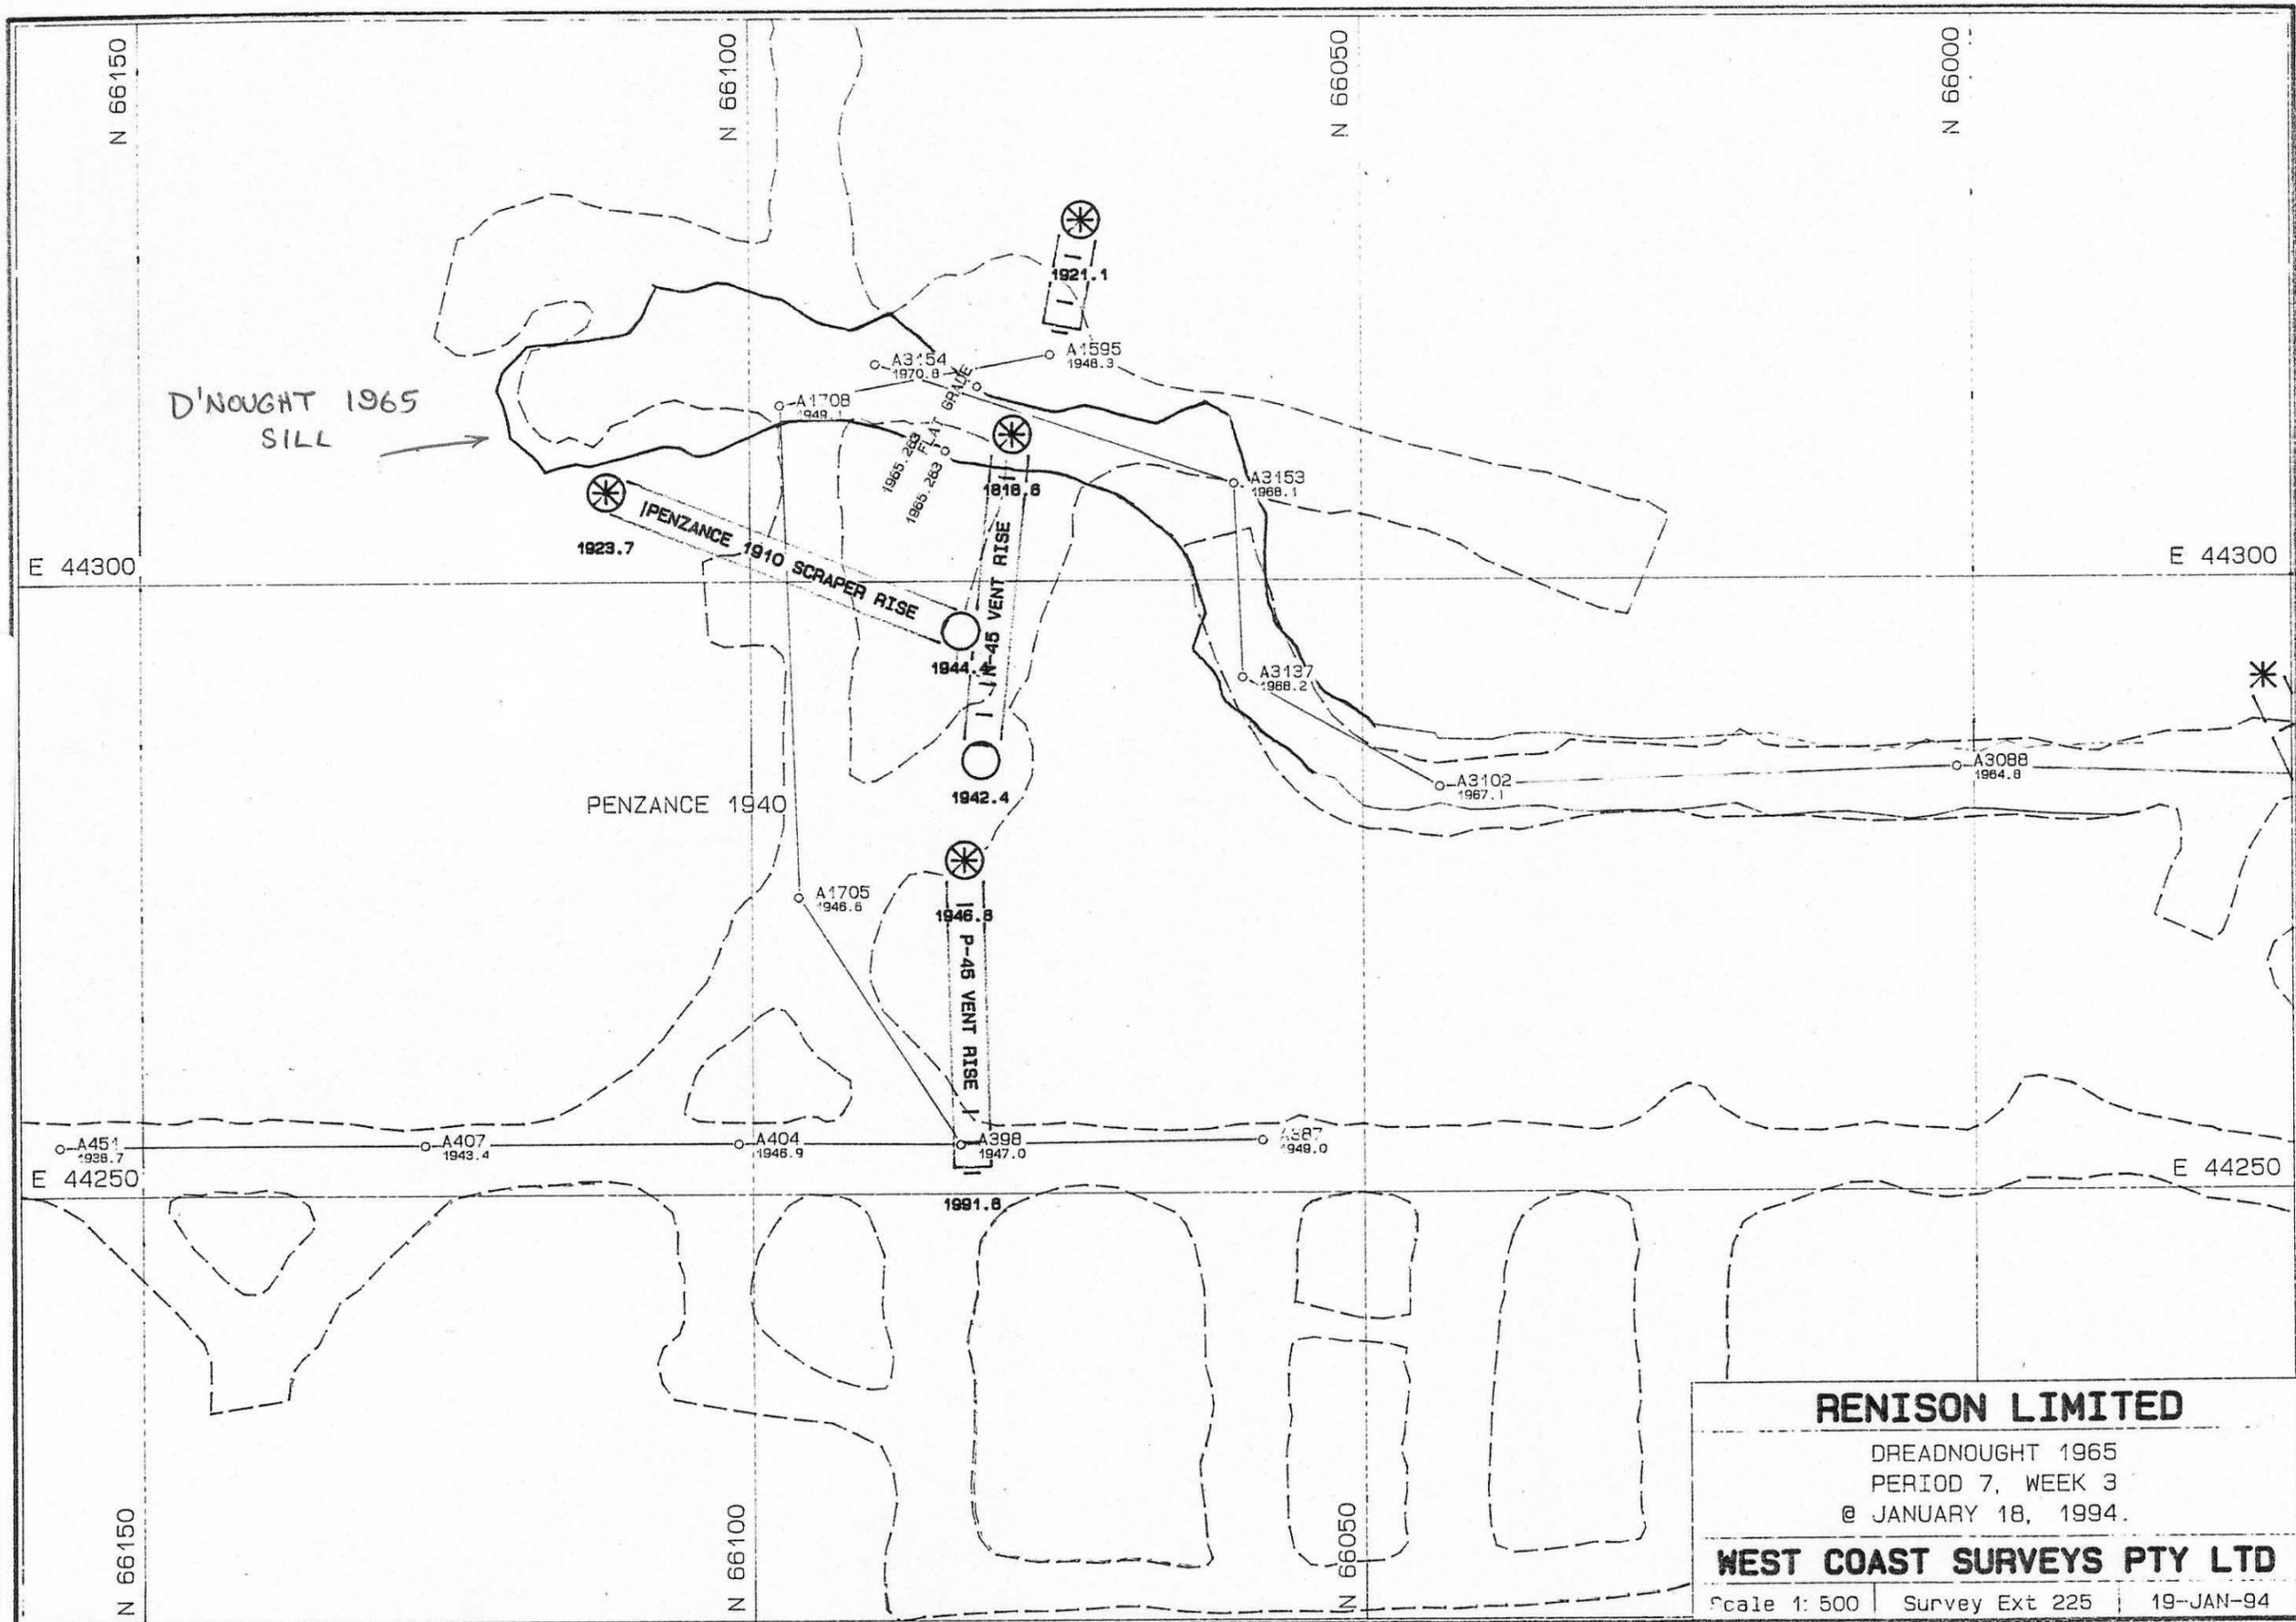

5 cm

RENISON LIMITED

DREADNOUGHT 1965
PERIOD 7, WEEK 3
@ JANUARY 18, 1994.

WEST COAST SURVEYS PTY LTD

Scale 1: 500 | Survey Ext 225 | 19-JAN-94

DREADB.PF