
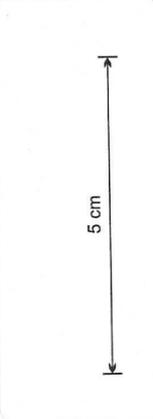


0376 - 120

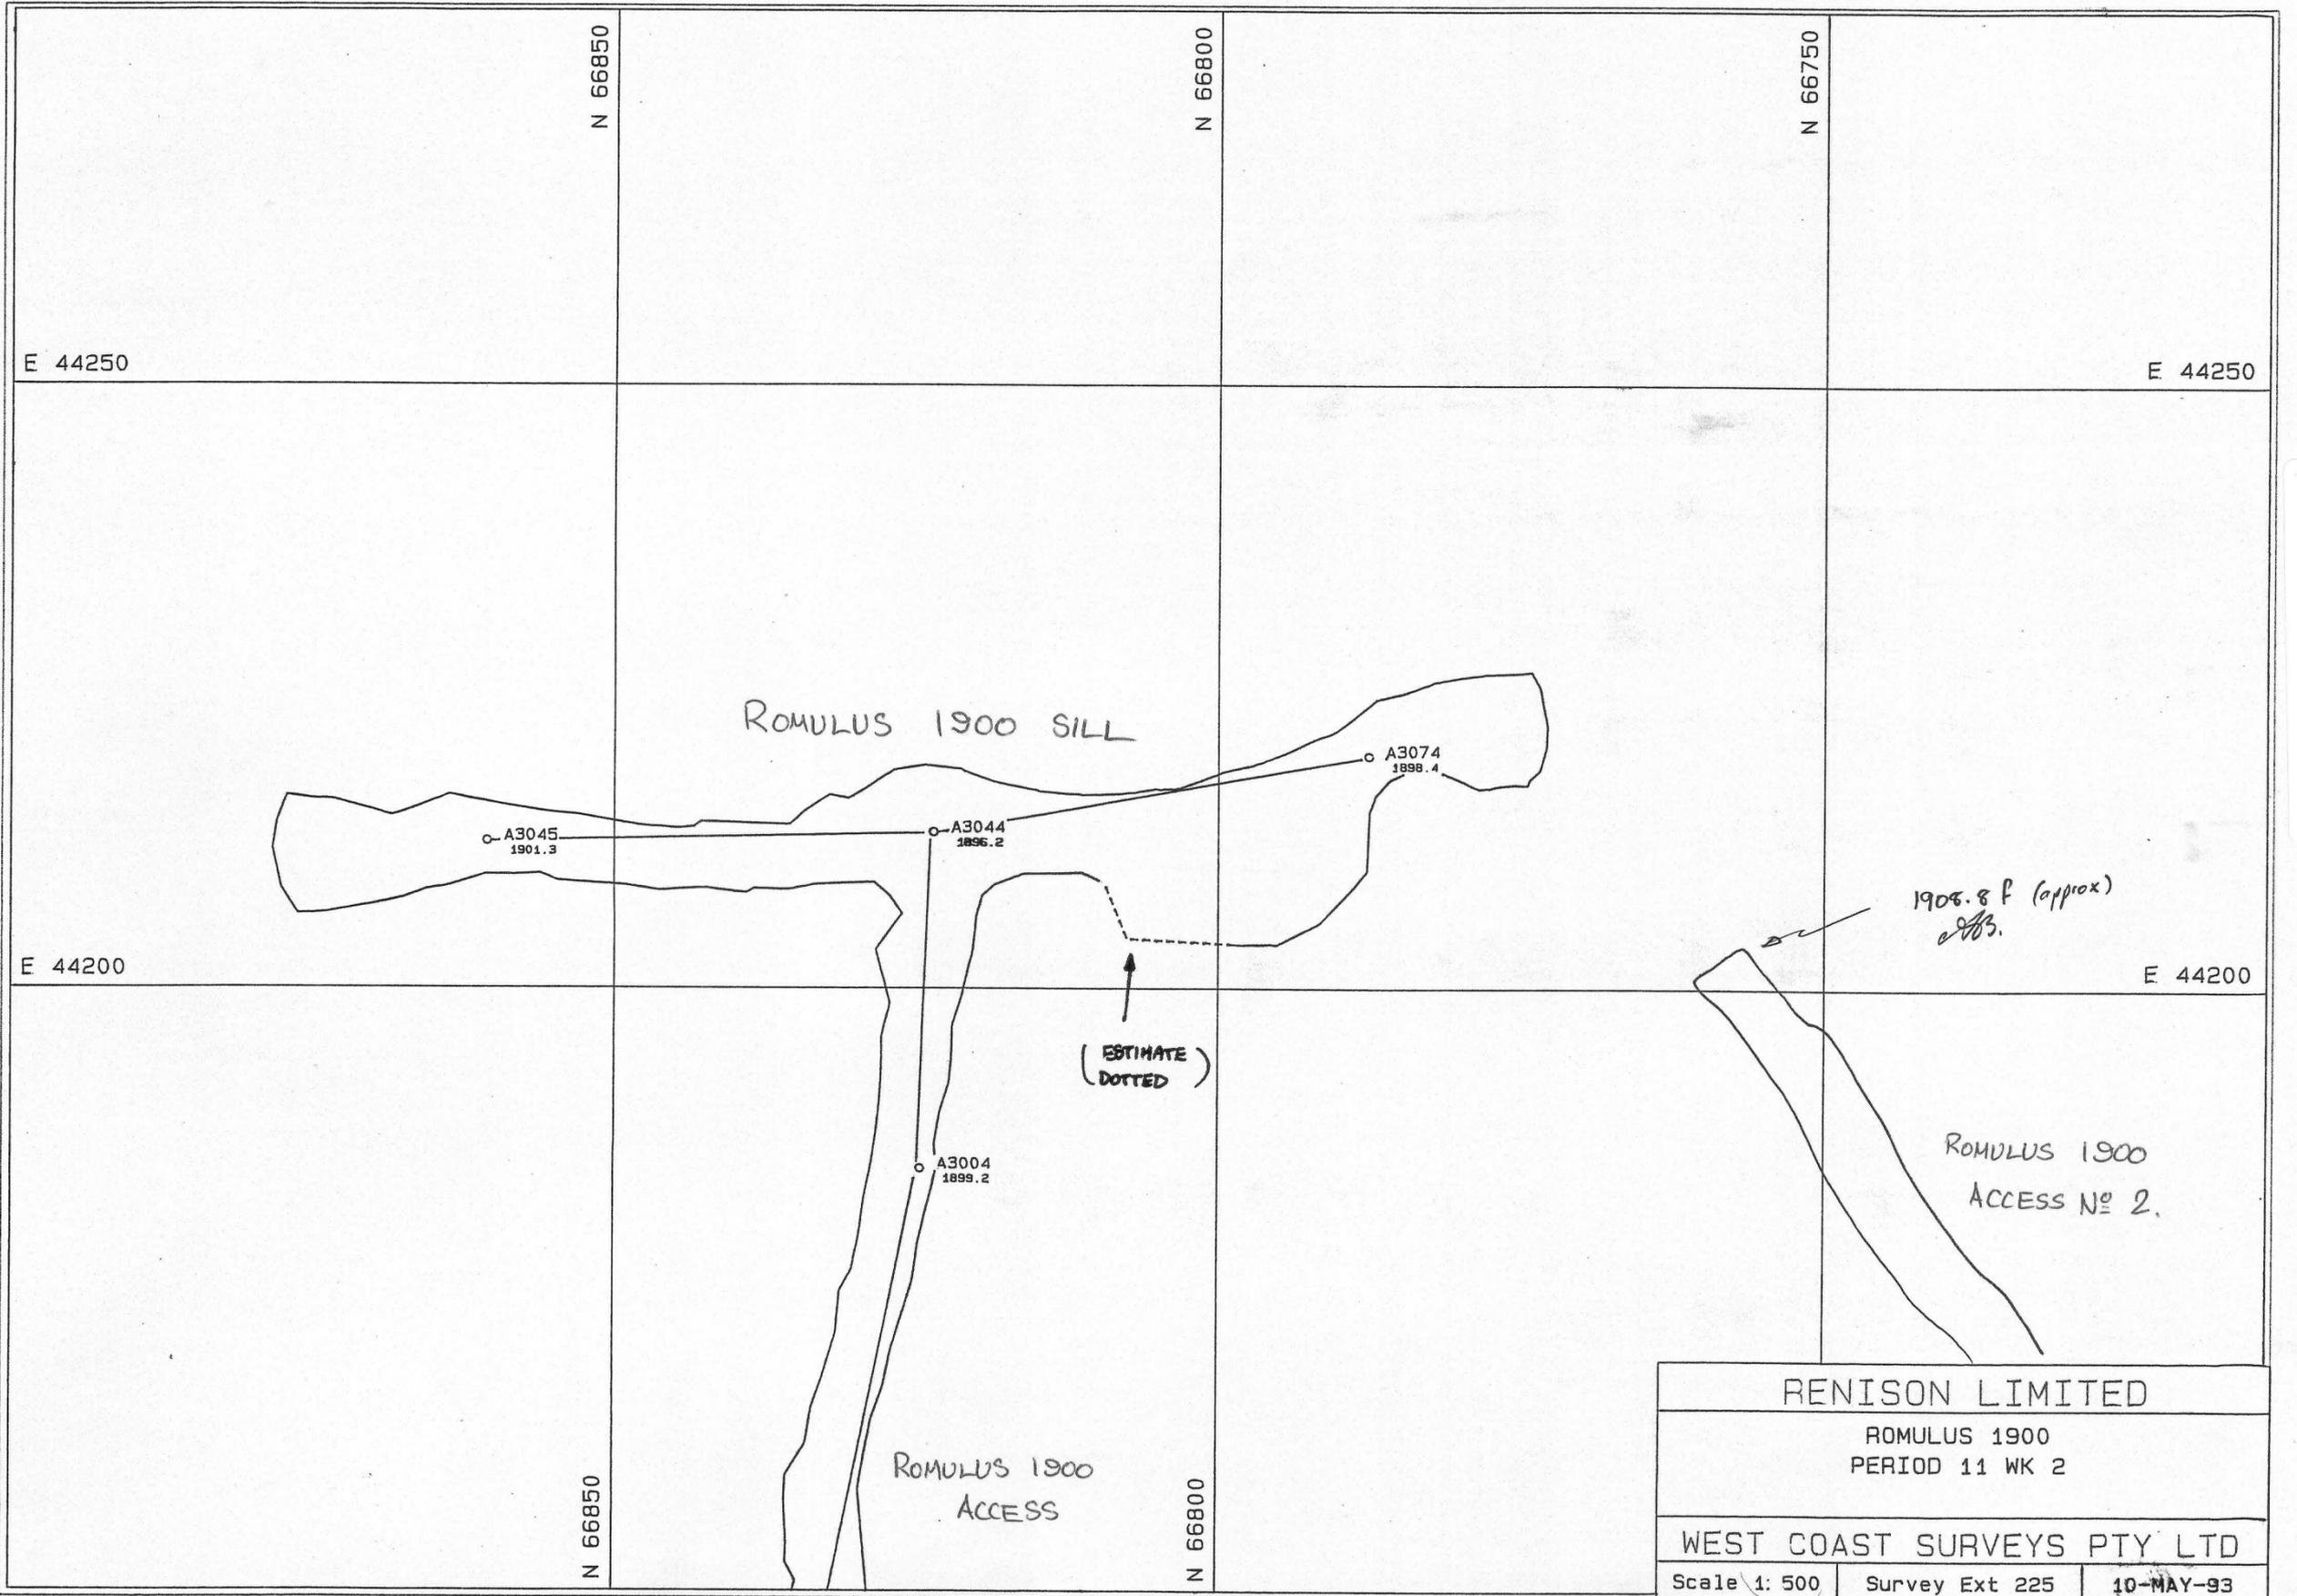

RENISON LIMITED		
ROMULUS 1900 PERIOD 11 WK 2		
WEST COAST SURVEYS PTY LTD		
Scale 1: 500	Survey Ext 225	10-MAY-93

ROMULA.PF