


0376-121

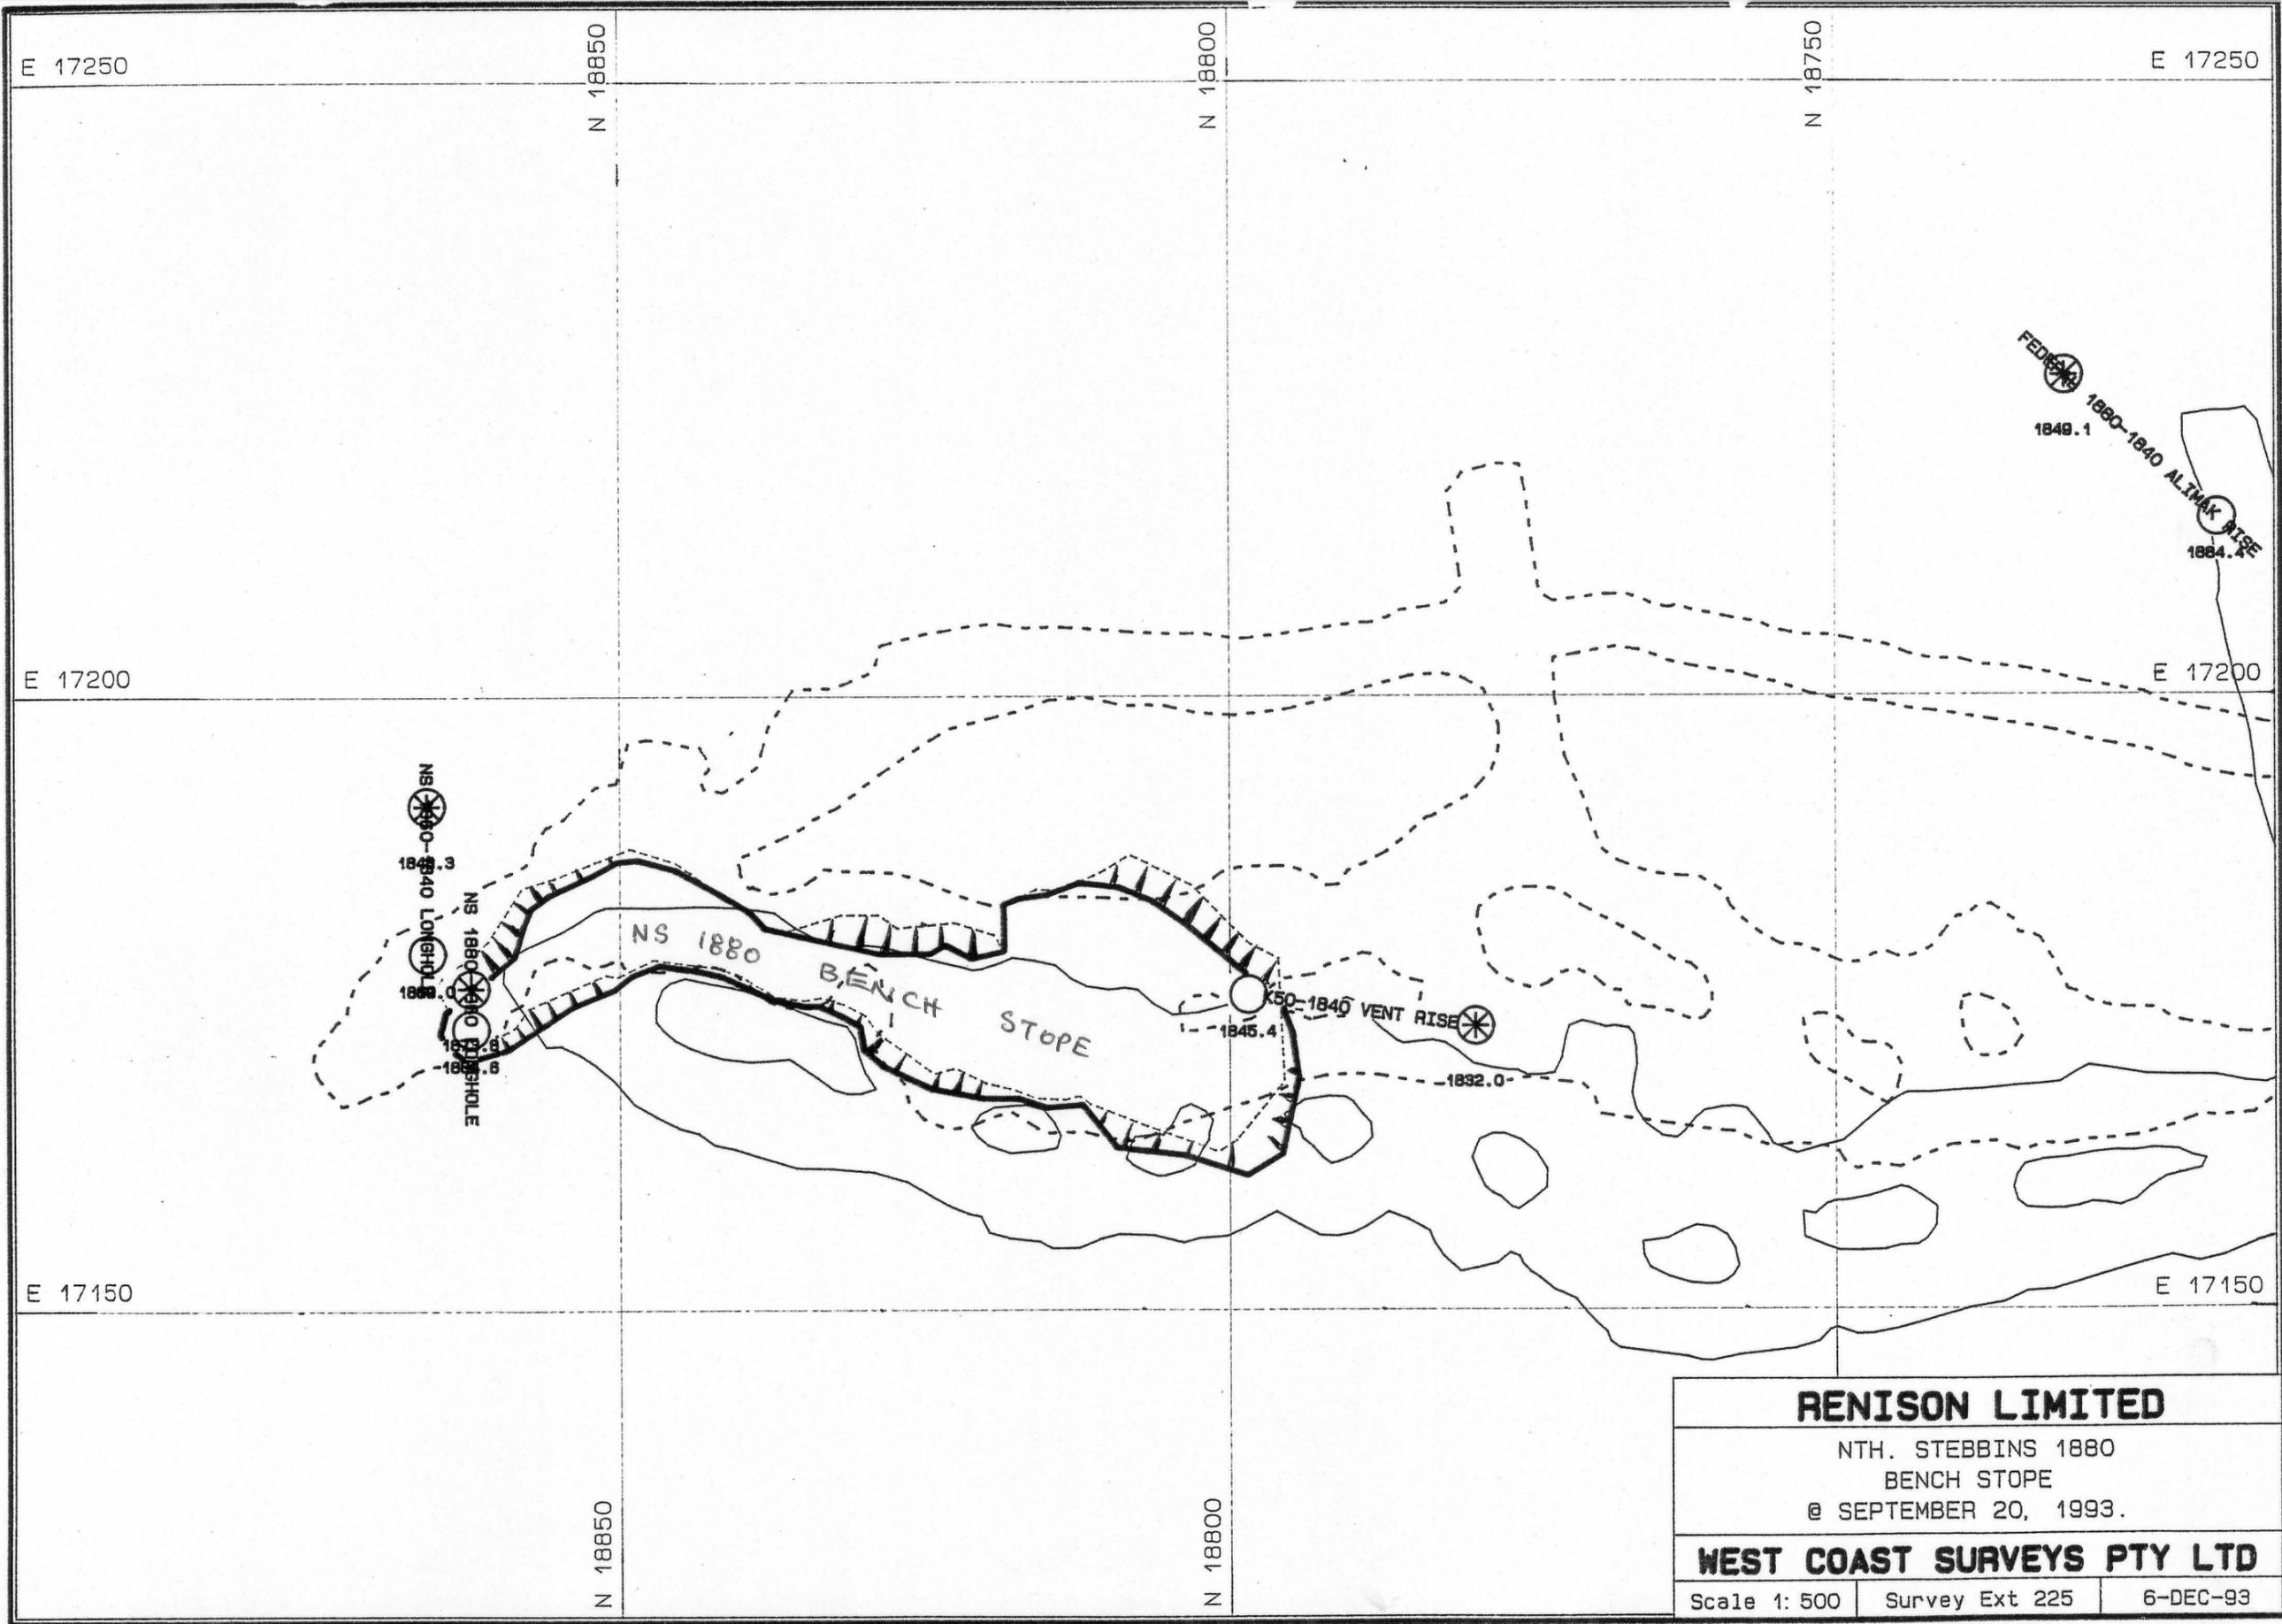

<b>RENISON LIMITED</b>		
NTH. STEBBINS 1880 BENCH STOPE @ SEPTEMBER 20, 1993.		
<b>WEST COAST SURVEYS PTY LTD</b>		
Scale 1: 500	Survey Ext 225	6-DEC-93

NTHSTA.PF