


0376-122

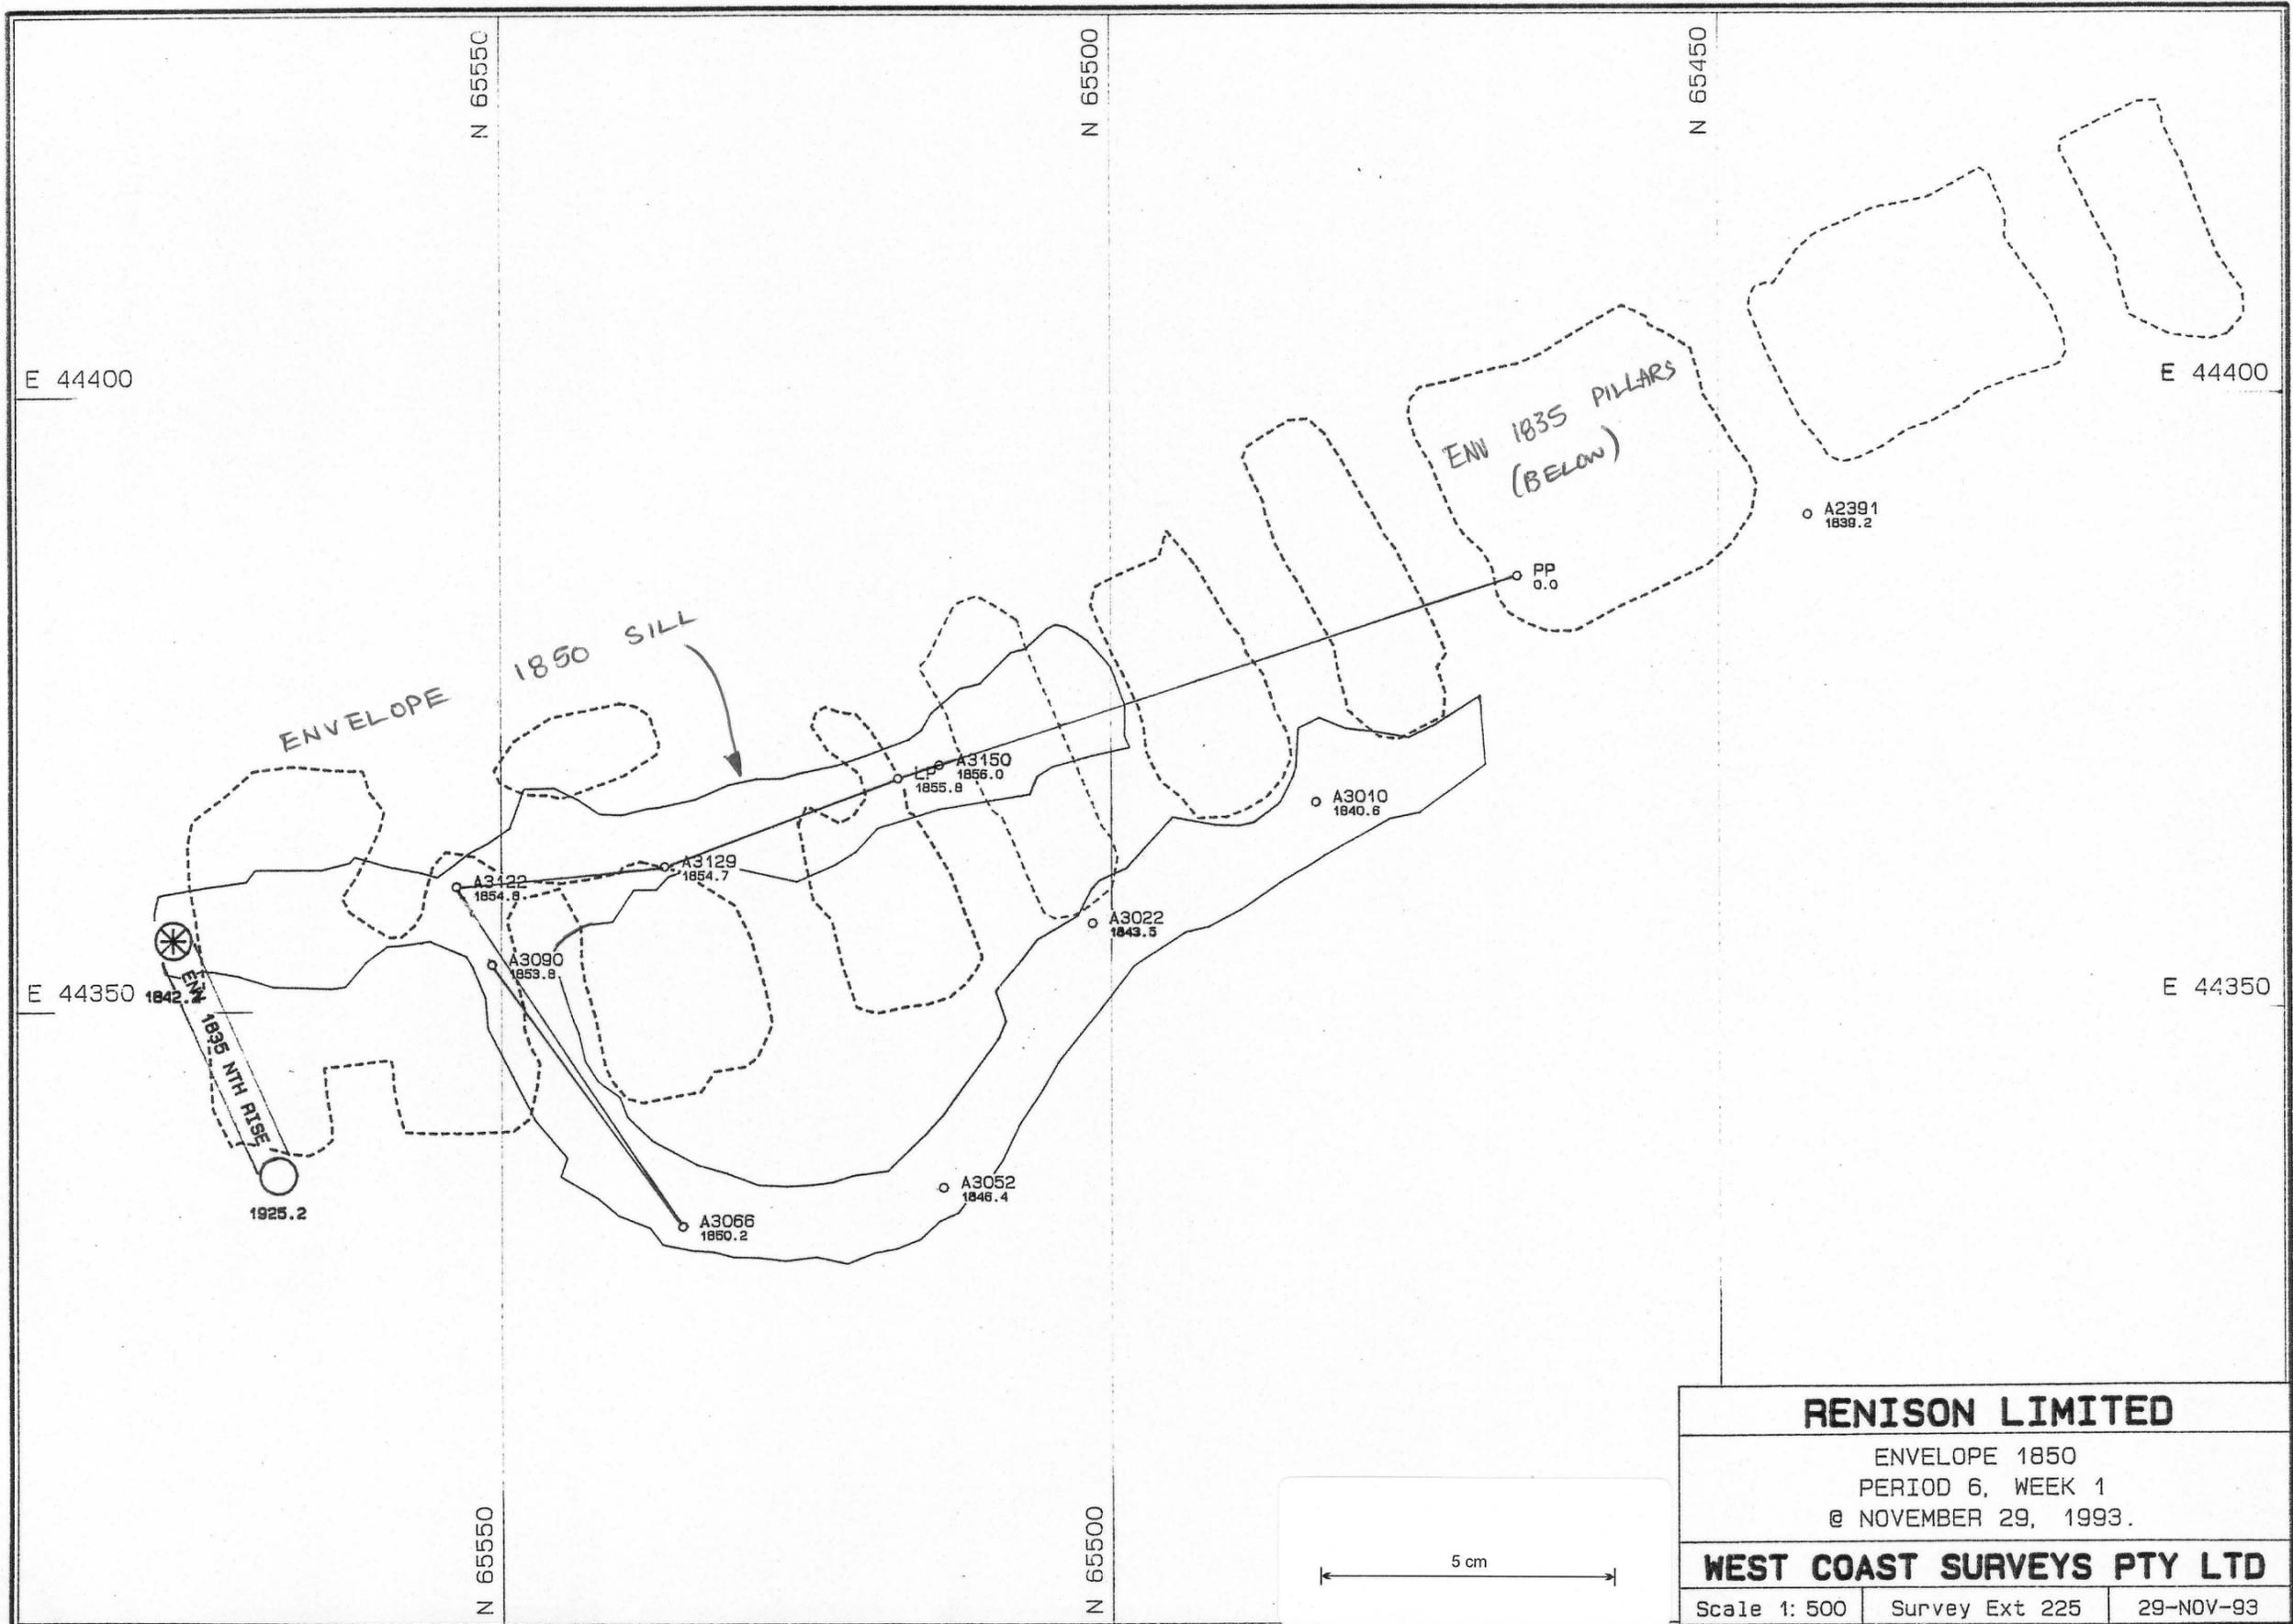

RENISON LIMITED		
ENVELOPE 1850 PERIOD 6, WEEK 1 @ NOVEMBER 29, 1993.		
WEST COAST SURVEYS PTY LTD		
Scale 1: 500	Survey Ext 225	29-NOV-93

ENVELA.PF