


0376-123

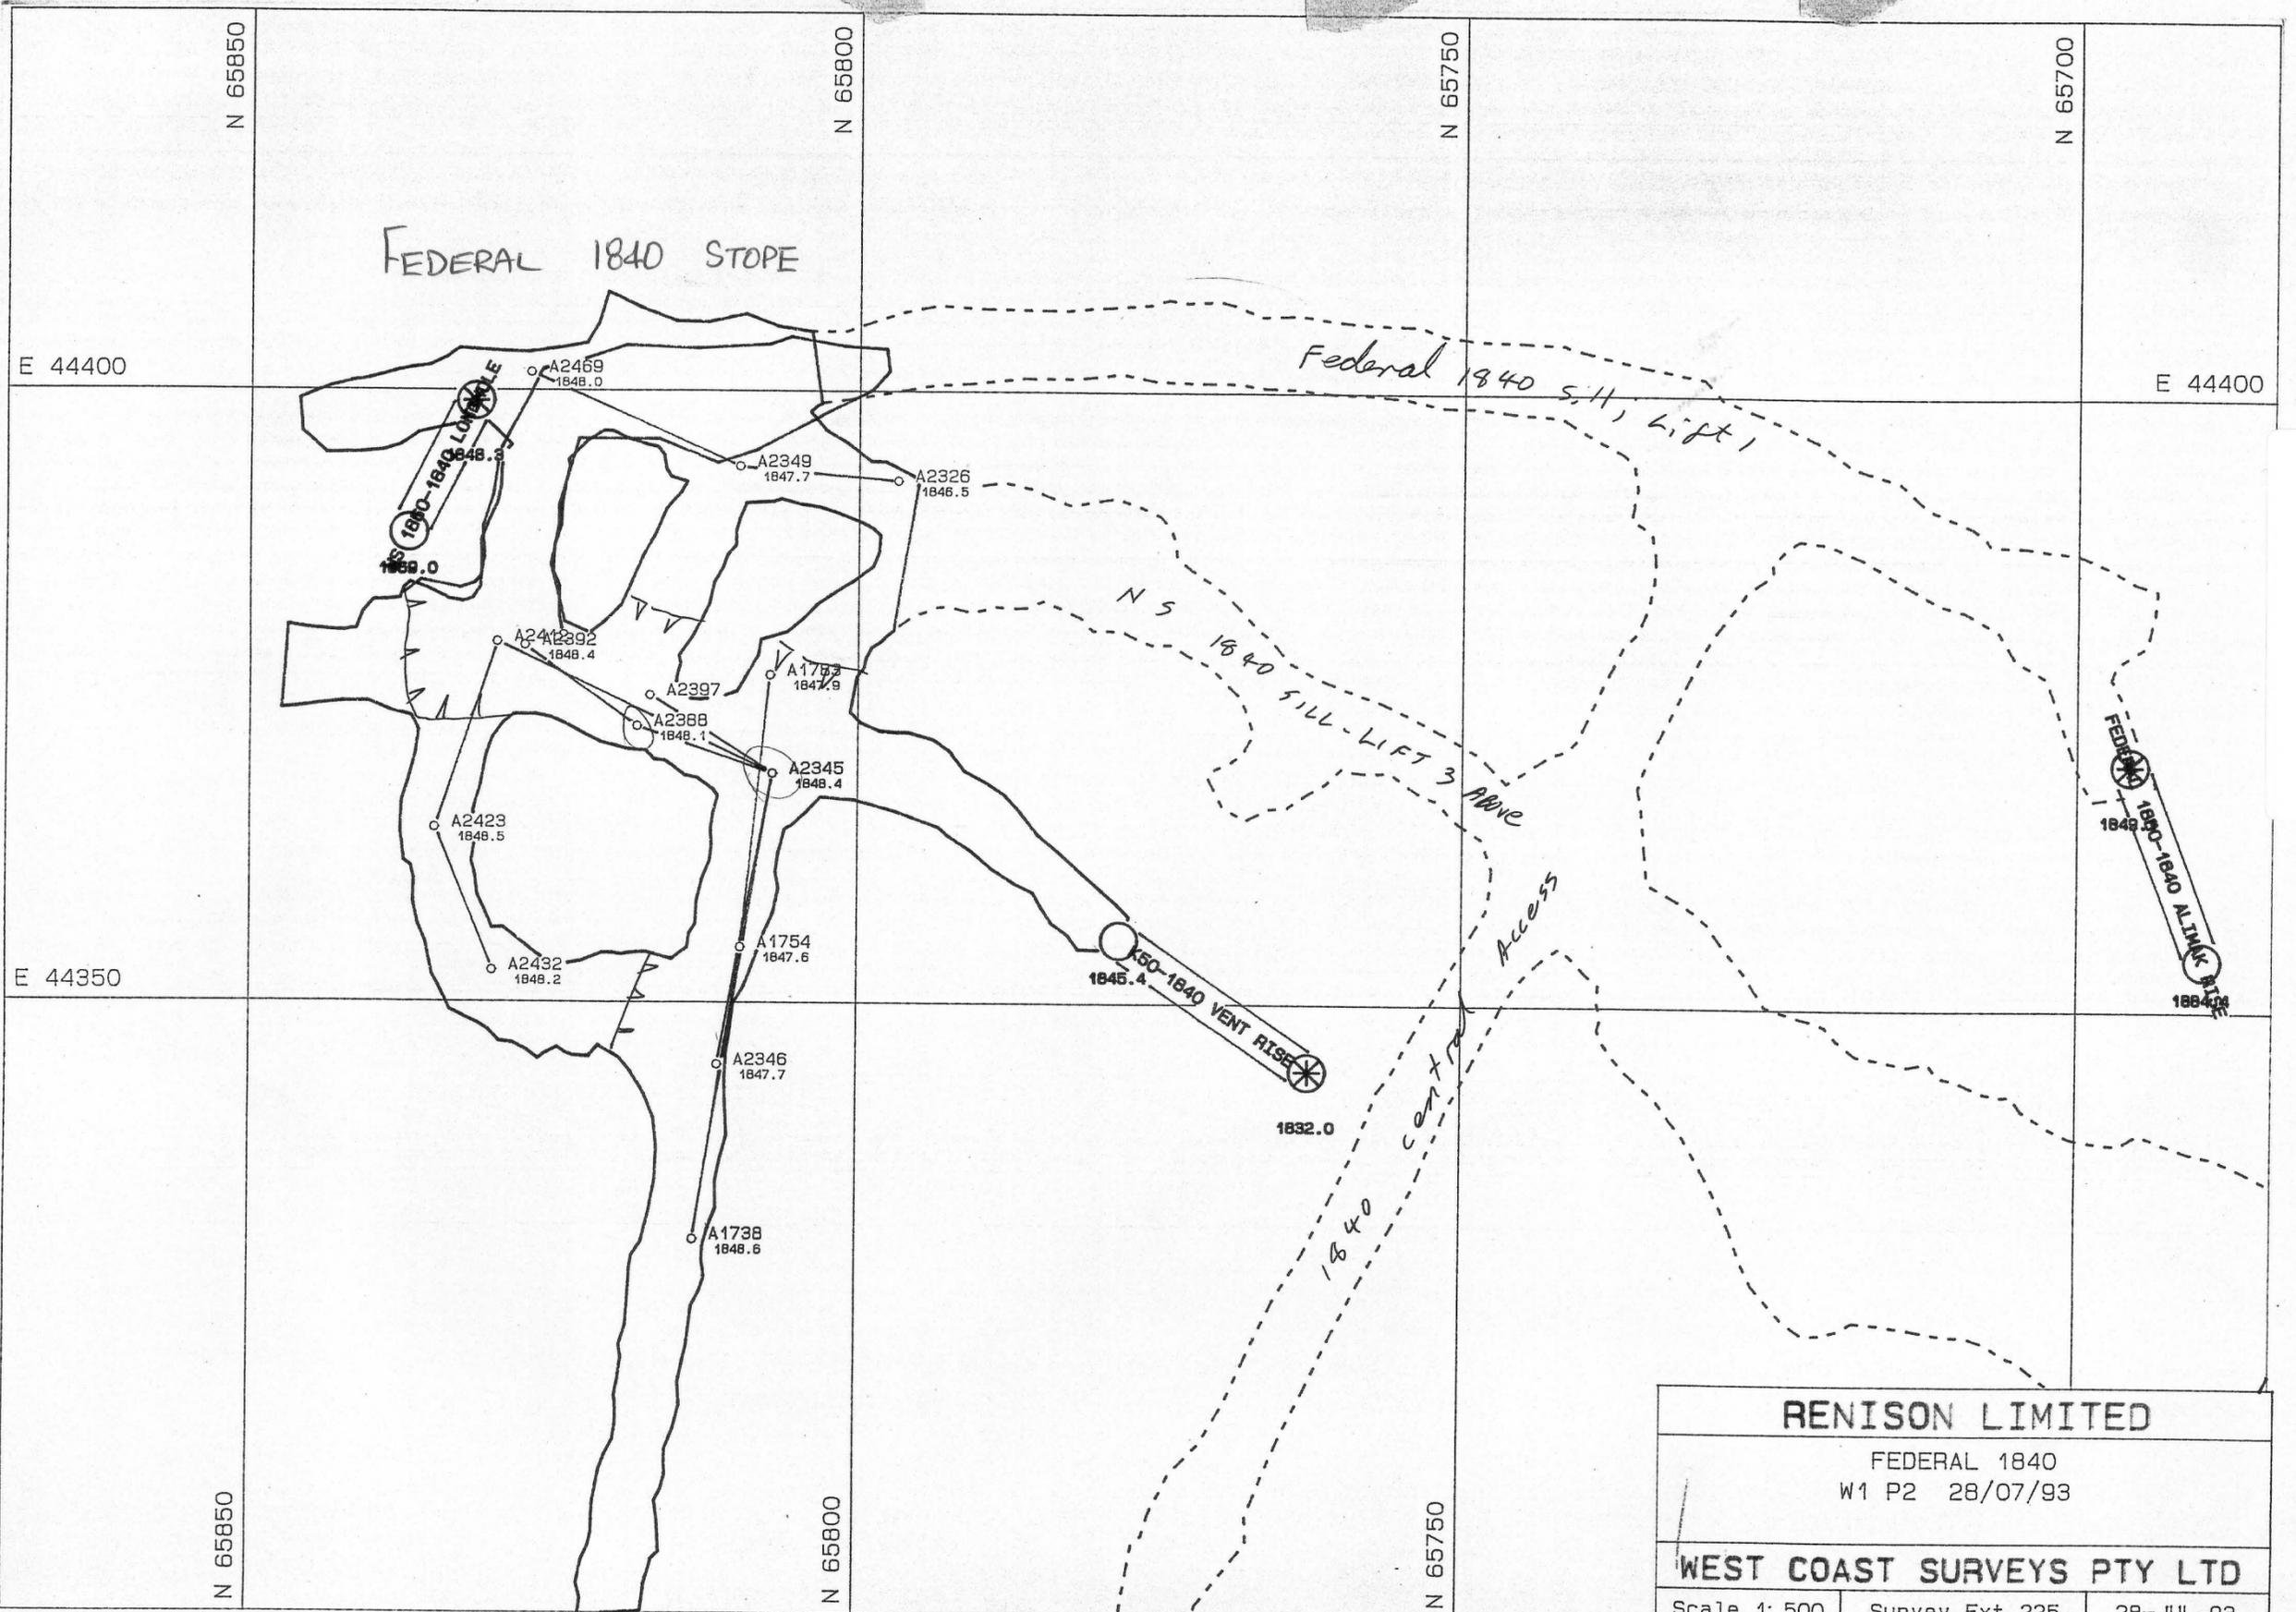

5 cm

|                                   |                |           |
|-----------------------------------|----------------|-----------|
| <b>RENISON LIMITED</b>            |                |           |
| FEDERAL 1840<br>W1 P2 28/07/93    |                |           |
| <b>WEST COAST SURVEYS PTY LTD</b> |                |           |
| Scale 1: 500                      | Survey Ext 225 | 28-JUL-93 |