


0376-132

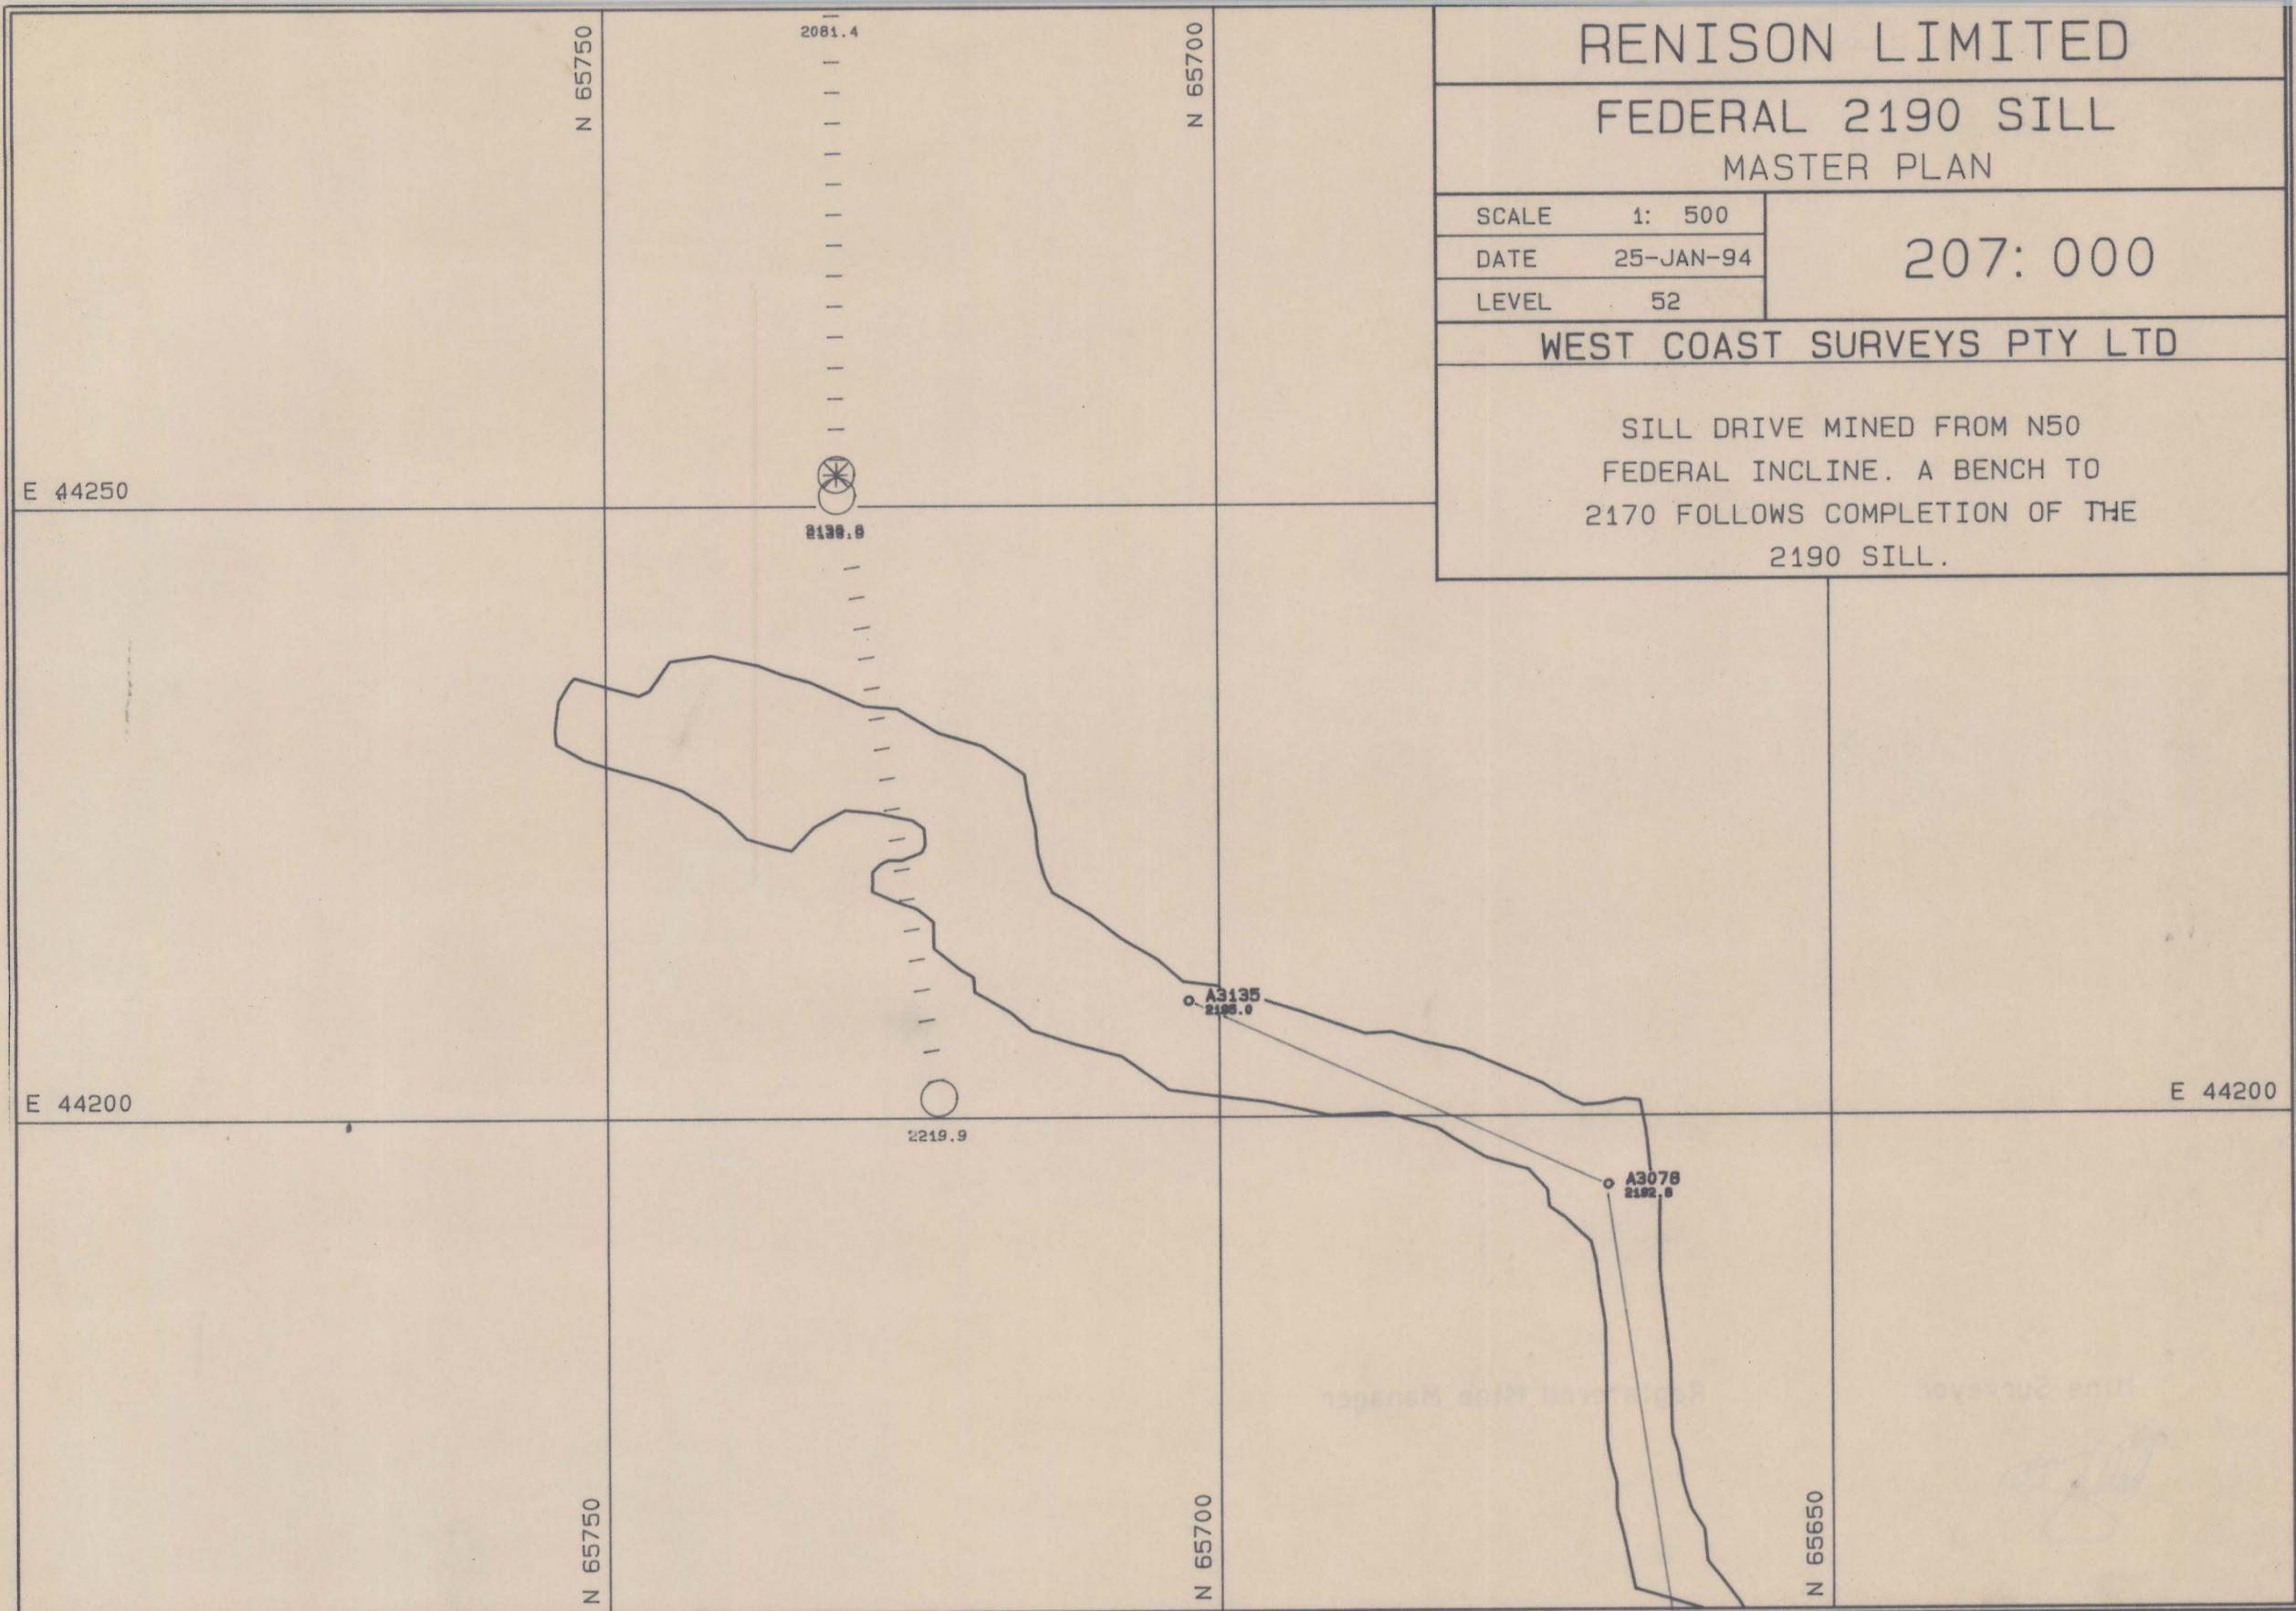

RENISON LIMITED	
FEDERAL 2190 SILL	
MASTER PLAN	
SCALE 1: 500	207: 000
DATE 25-JAN-94	
LEVEL 52	
WEST COAST SURVEYS PTY LTD	
<p>SILL DRIVE MINED FROM N50 FEDERAL INCLINE. A BENCH TO 2170 FOLLOWS COMPLETION OF THE 2190 SILL.</p>	

MASTE.A.PF