


0376-134

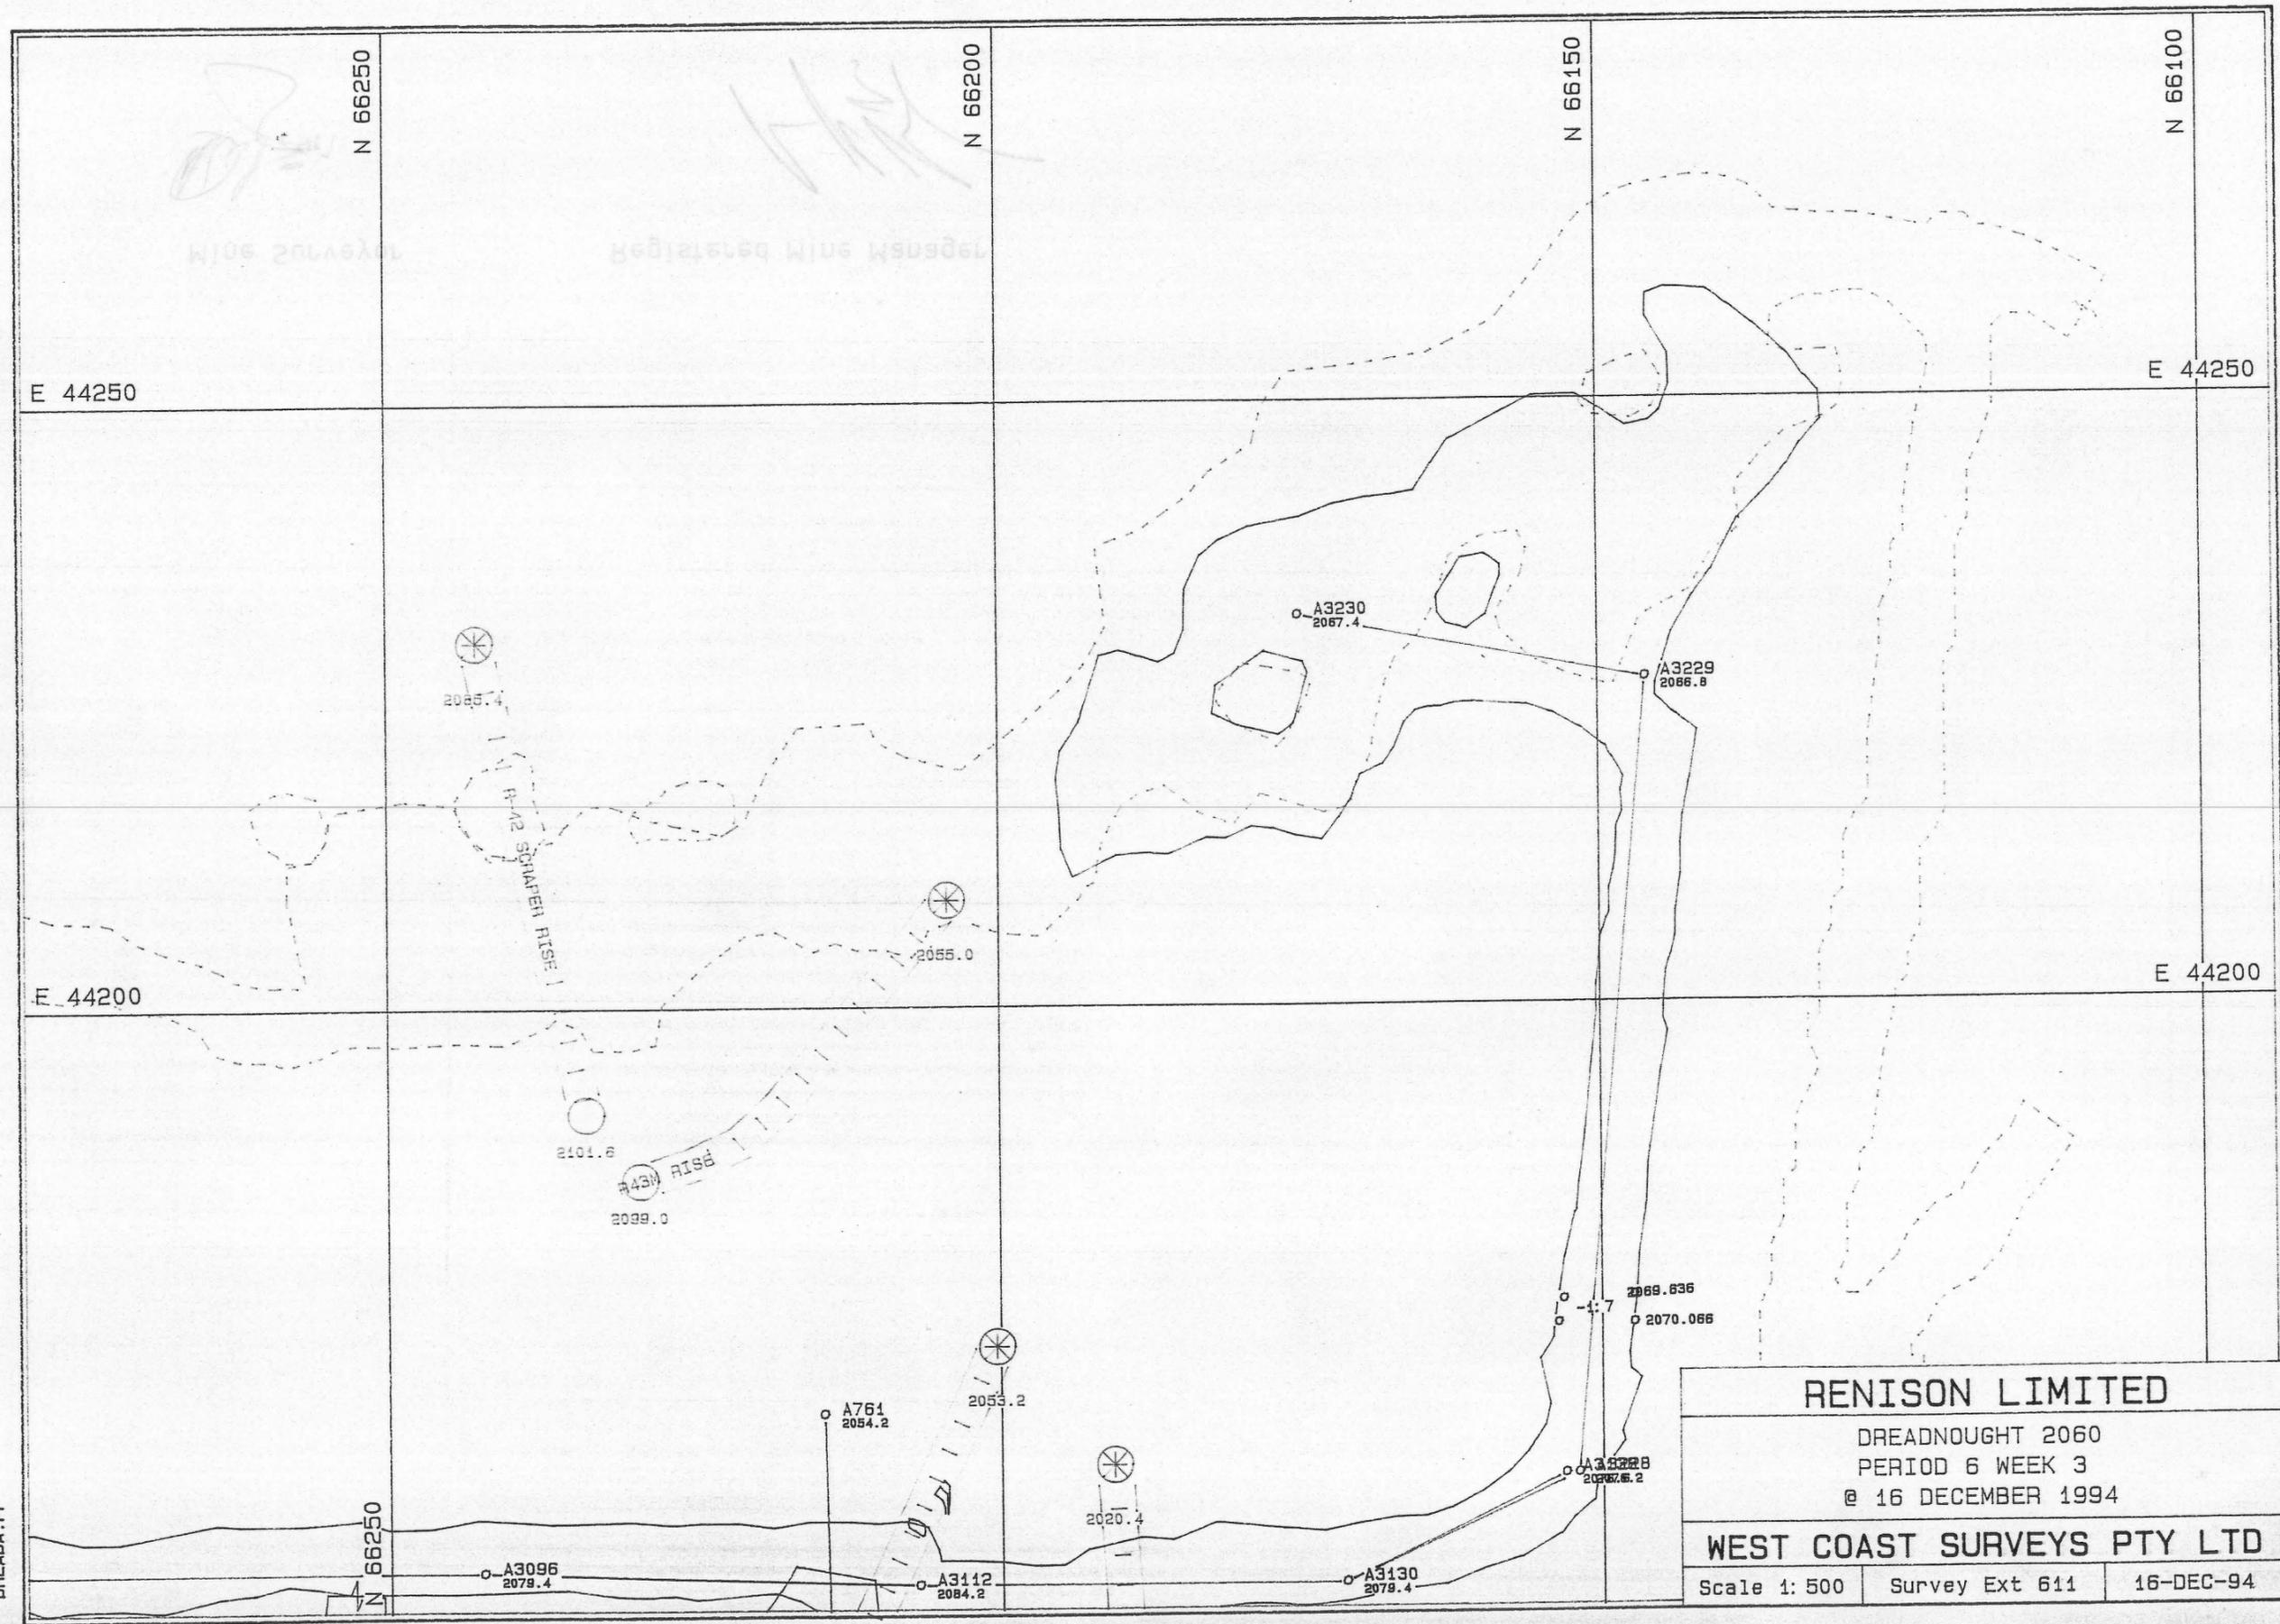

<b>RENISON LIMITED</b>		
DREADNOUGHT 2060		
PERIOD 6 WEEK 3		
@ 16 DECEMBER 1994		
<b>WEST COAST SURVEYS PTY LTD</b>		
Scale 1: 500	Survey Ext 611	16-DEC-94

DREADA.PF