


0376-135

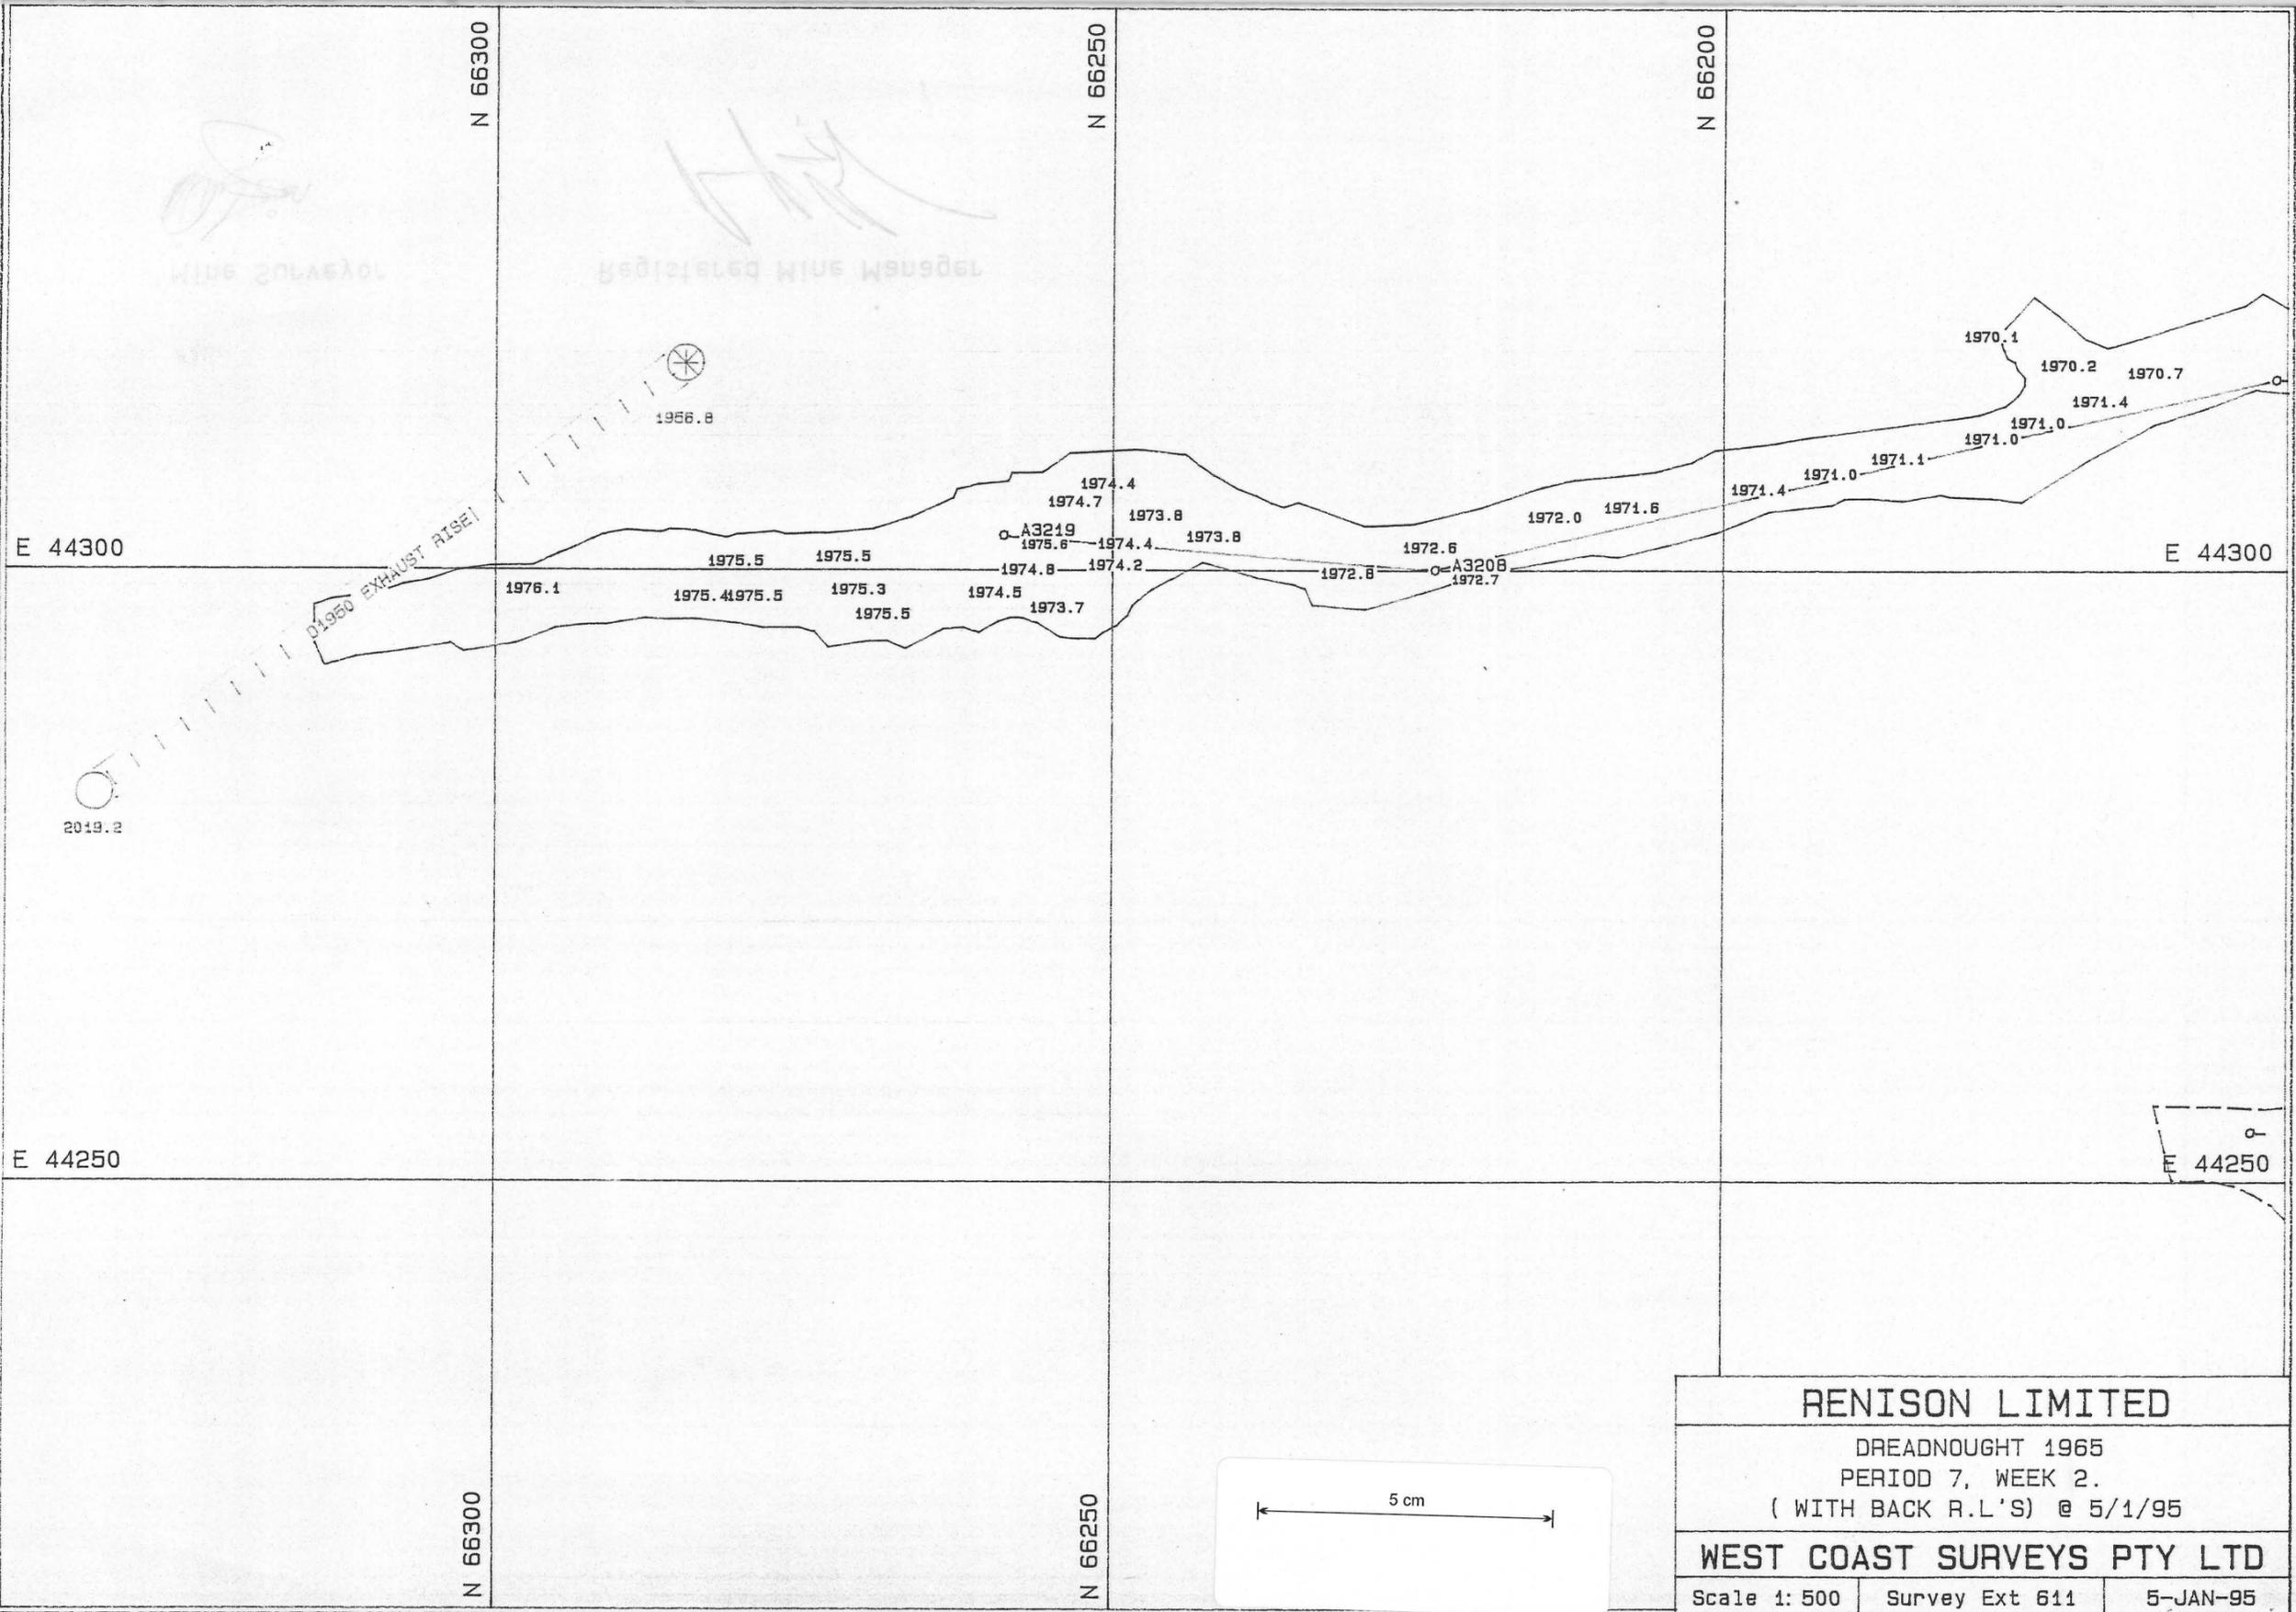

RENISON LIMITED		
DREADNOUGHT 1965 PERIOD 7, WEEK 2. (WITH BACK R.L.'S) @ 5/1/95		
WEST COAST SURVEYS PTY LTD		
Scale 1: 500	Survey Ext 611	5-JAN-95

DREADC.PF