


0376-136

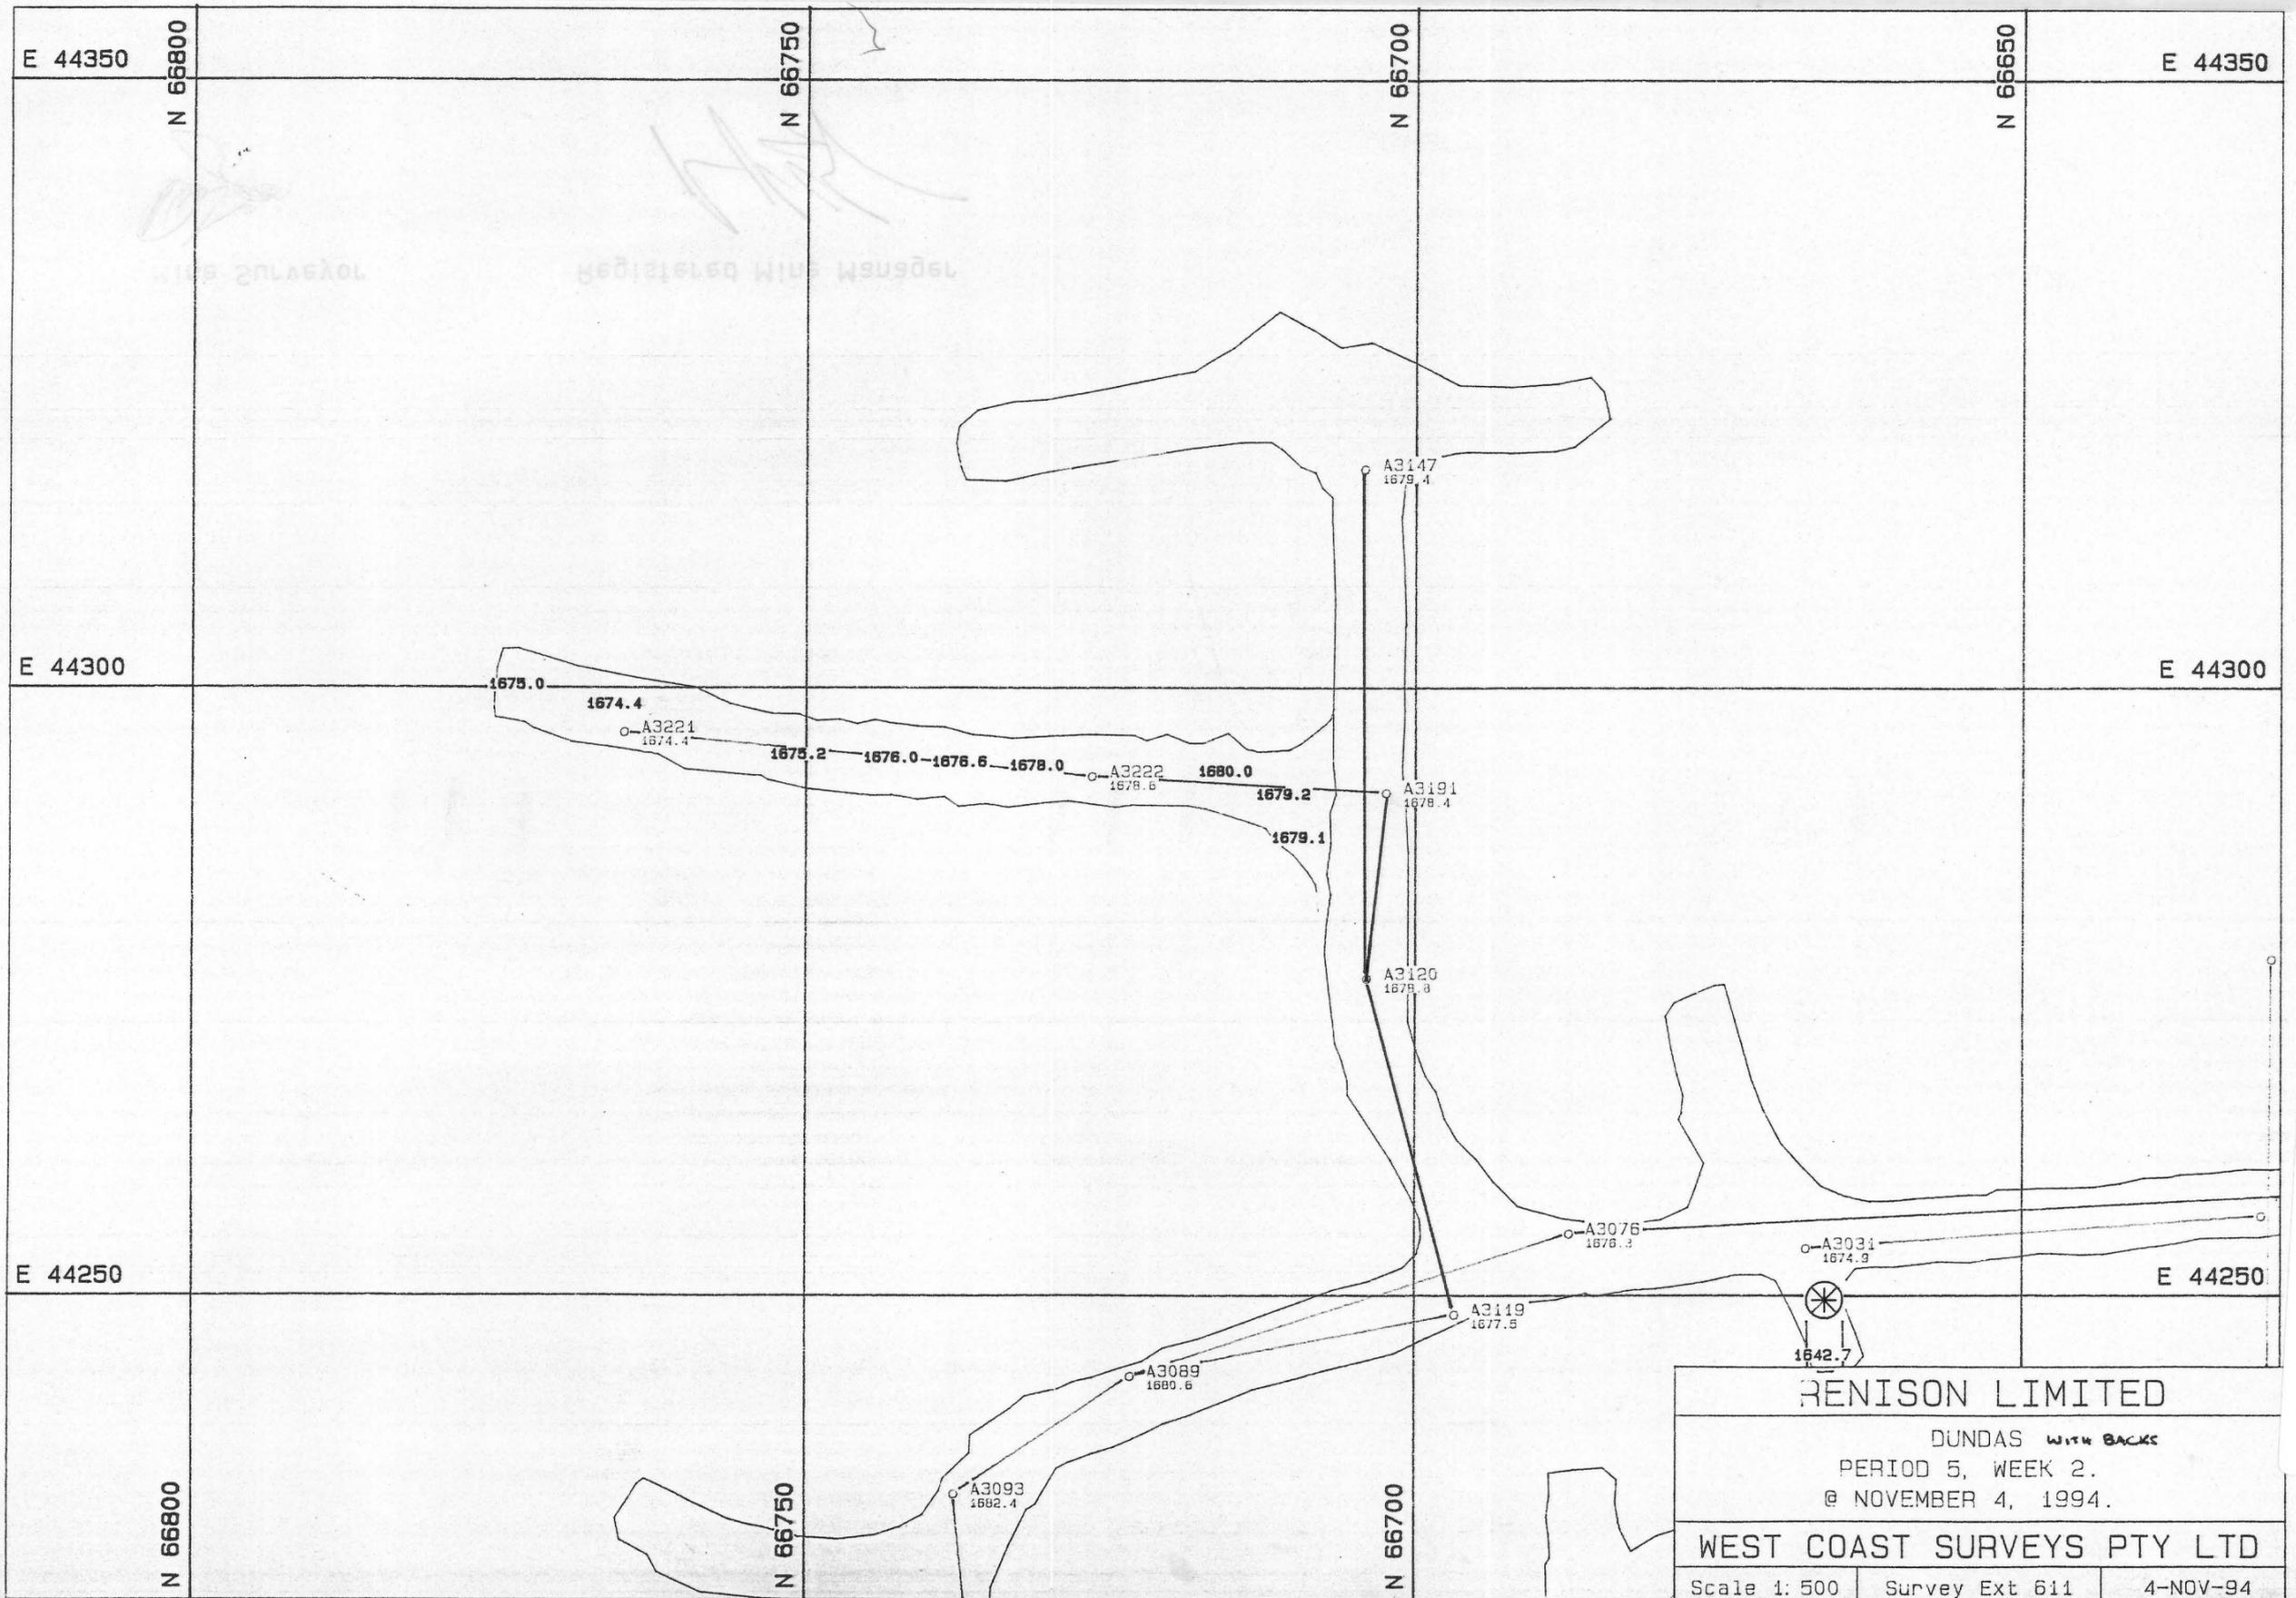

DUNDAS.PF