
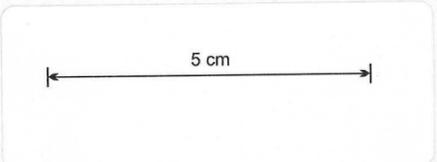


0376-137

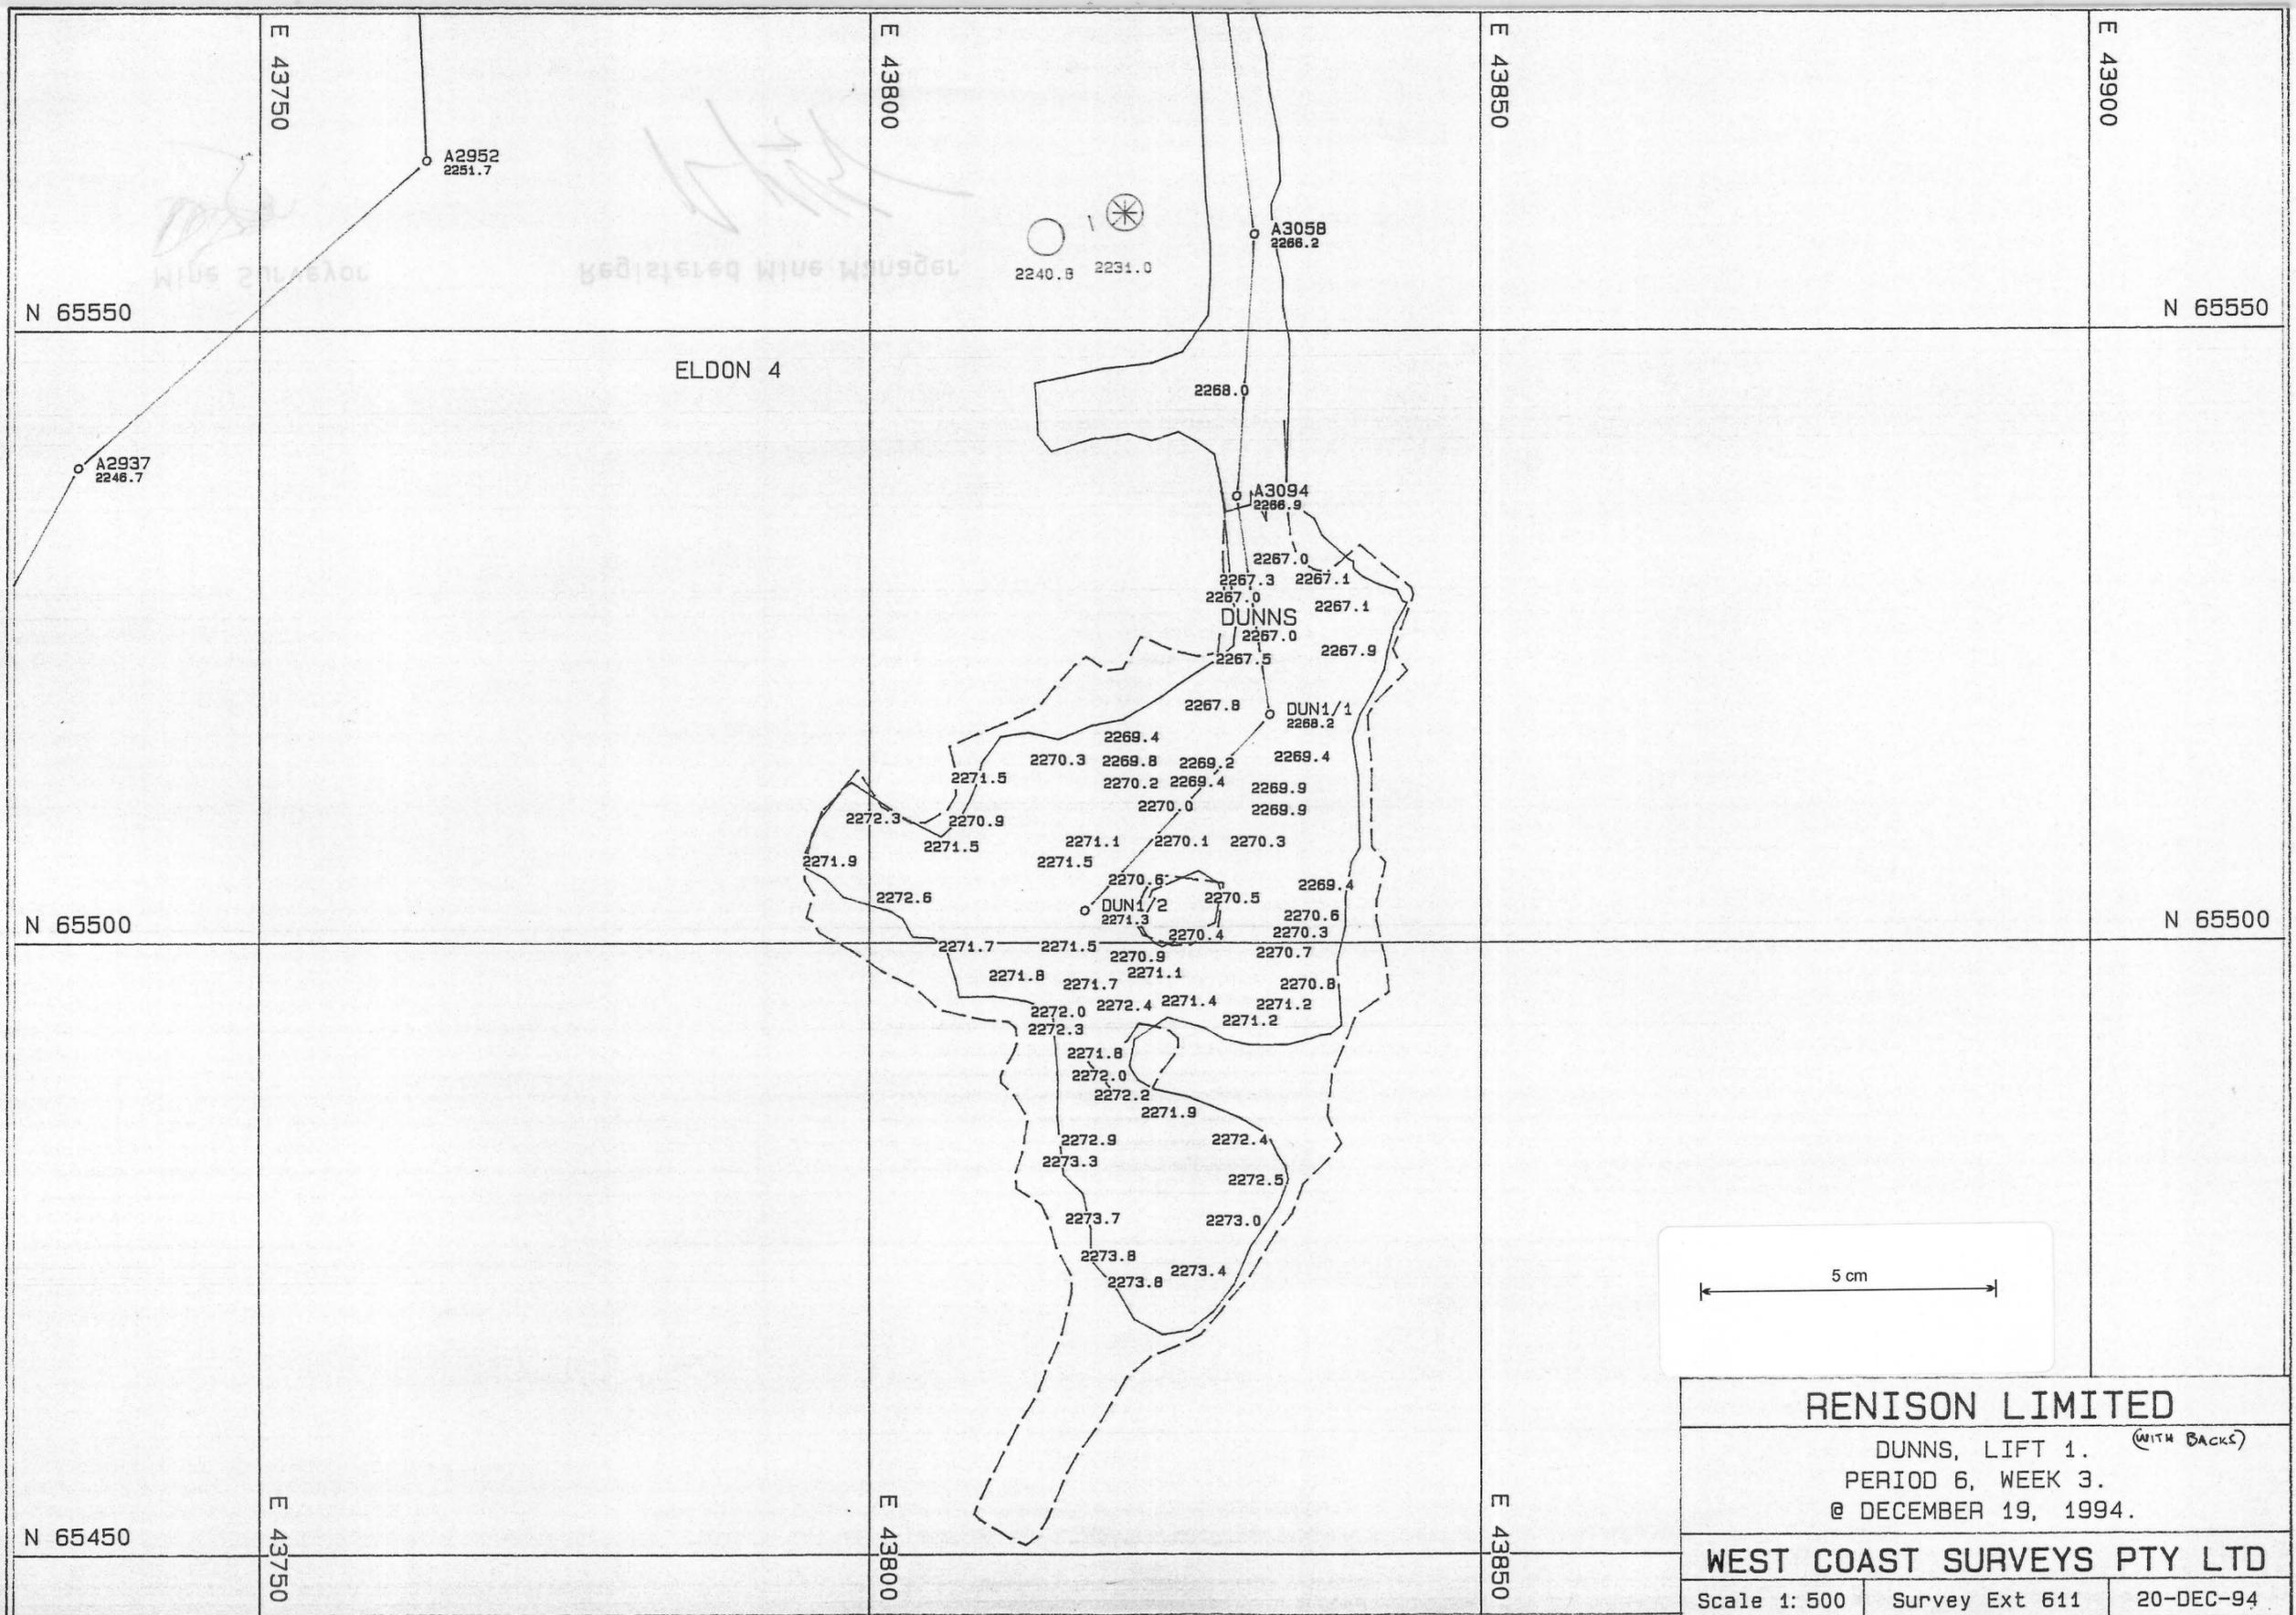

<b>RENISON LIMITED</b>		
DUNNS, LIFT 1. (WITH BACKS)		
PERIOD 6, WEEK 3.		
@ DECEMBER 19, 1994.		
<b>WEST COAST SURVEYS PTY LTD</b>		
Scale 1:500	Survey Ext 611	20-DEC-94

DUNNSD.PF