


0376 - 138

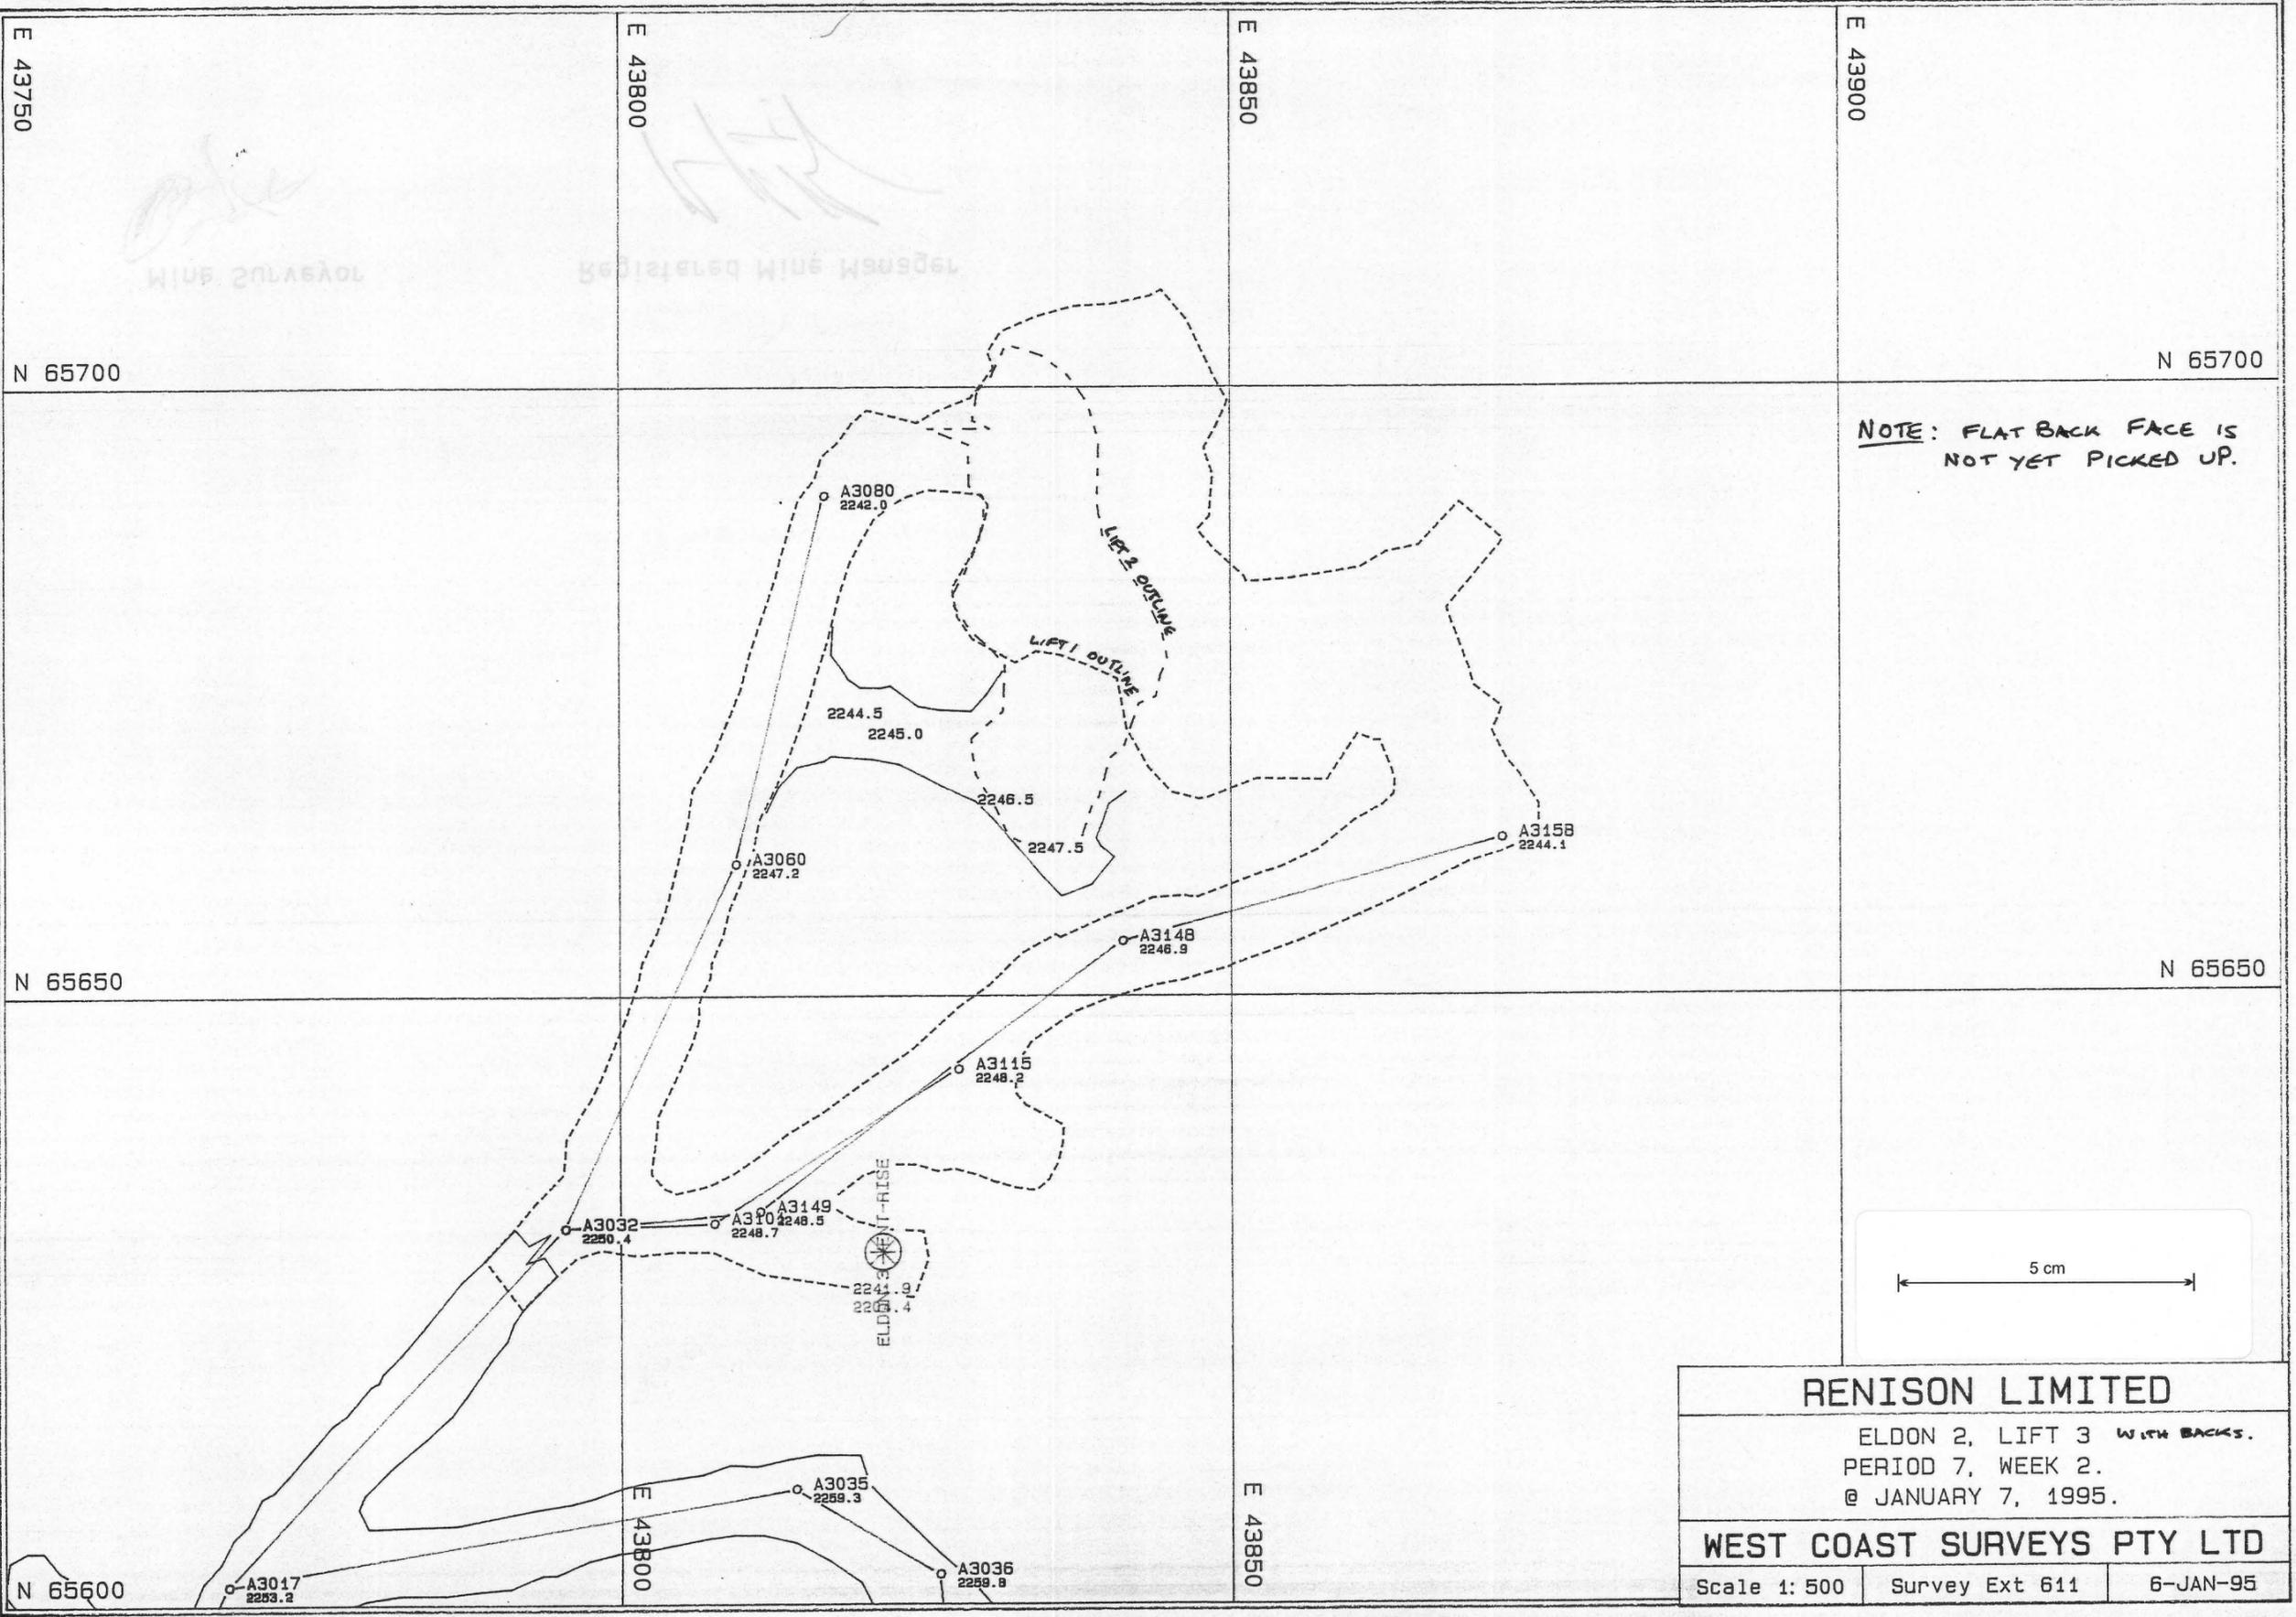

NOTE: FLAT BACK FACE IS NOT YET PICKED UP.

RENISON LIMITED

ELDON 2, LIFT 3 WITH BACKS.
PERIOD 7, WEEK 2.
@ JANUARY 7, 1995.

WEST COAST SURVEYS PTY LTD

Scale 1: 500 | Survey Ext 611 | 6-JAN-95

ELDONB.PF