
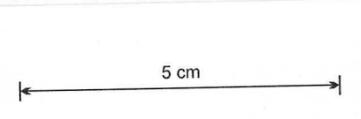


0376-139

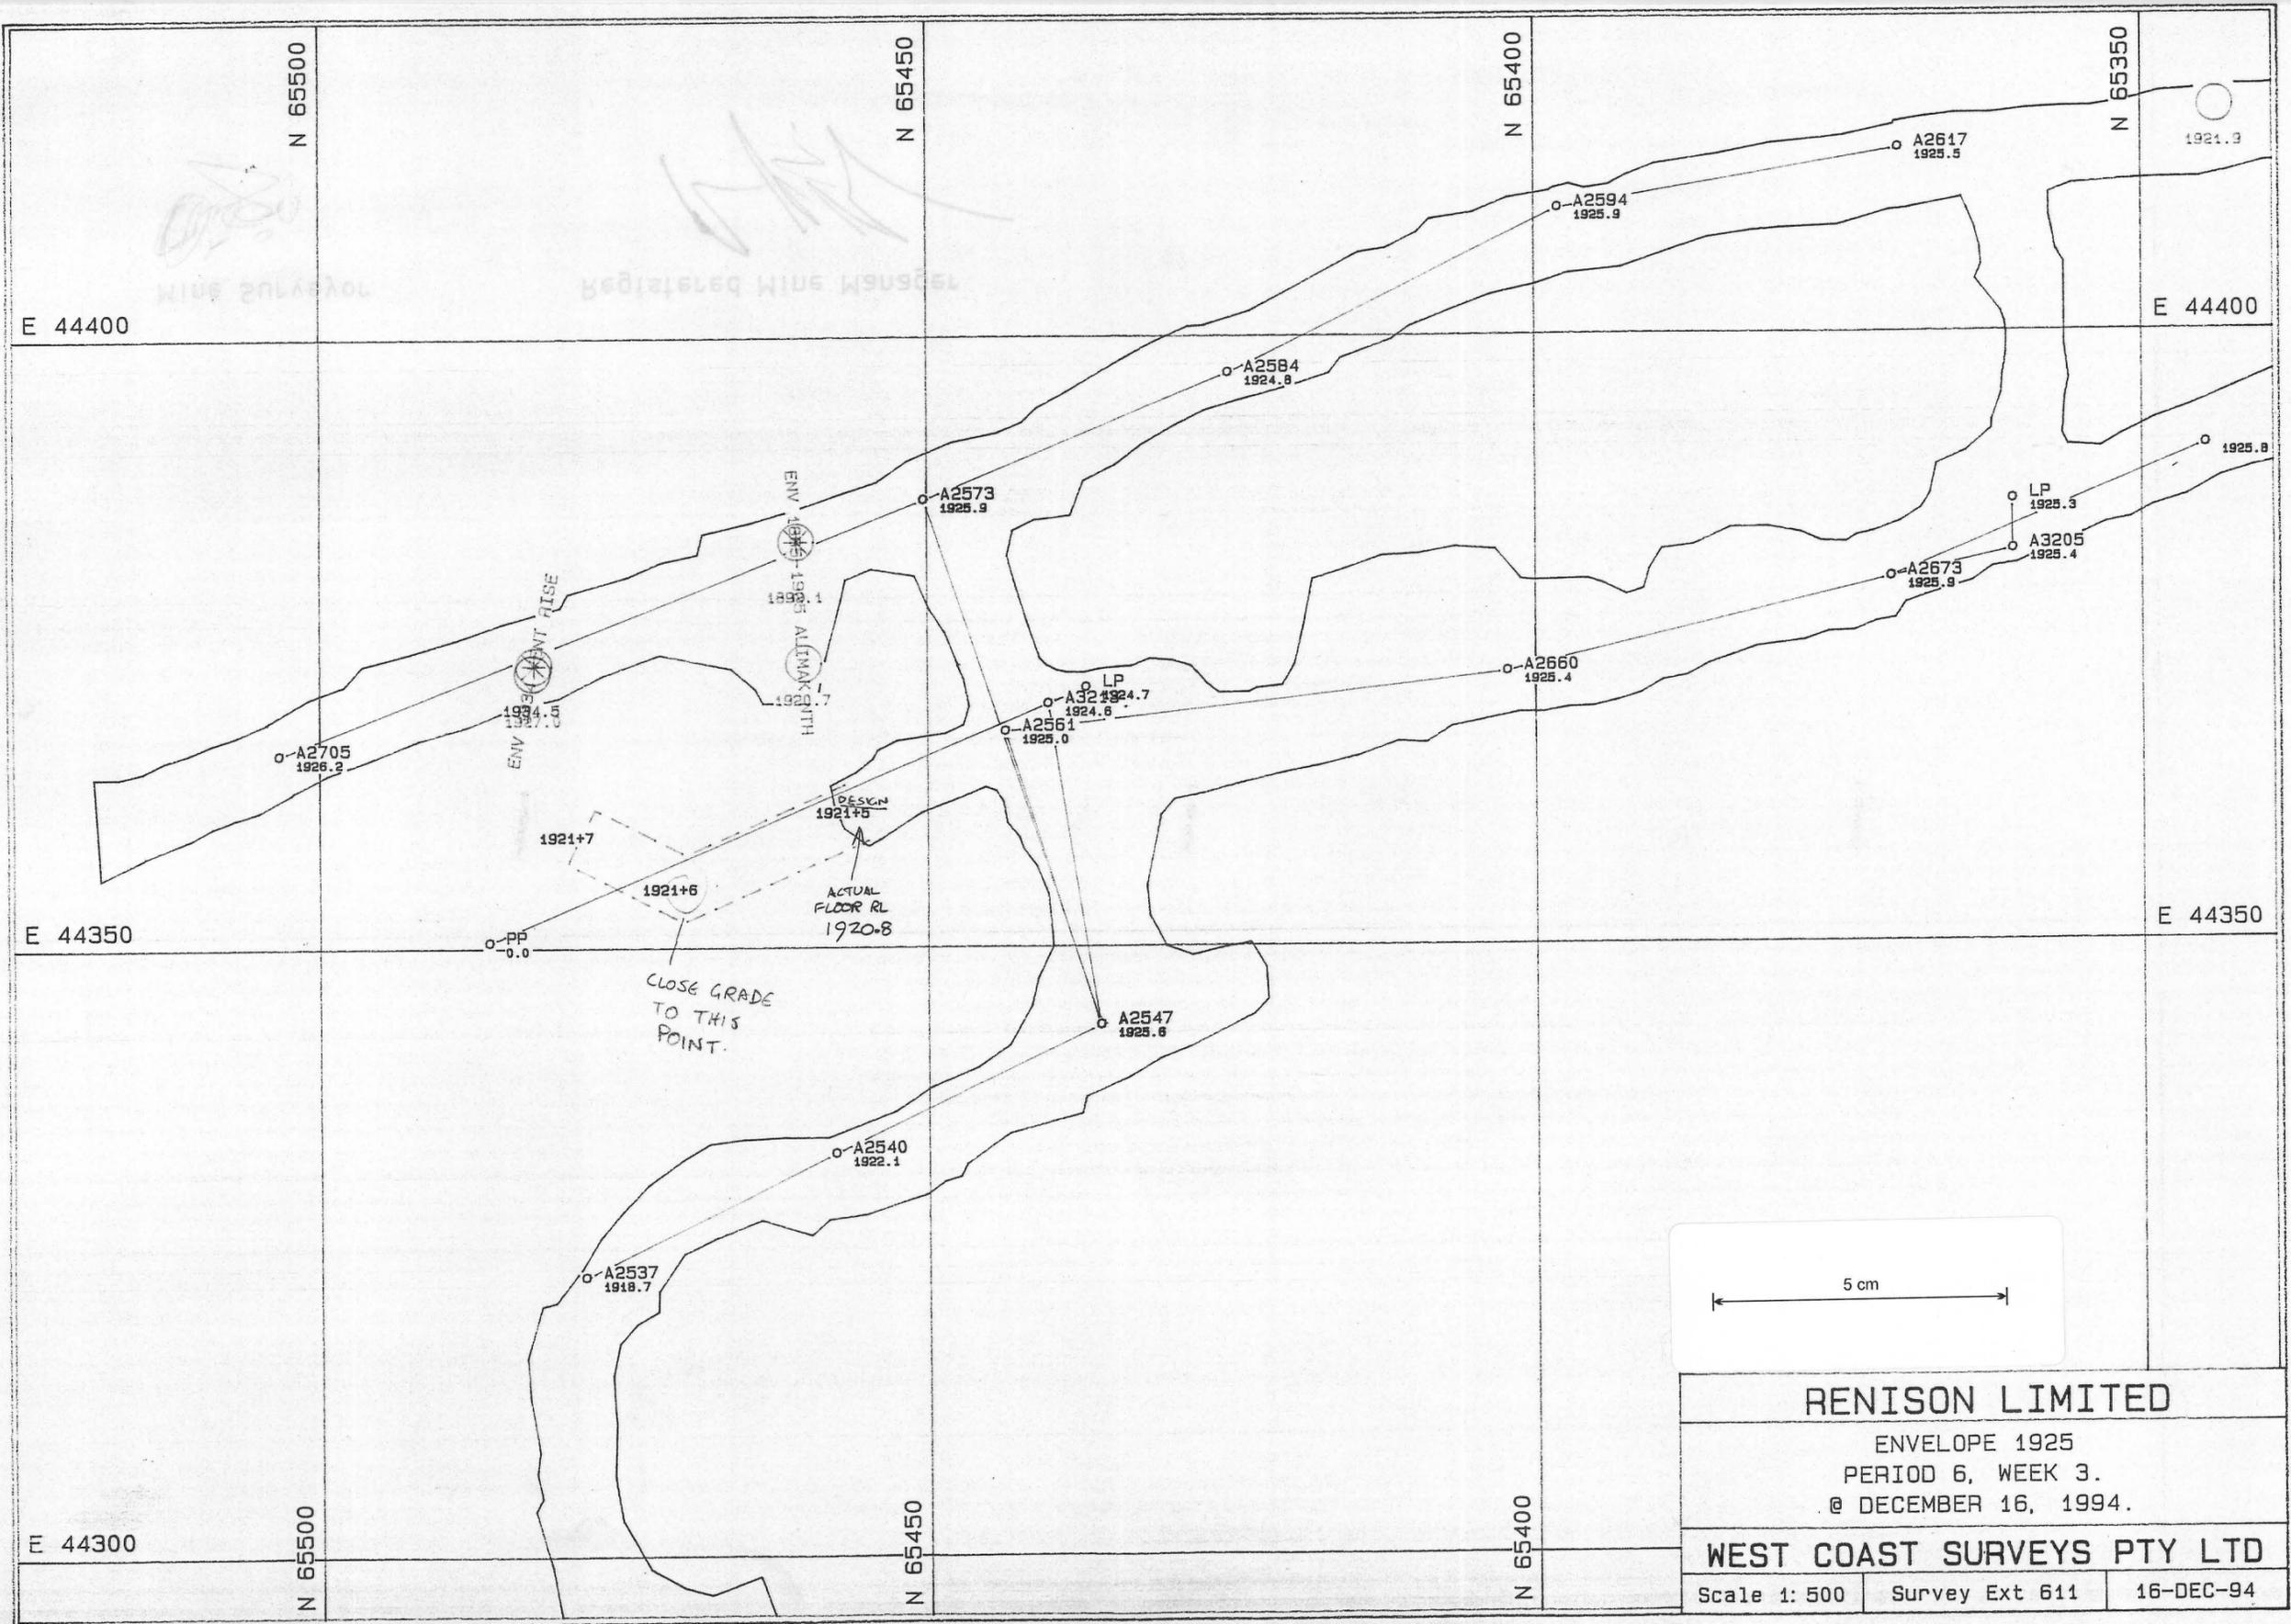

RENISON LIMITED		
ENVELOPE 1925 PERIOD 6, WEEK 3. @ DECEMBER 16, 1994.		
WEST COAST SURVEYS PTY LTD		
Scale 1: 500	Survey Ext 611	16-DEC-94

ENVELOPE.PF