


0376 - 140

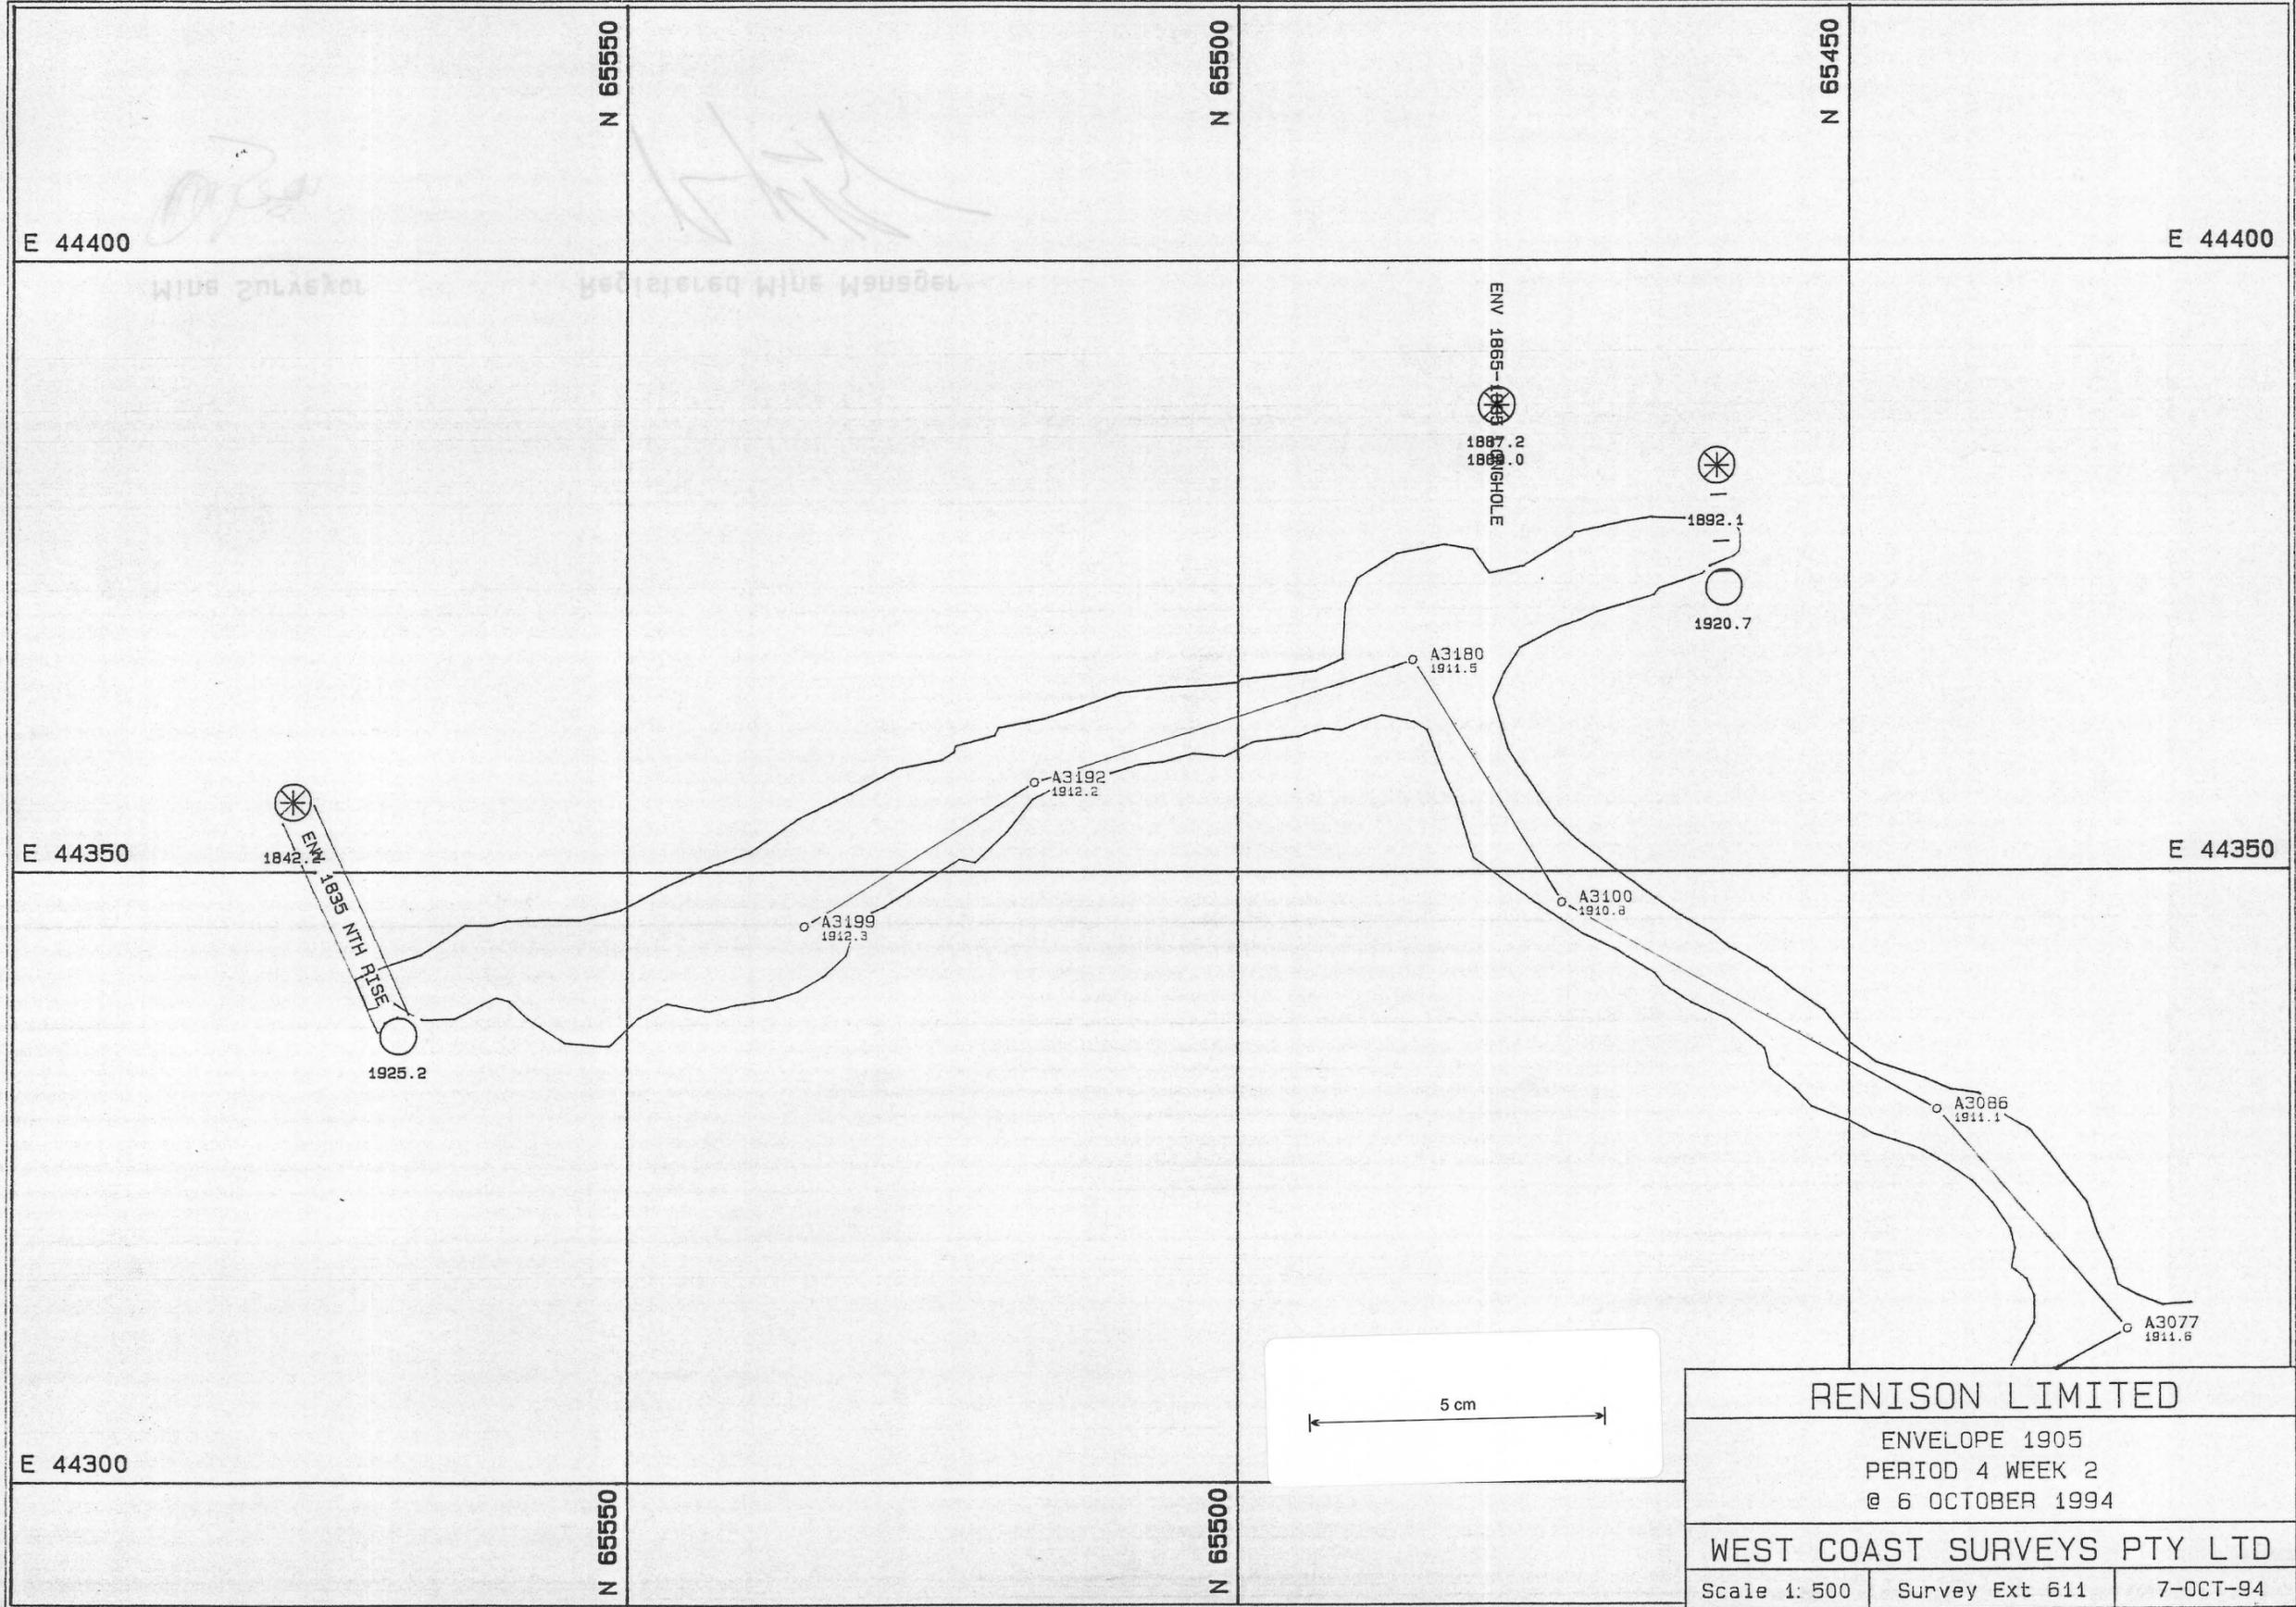

RENISON LIMITED		
ENVELOPE 1905		
PERIOD 4 WEEK 2		
@ 6 OCTOBER 1994		
WEST COAST SURVEYS PTY LTD		
Scale 1: 500	Survey Ext 611	7-OCT-94

ENVELOPE.PF