


0376-141

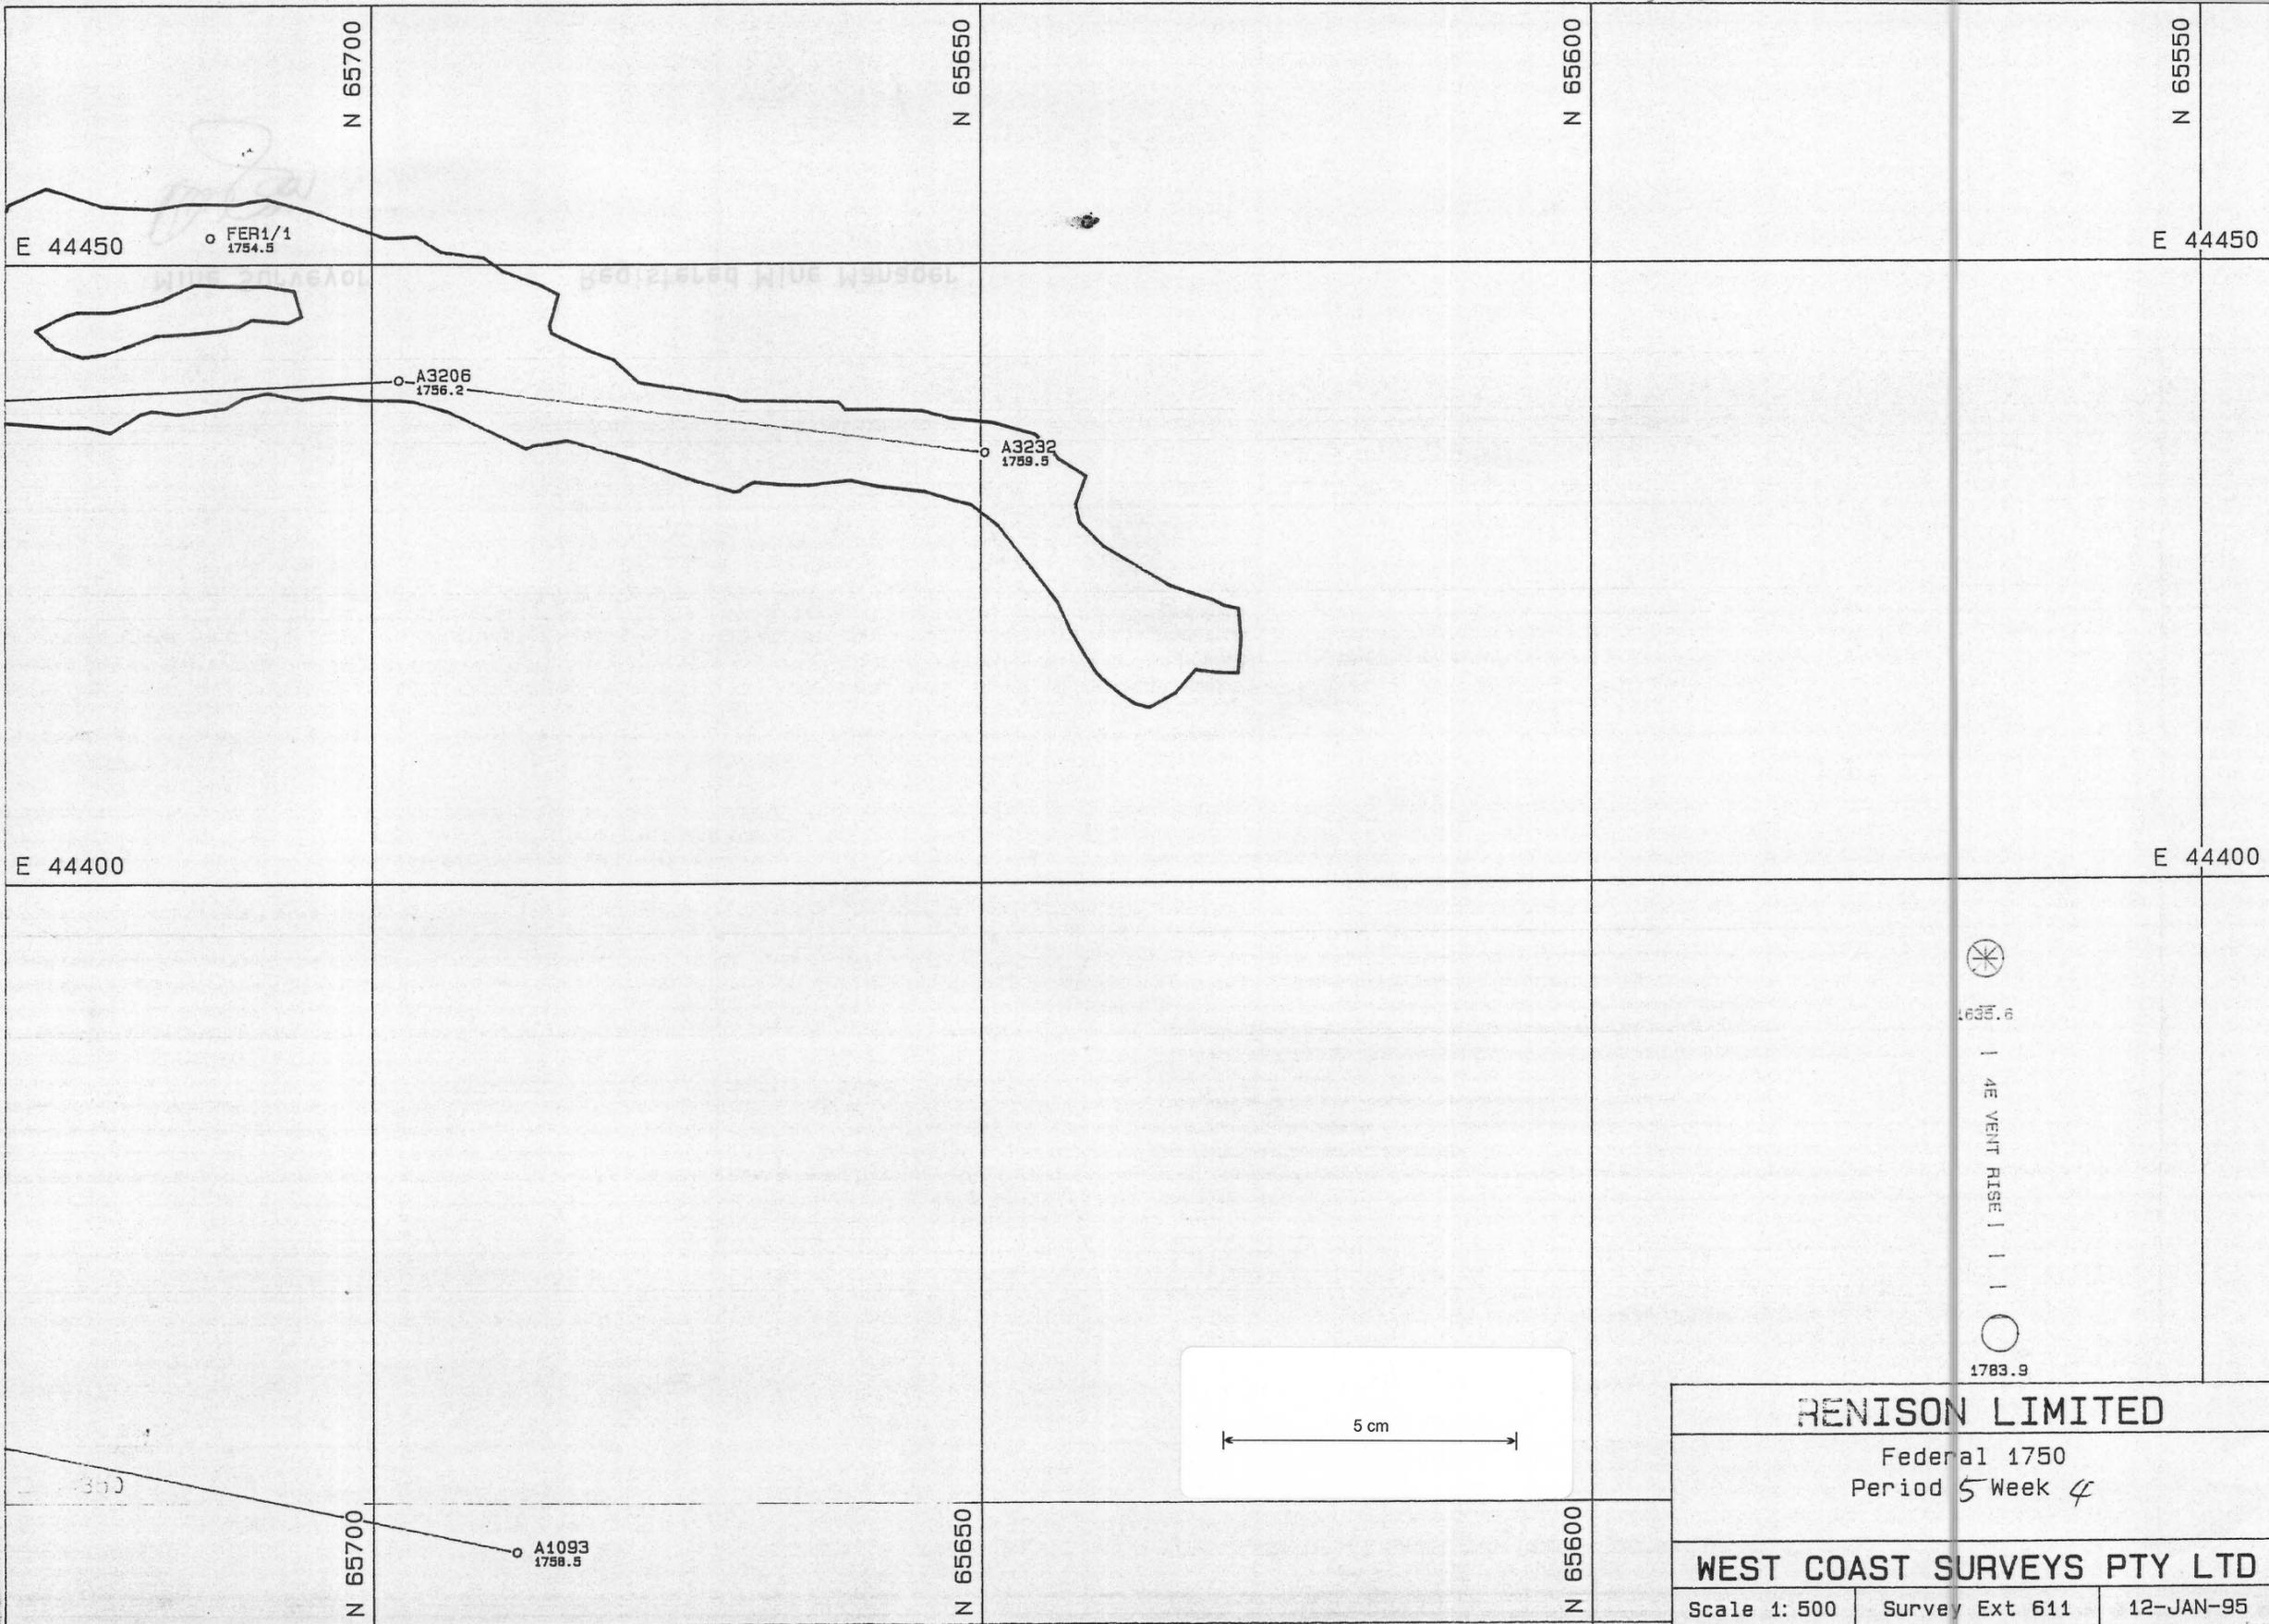

  
 1753.8  
 1/4" VENT RISE 1 1 1  
  
 1783.9

5 cm

<b>RENISON LIMITED</b>		
Federal 1750 Period 5 Week 4		
<b>WEST COAST SURVEYS PTY LTD</b>		
Scale 1: 500	Survey Ext 611	12-JAN-95

FEDERC. PF