


0376-142

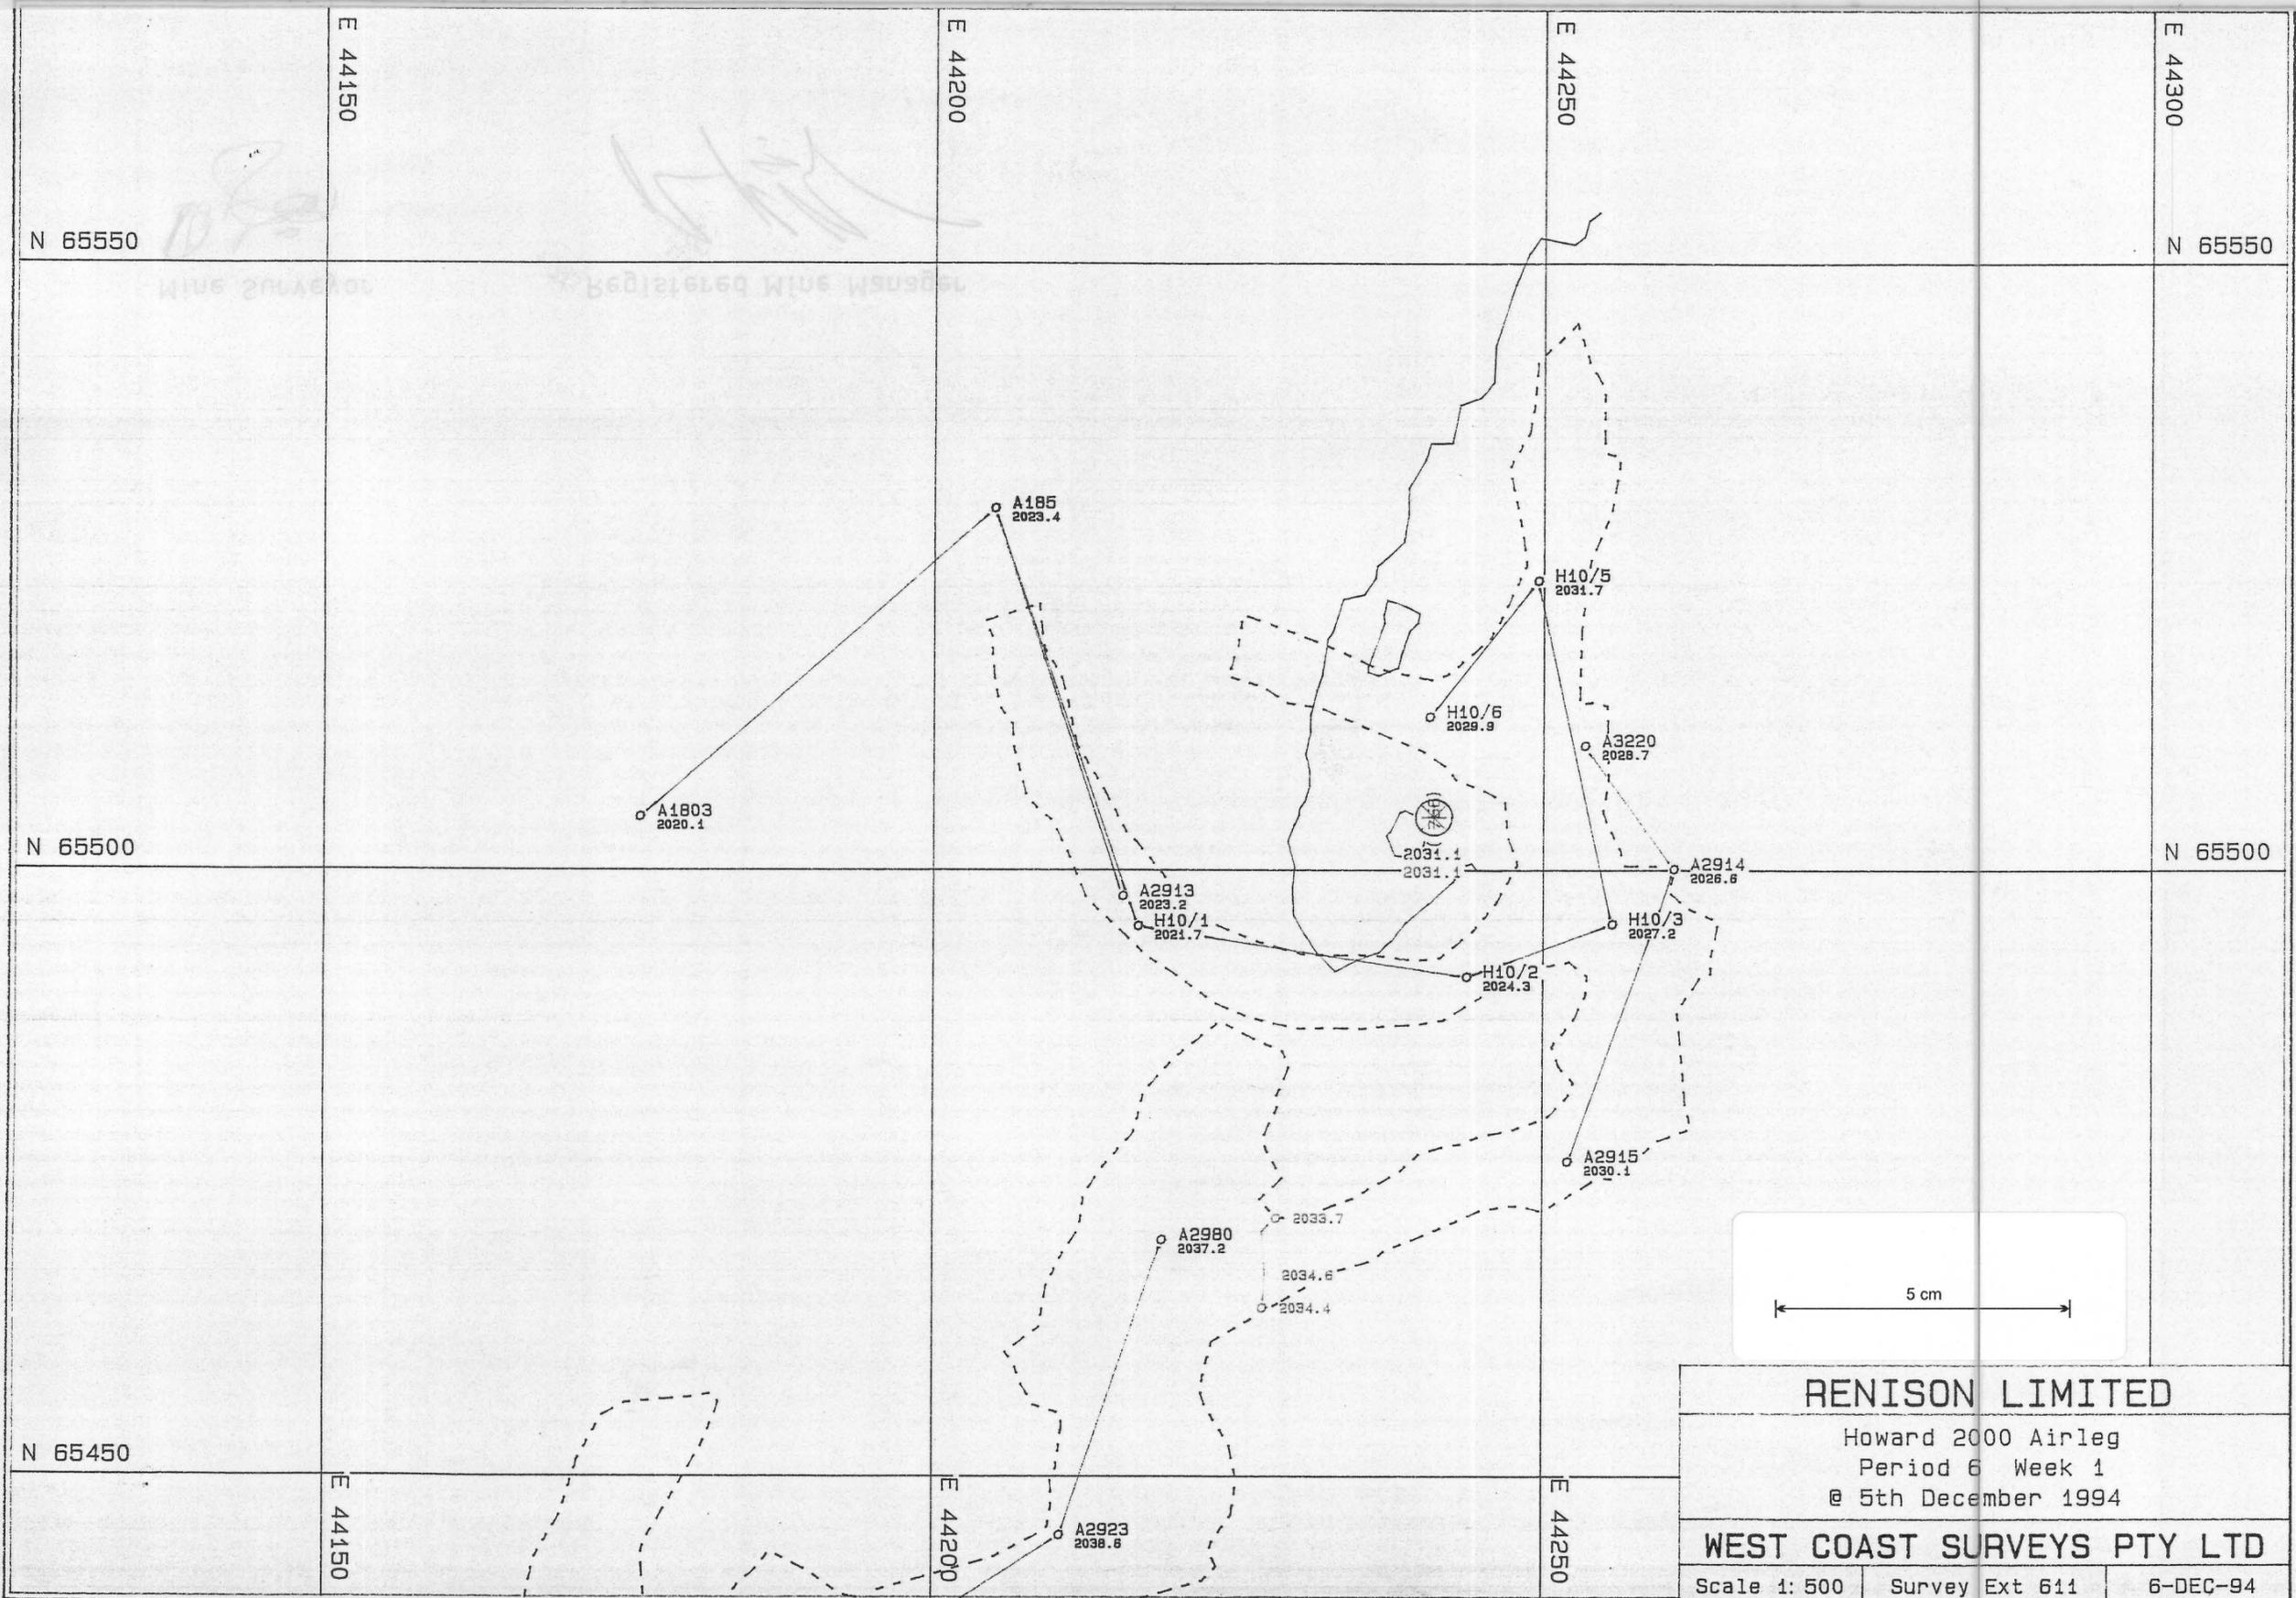

<b>RENISON LIMITED</b>		
Howard 2000 Airleg Period 6 Week 1 @ 5th December 1994		
<b>WEST COAST SURVEYS PTY LTD</b>		
Scale 1: 500	Survey Ext 611	6-DEC-94

HOWARE.PF