
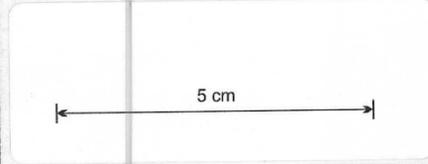


0376-143

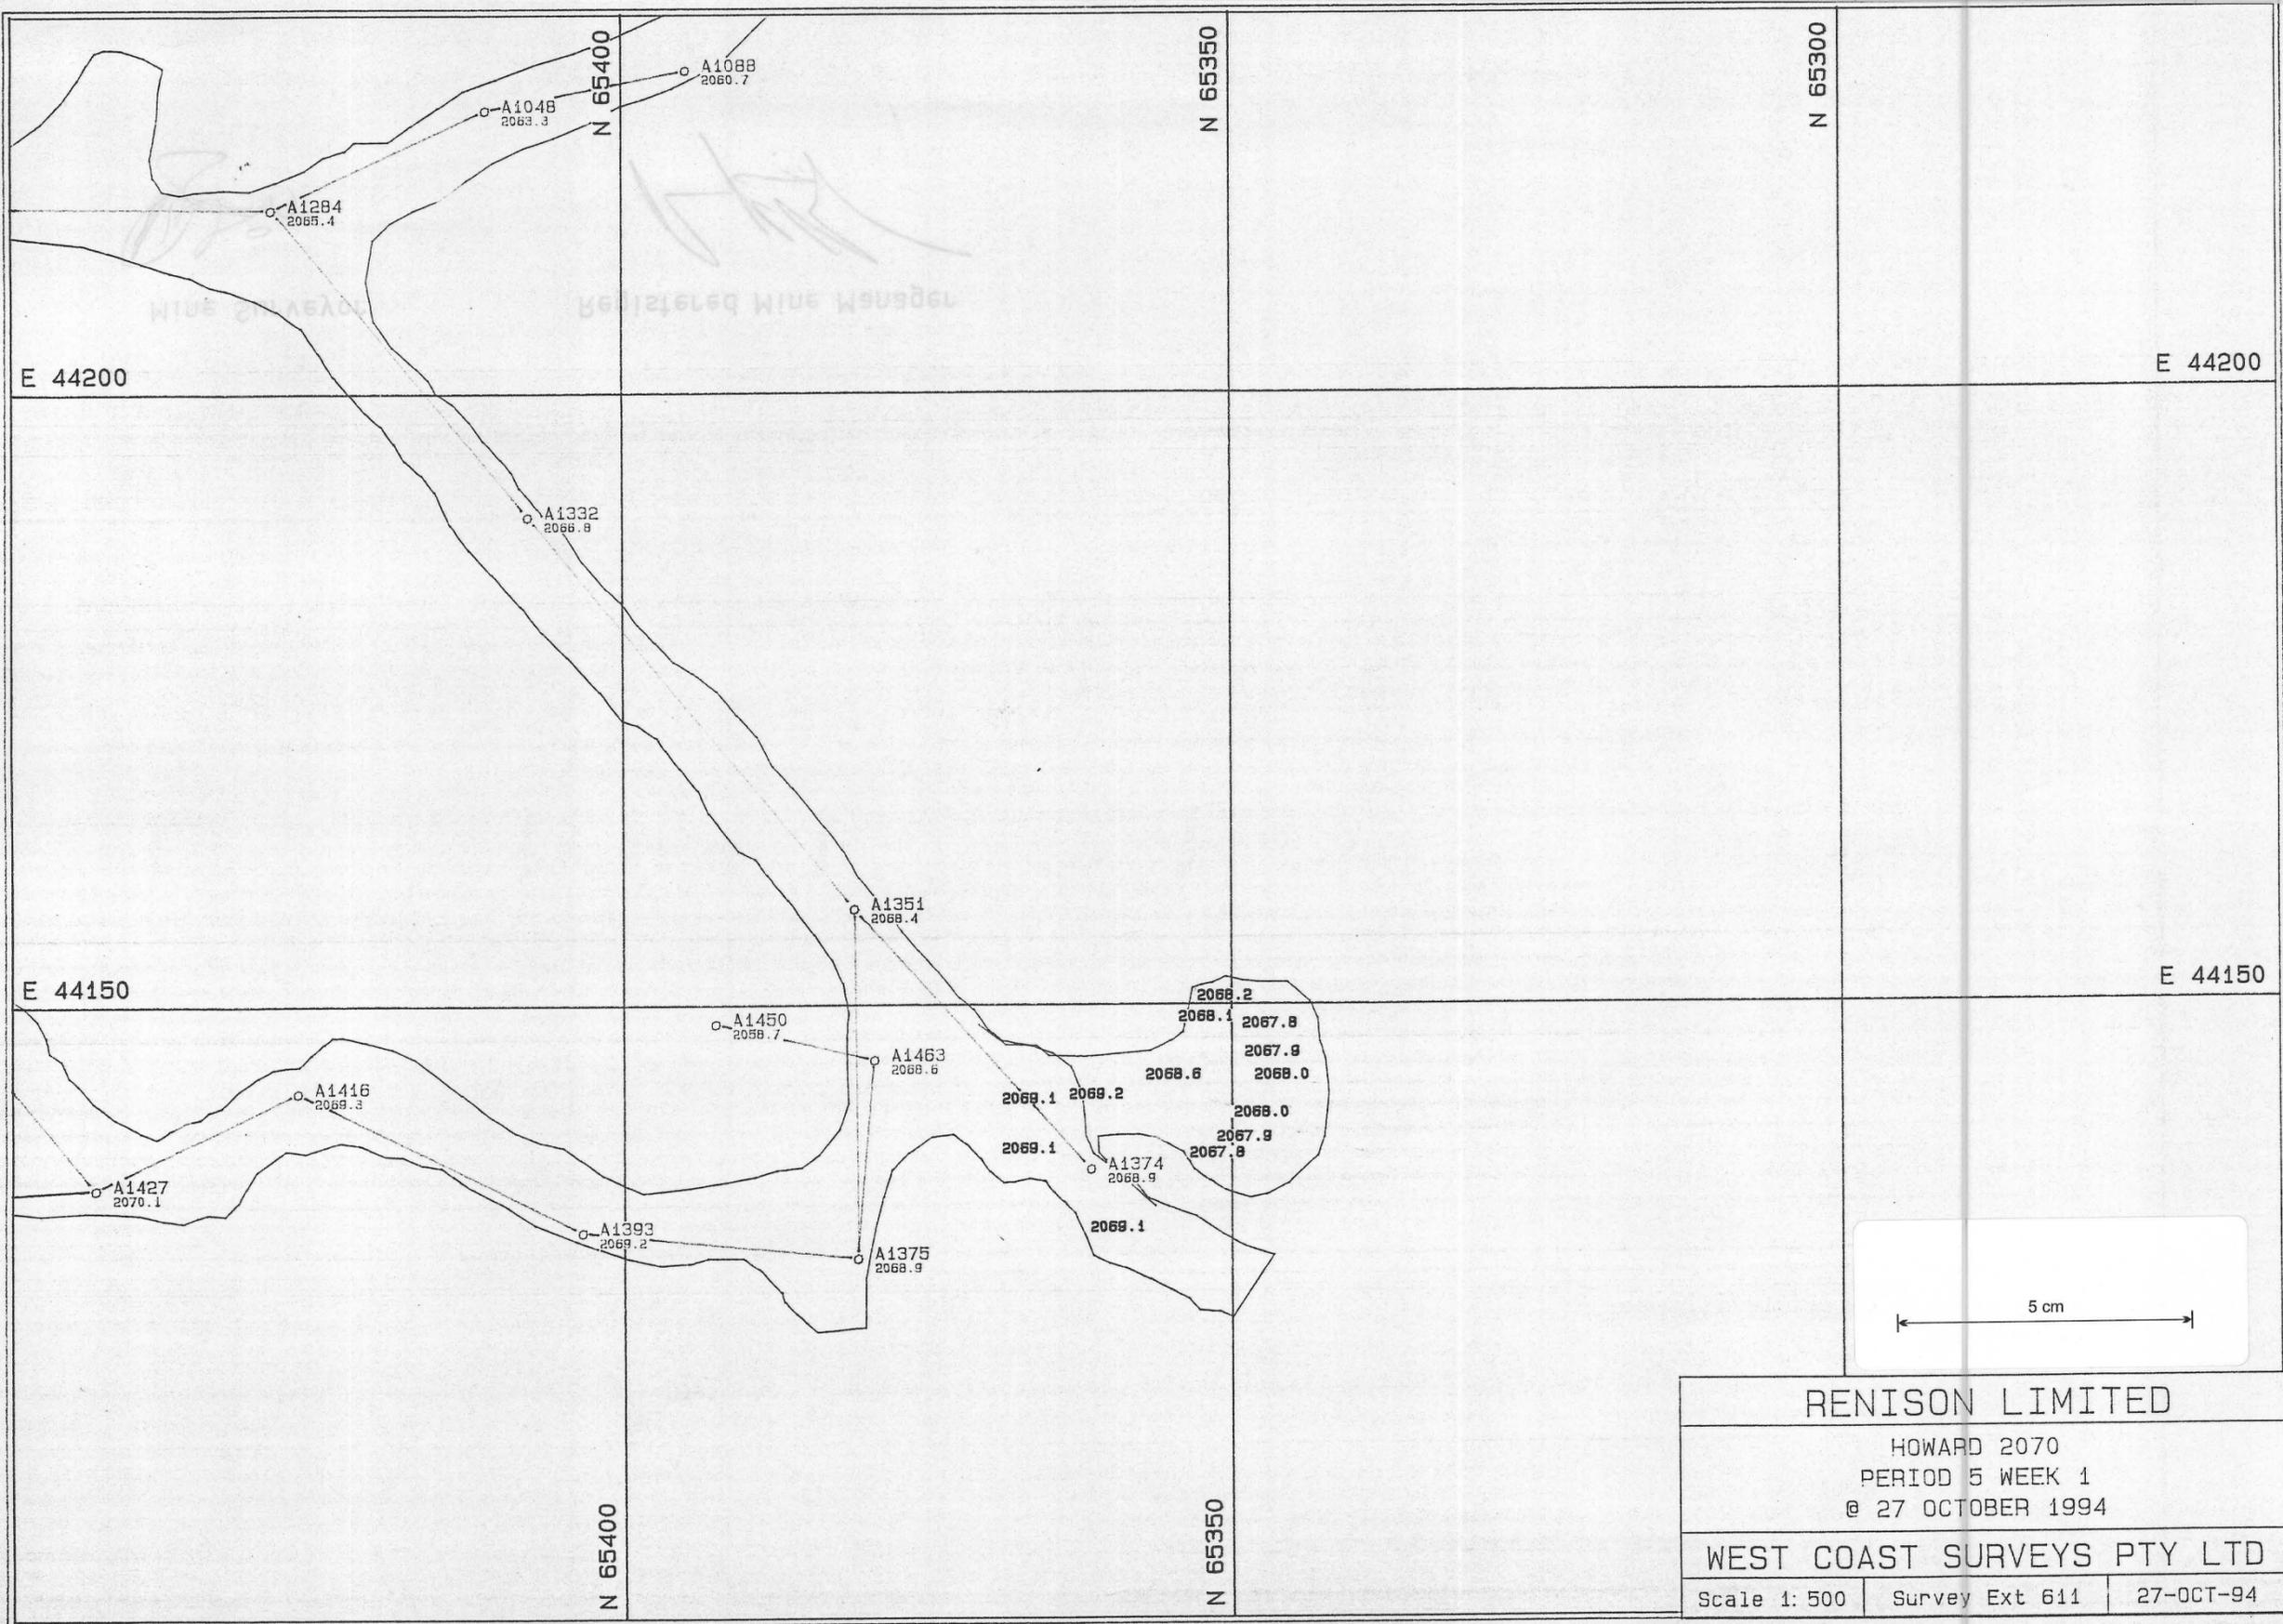

RENISON LIMITED		
HOWARD 2070 PERIOD 5 WEEK 1 @ 27 OCTOBER 1994		
WEST COAST SURVEYS PTY LTD		
Scale 1: 500	Survey Ext 611	27-OCT-94

HOWARE.PF  
K