


03 26-144

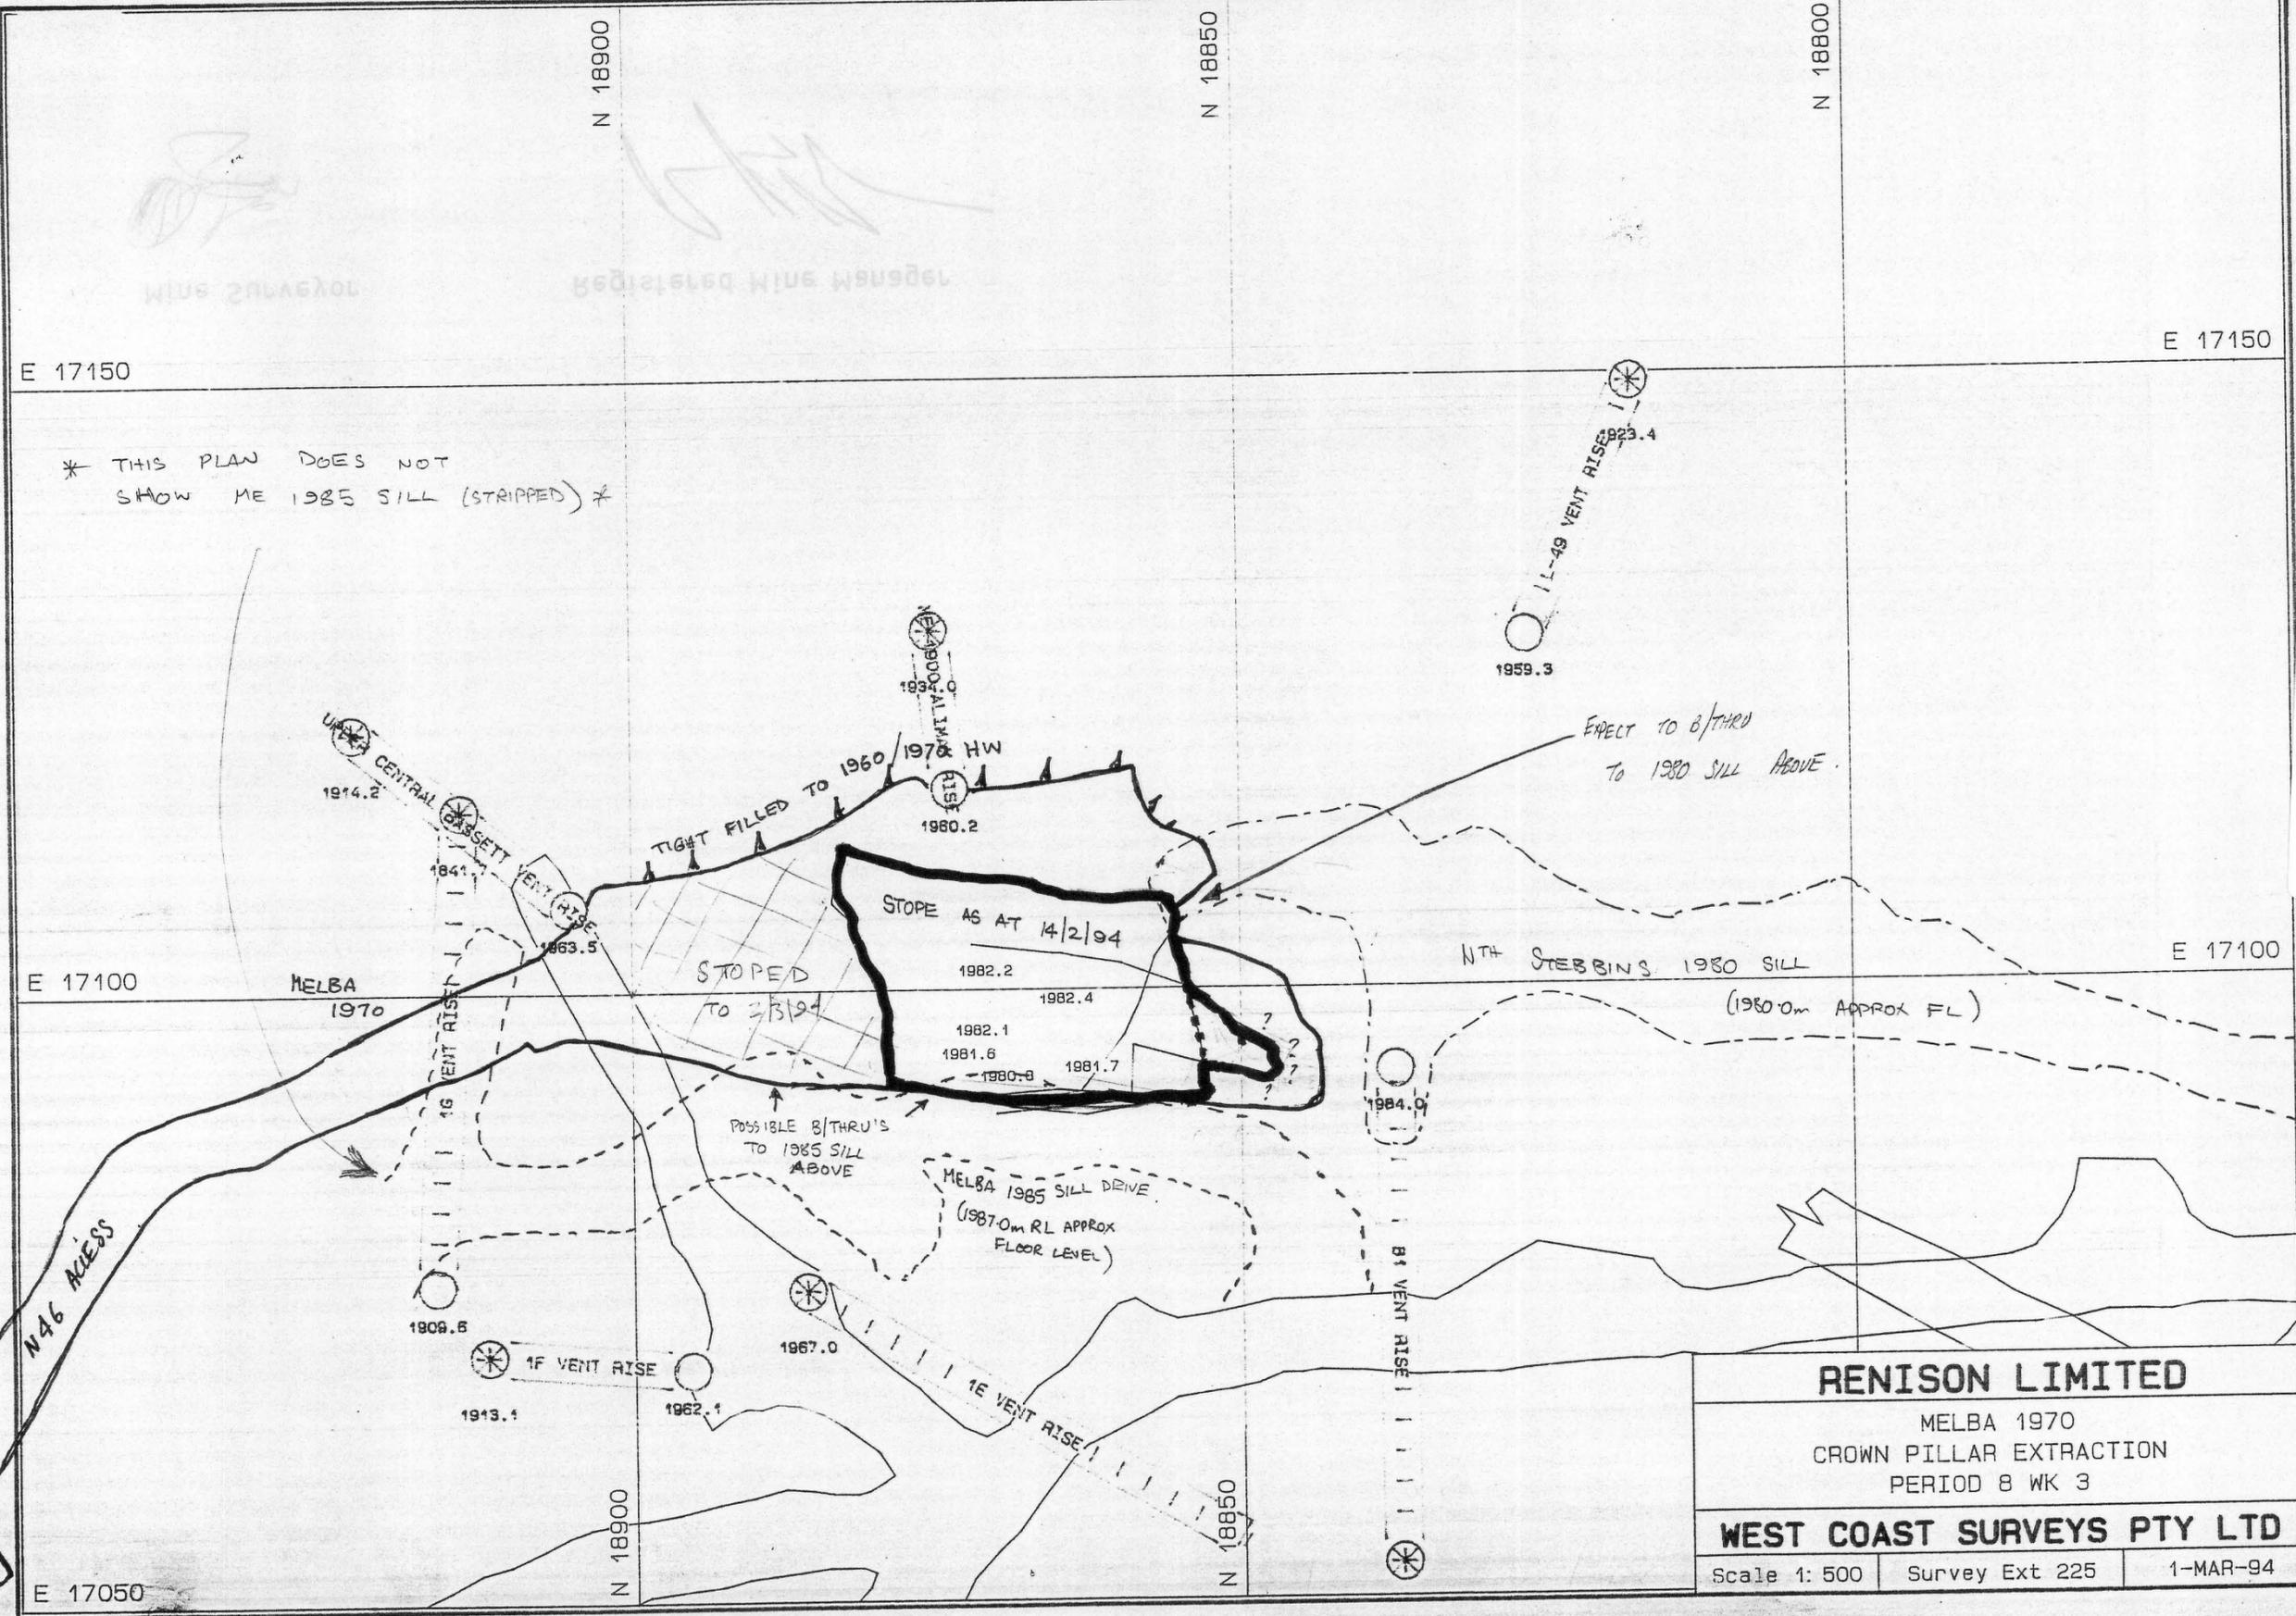

RENISON LIMITED		
MELBA 1970 CROWN PILLAR EXTRACTION PERIOD 8 WK 3		
WEST COAST SURVEYS PTY LTD		
Scale 1: 500	Survey Ext 225	1-MAR-94