
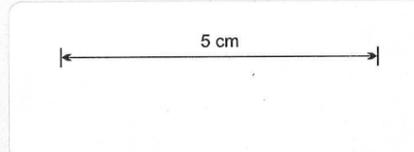


0376-145

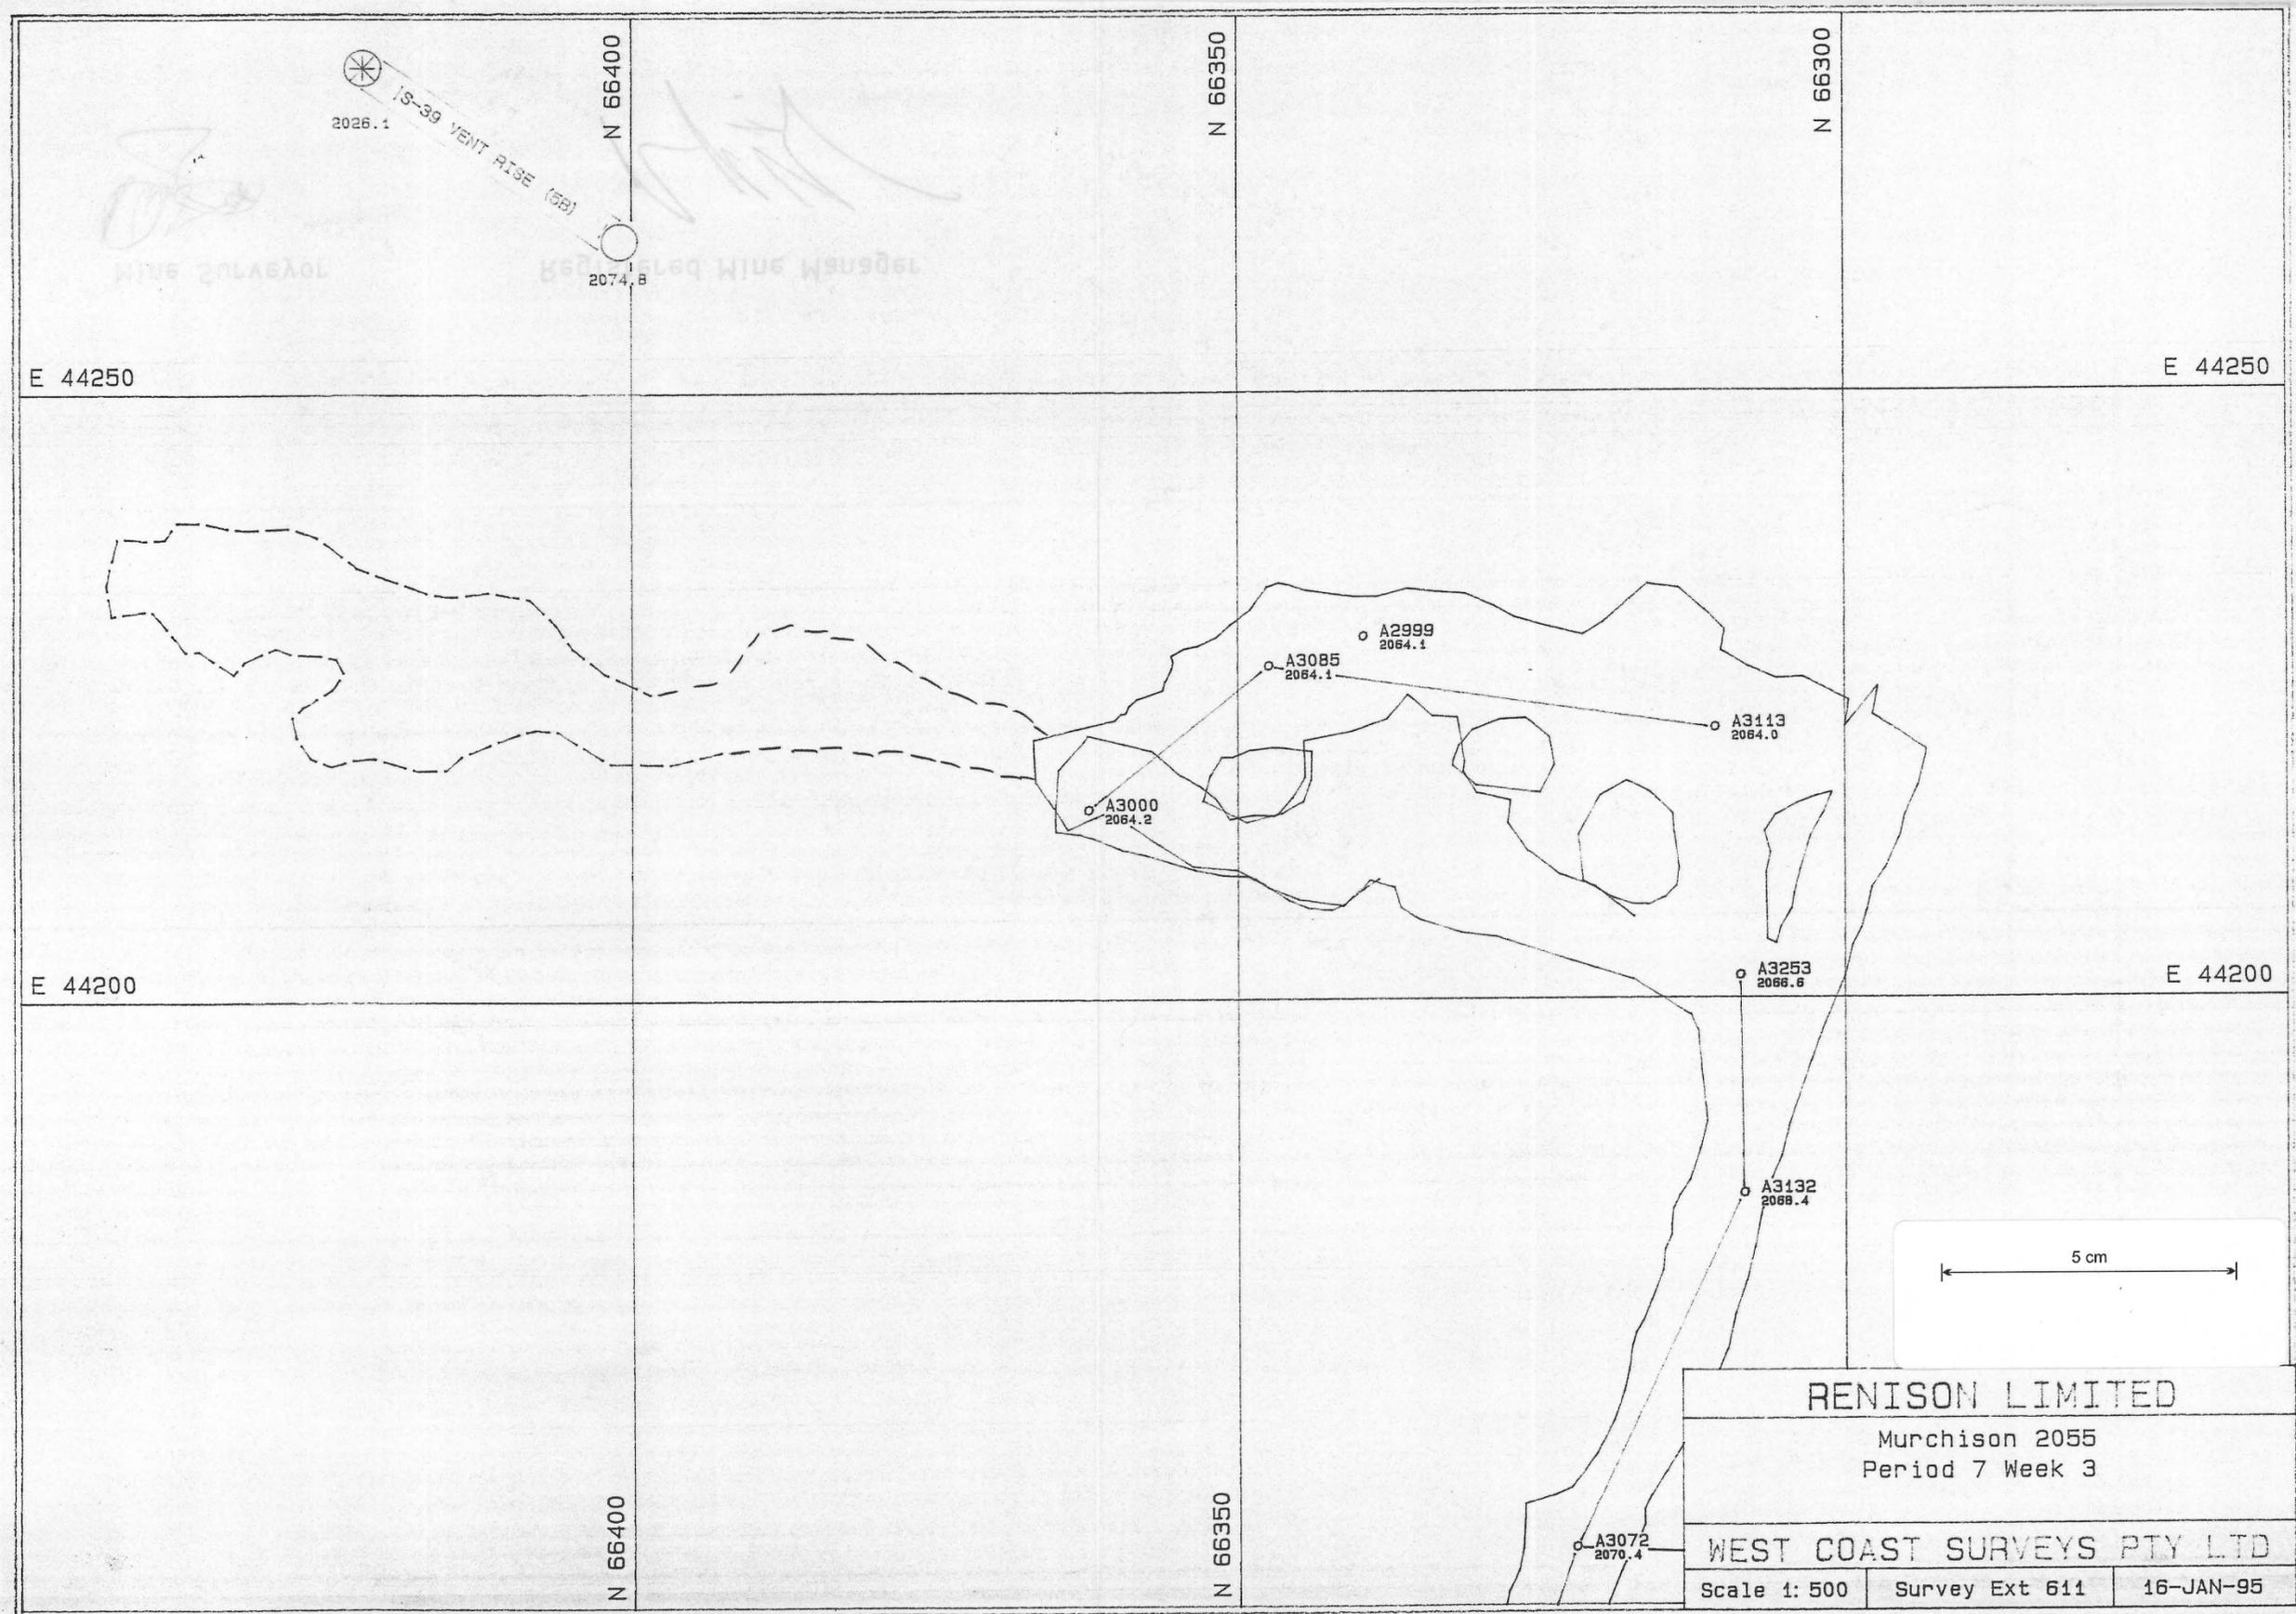

RENISON LIMITED		
Murchison 2055		
Period 7 Week 3		
WEST COAST SURVEYS PTY LTD		
Scale 1: 500	Survey Ext 611	16-JAN-95

MURCHB.PF