


0376-146

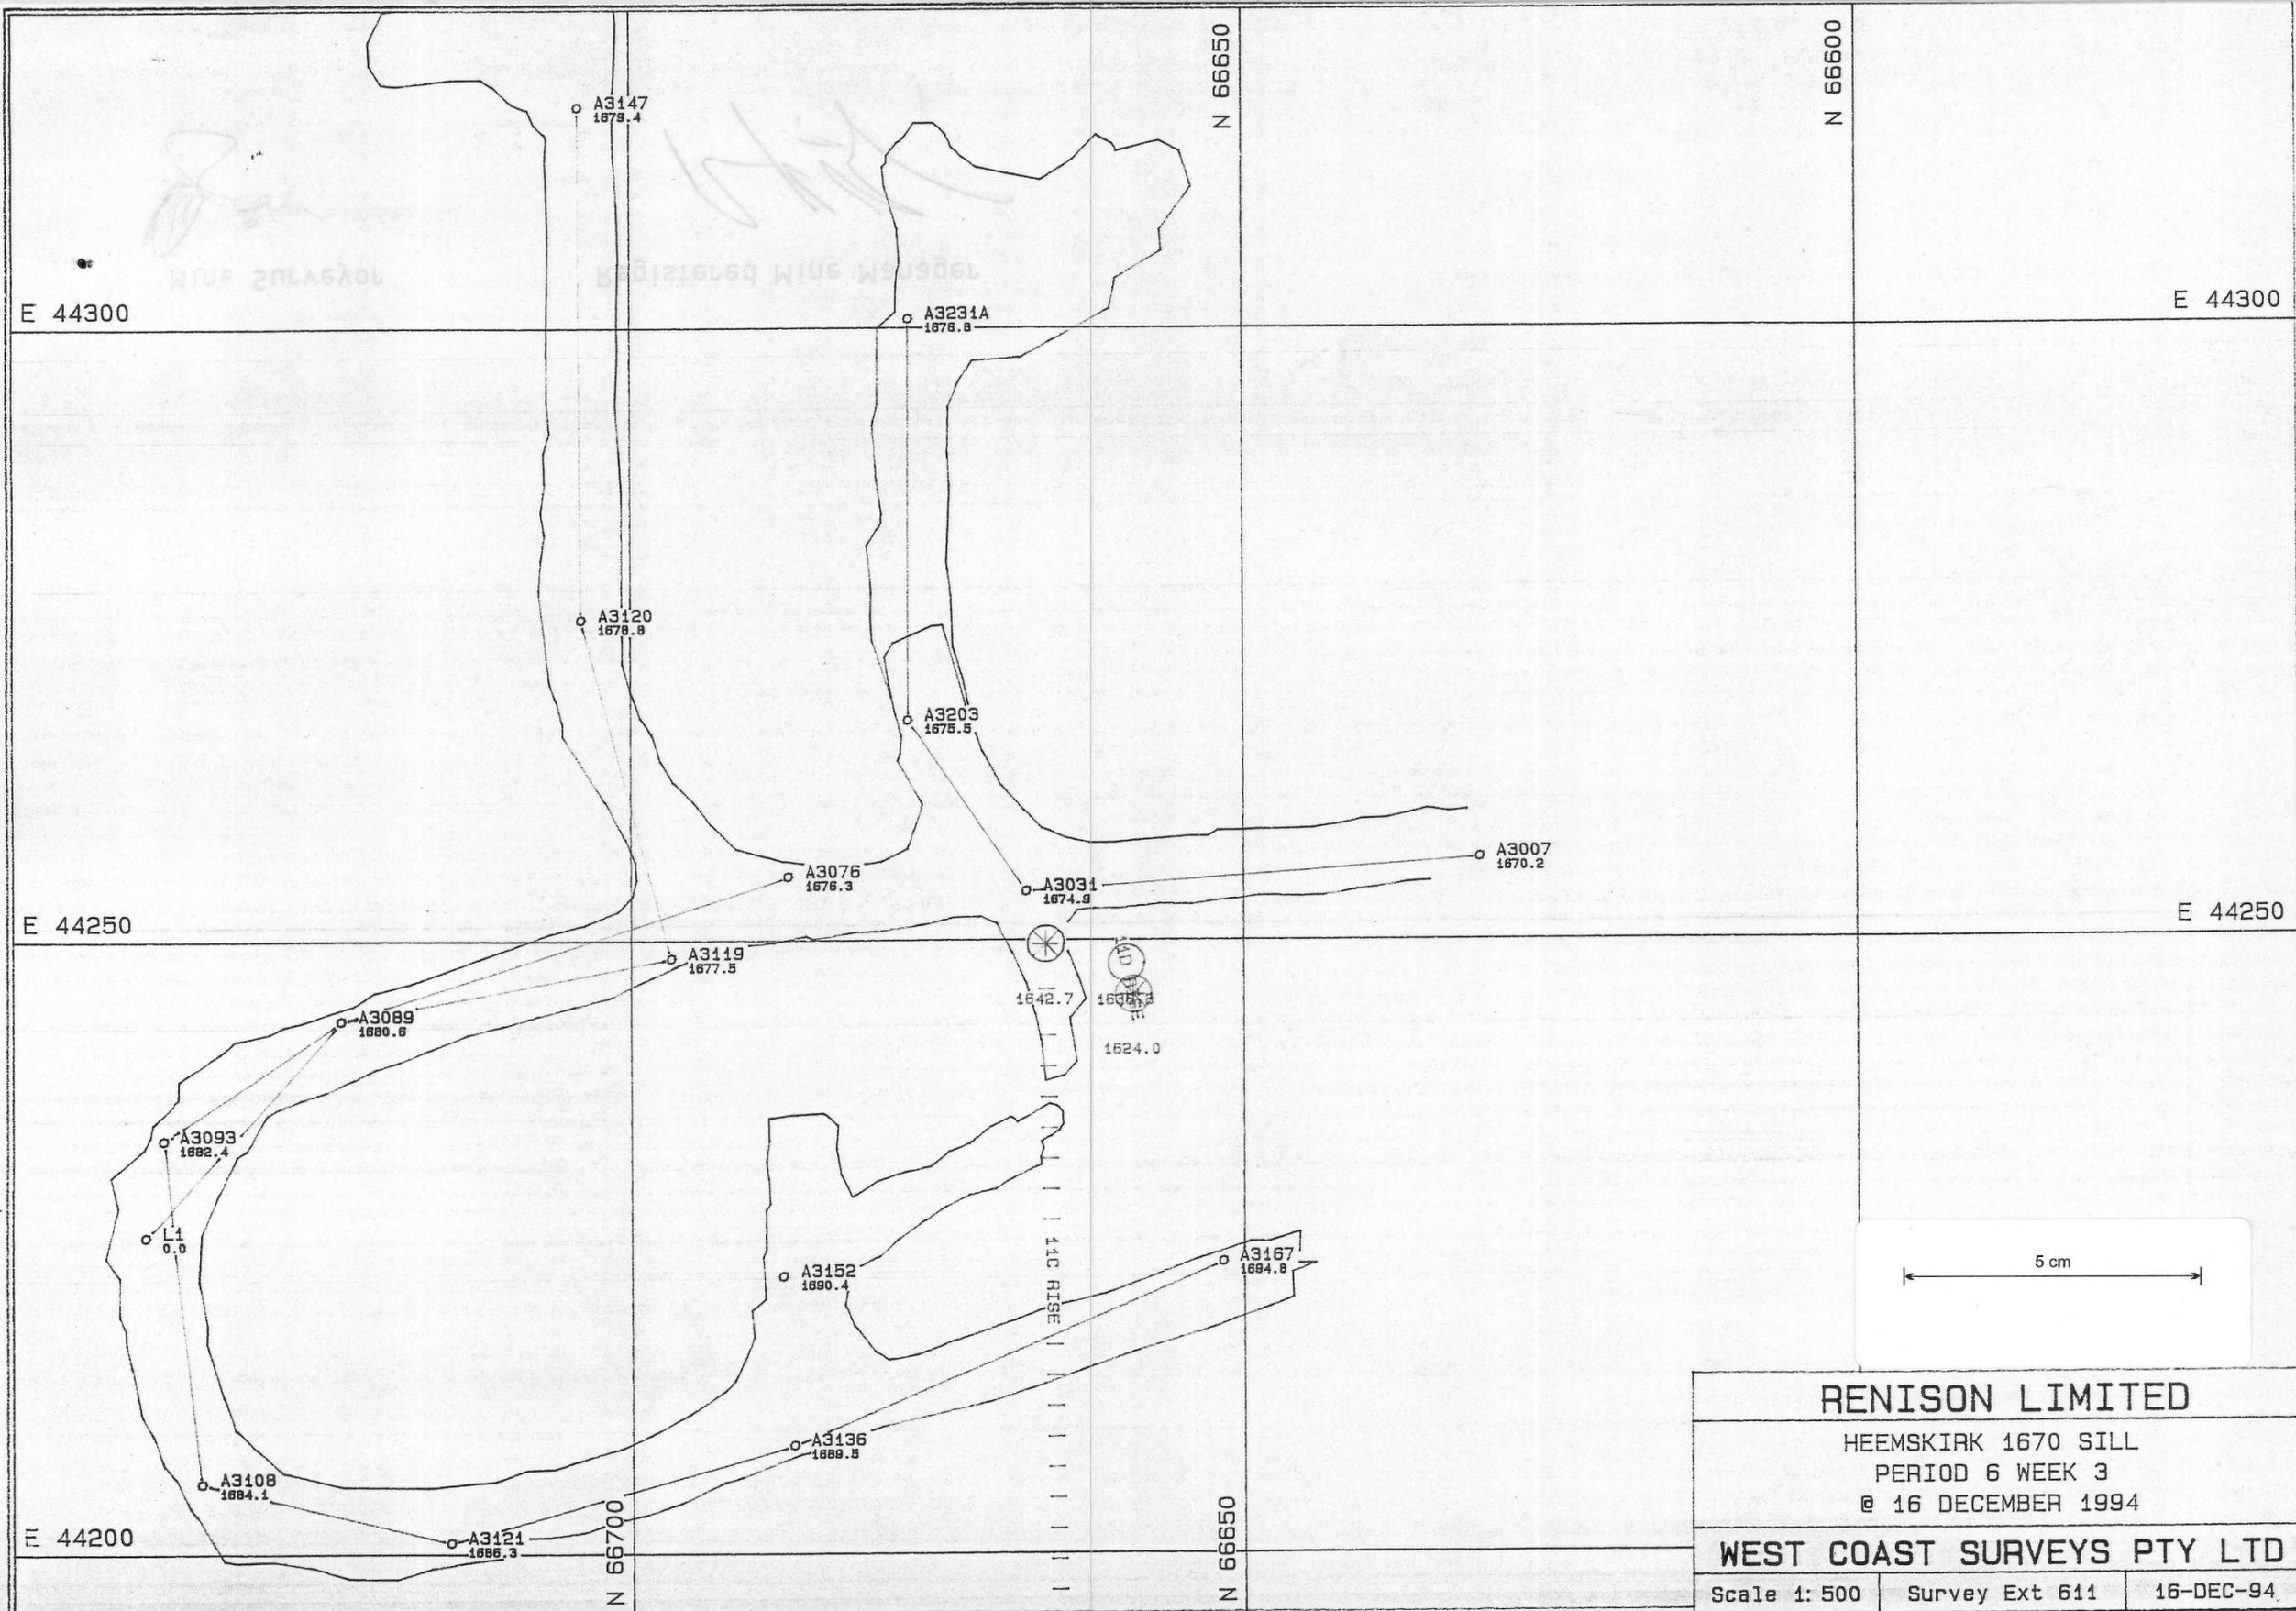

**RENISON LIMITED**

HEEMSKIRK 1670 SILL  
PERIOD 6 WEEK 3  
@ 16 DECEMBER 1994

**WEST COAST SURVEYS PTY LTD**

Scale 1: 500 | Survey Ext 611 | 16-DEC-94

HEEMSA.PF