

0376-147

N 66450

N 66400

N 66350

N 66300

E 44350

E 44350

E 44300

E 44300

N 66450

N 66400

N 66350

NORTH  
CLINDERS  
←

↓  
SURF


SOUTH FLINDERS 1860

A2933  
1874.8  
A2910  
1871.8

A2934  
1878.9

A2850  
1865.4

END FIRST LIFT (SILL DRIVE ?)

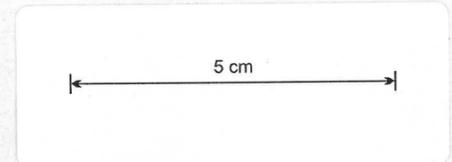

|  |                |           |
|--|----------------|-----------|
| <b>RENISON LIMITED</b>                       |                |           |
| SOUTH FLINDERS 1860<br>AT END MINING<br>1992 |                |           |
| <b>WEST COAST SURVEYS PTY LTD</b>            |                |           |
| Scale 1: 500                                 | Survey Ext 611 | 27-JUL-94 |