


0376-149

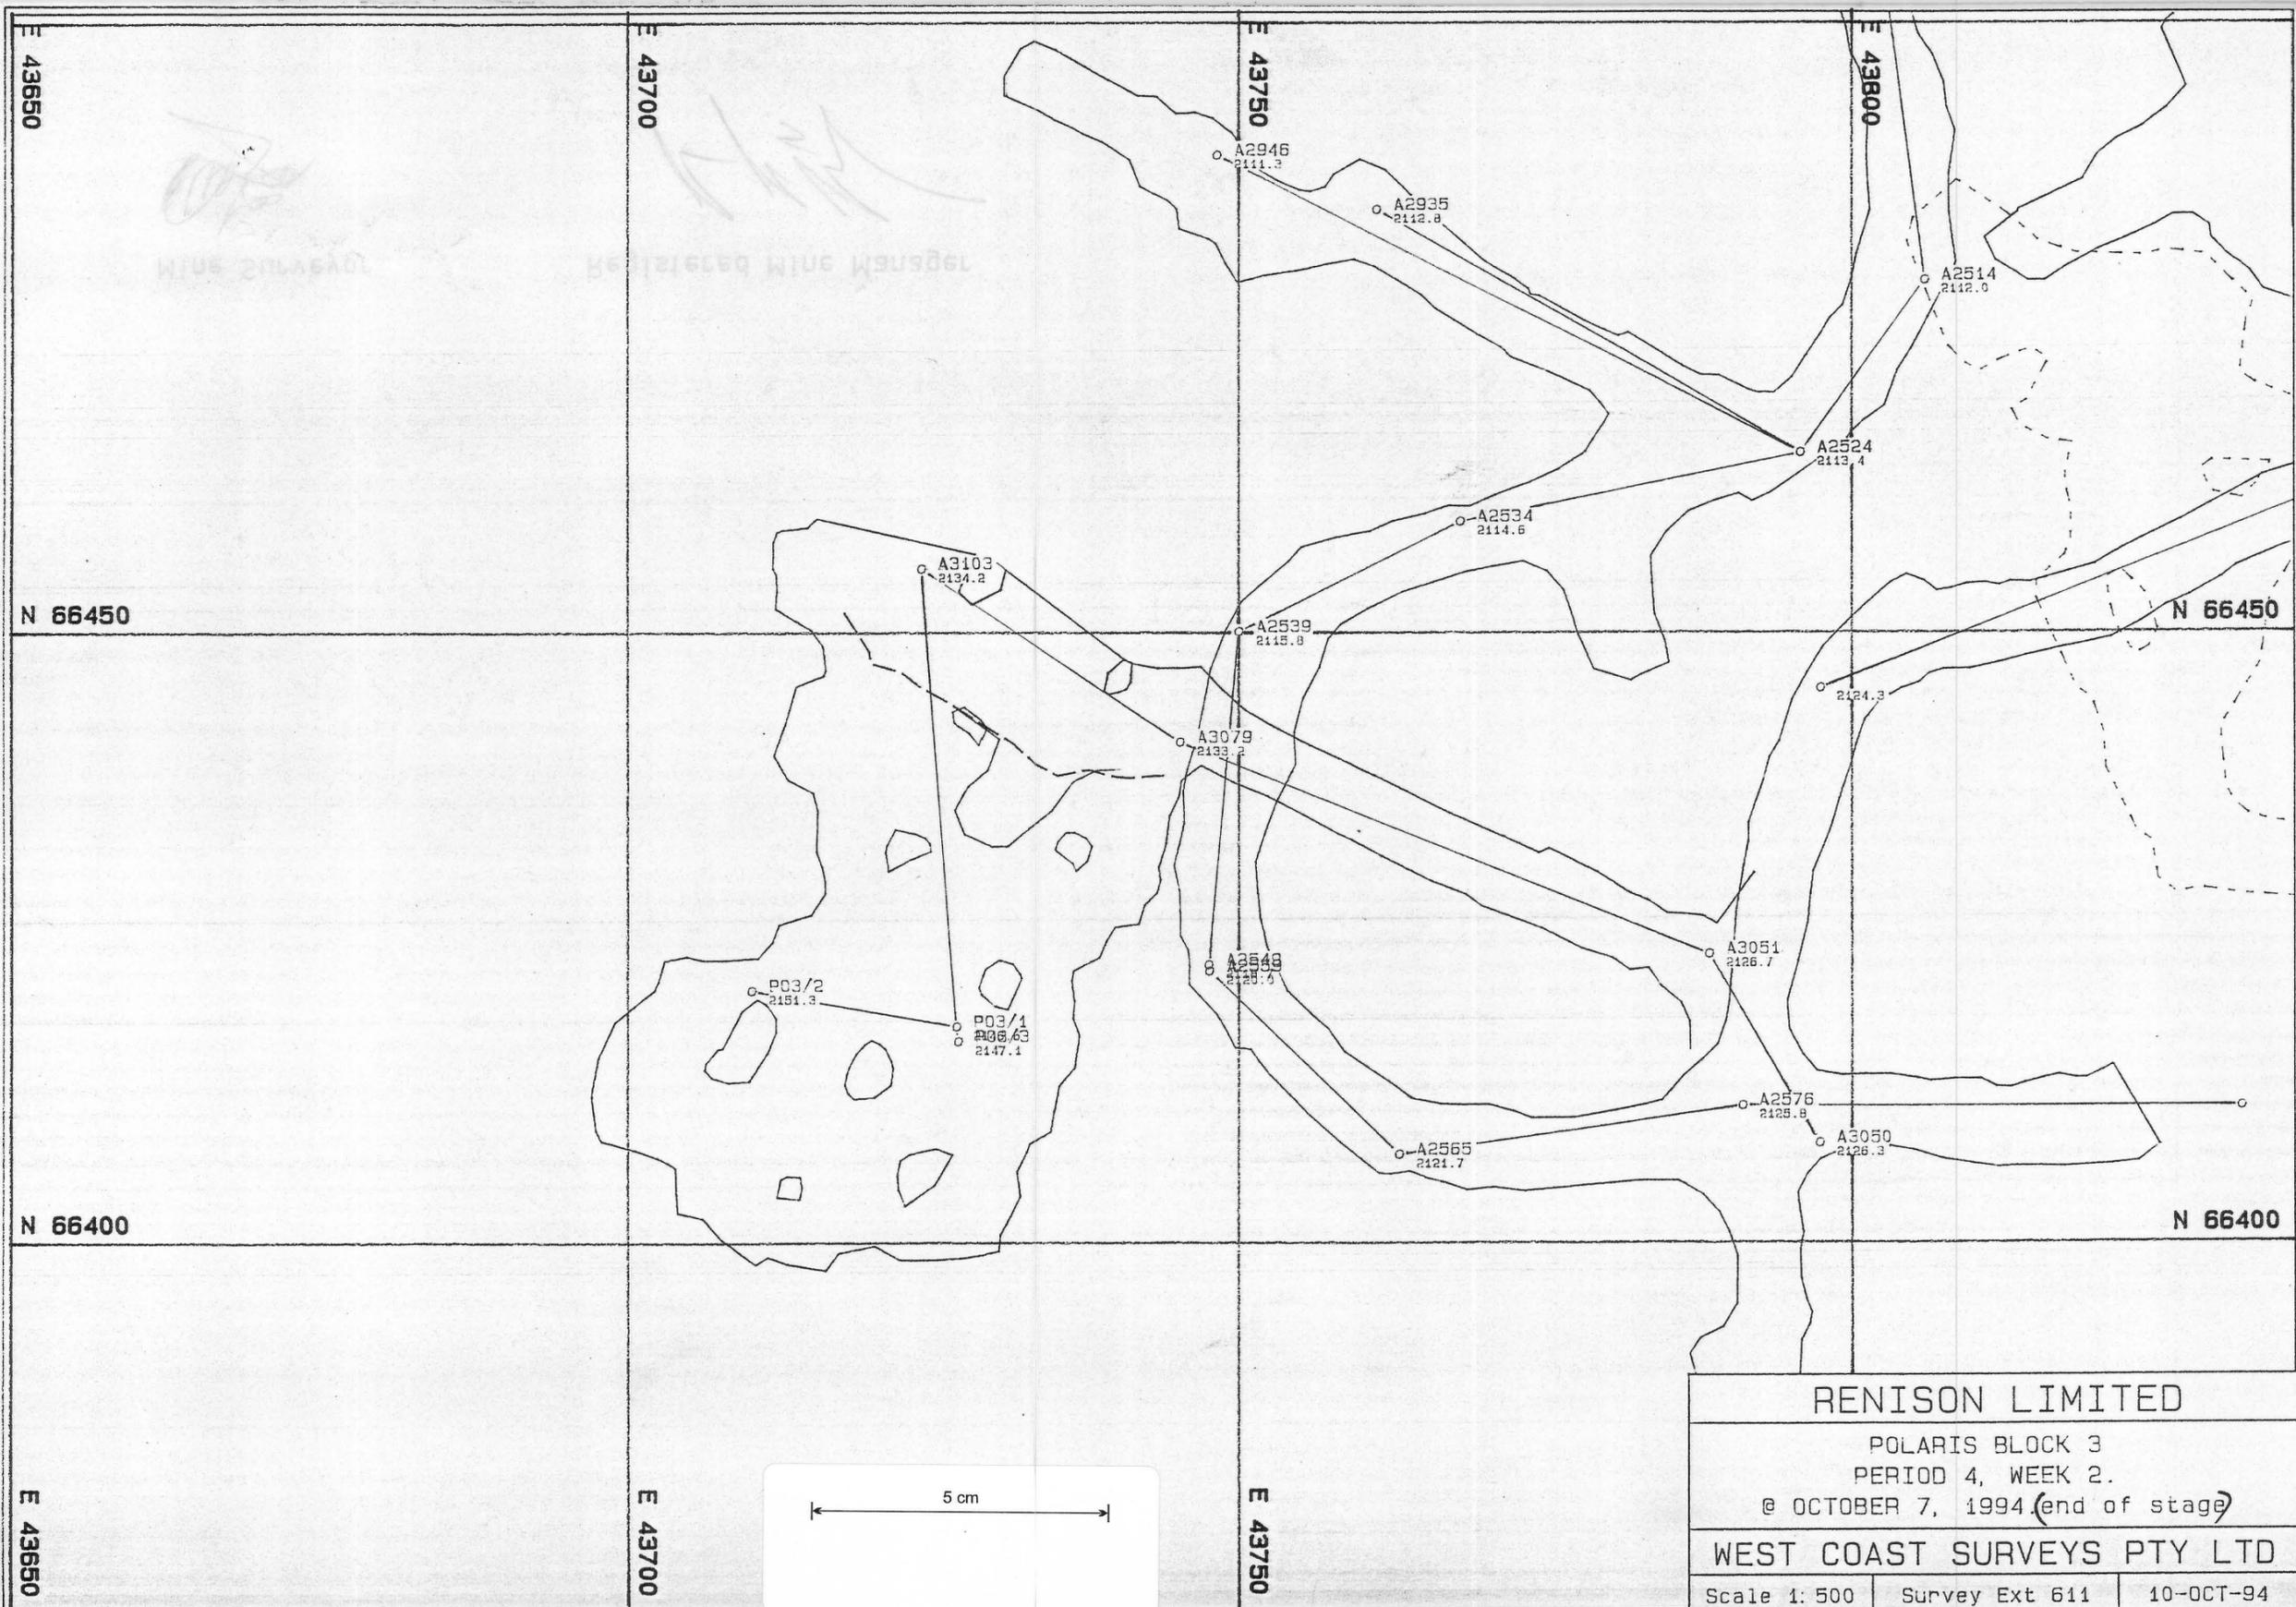

RENISON LIMITED		
POLARIS BLOCK 3		
PERIOD 4, WEEK 2.		
@ OCTOBER 7, 1994 (end of stage)		
WEST COAST SURVEYS PTY LTD		
Scale 1: 500	Survey Ext 611	10-OCT-94

POLARIS.PF

E 43650

E 43700

E 43750