


0376-150

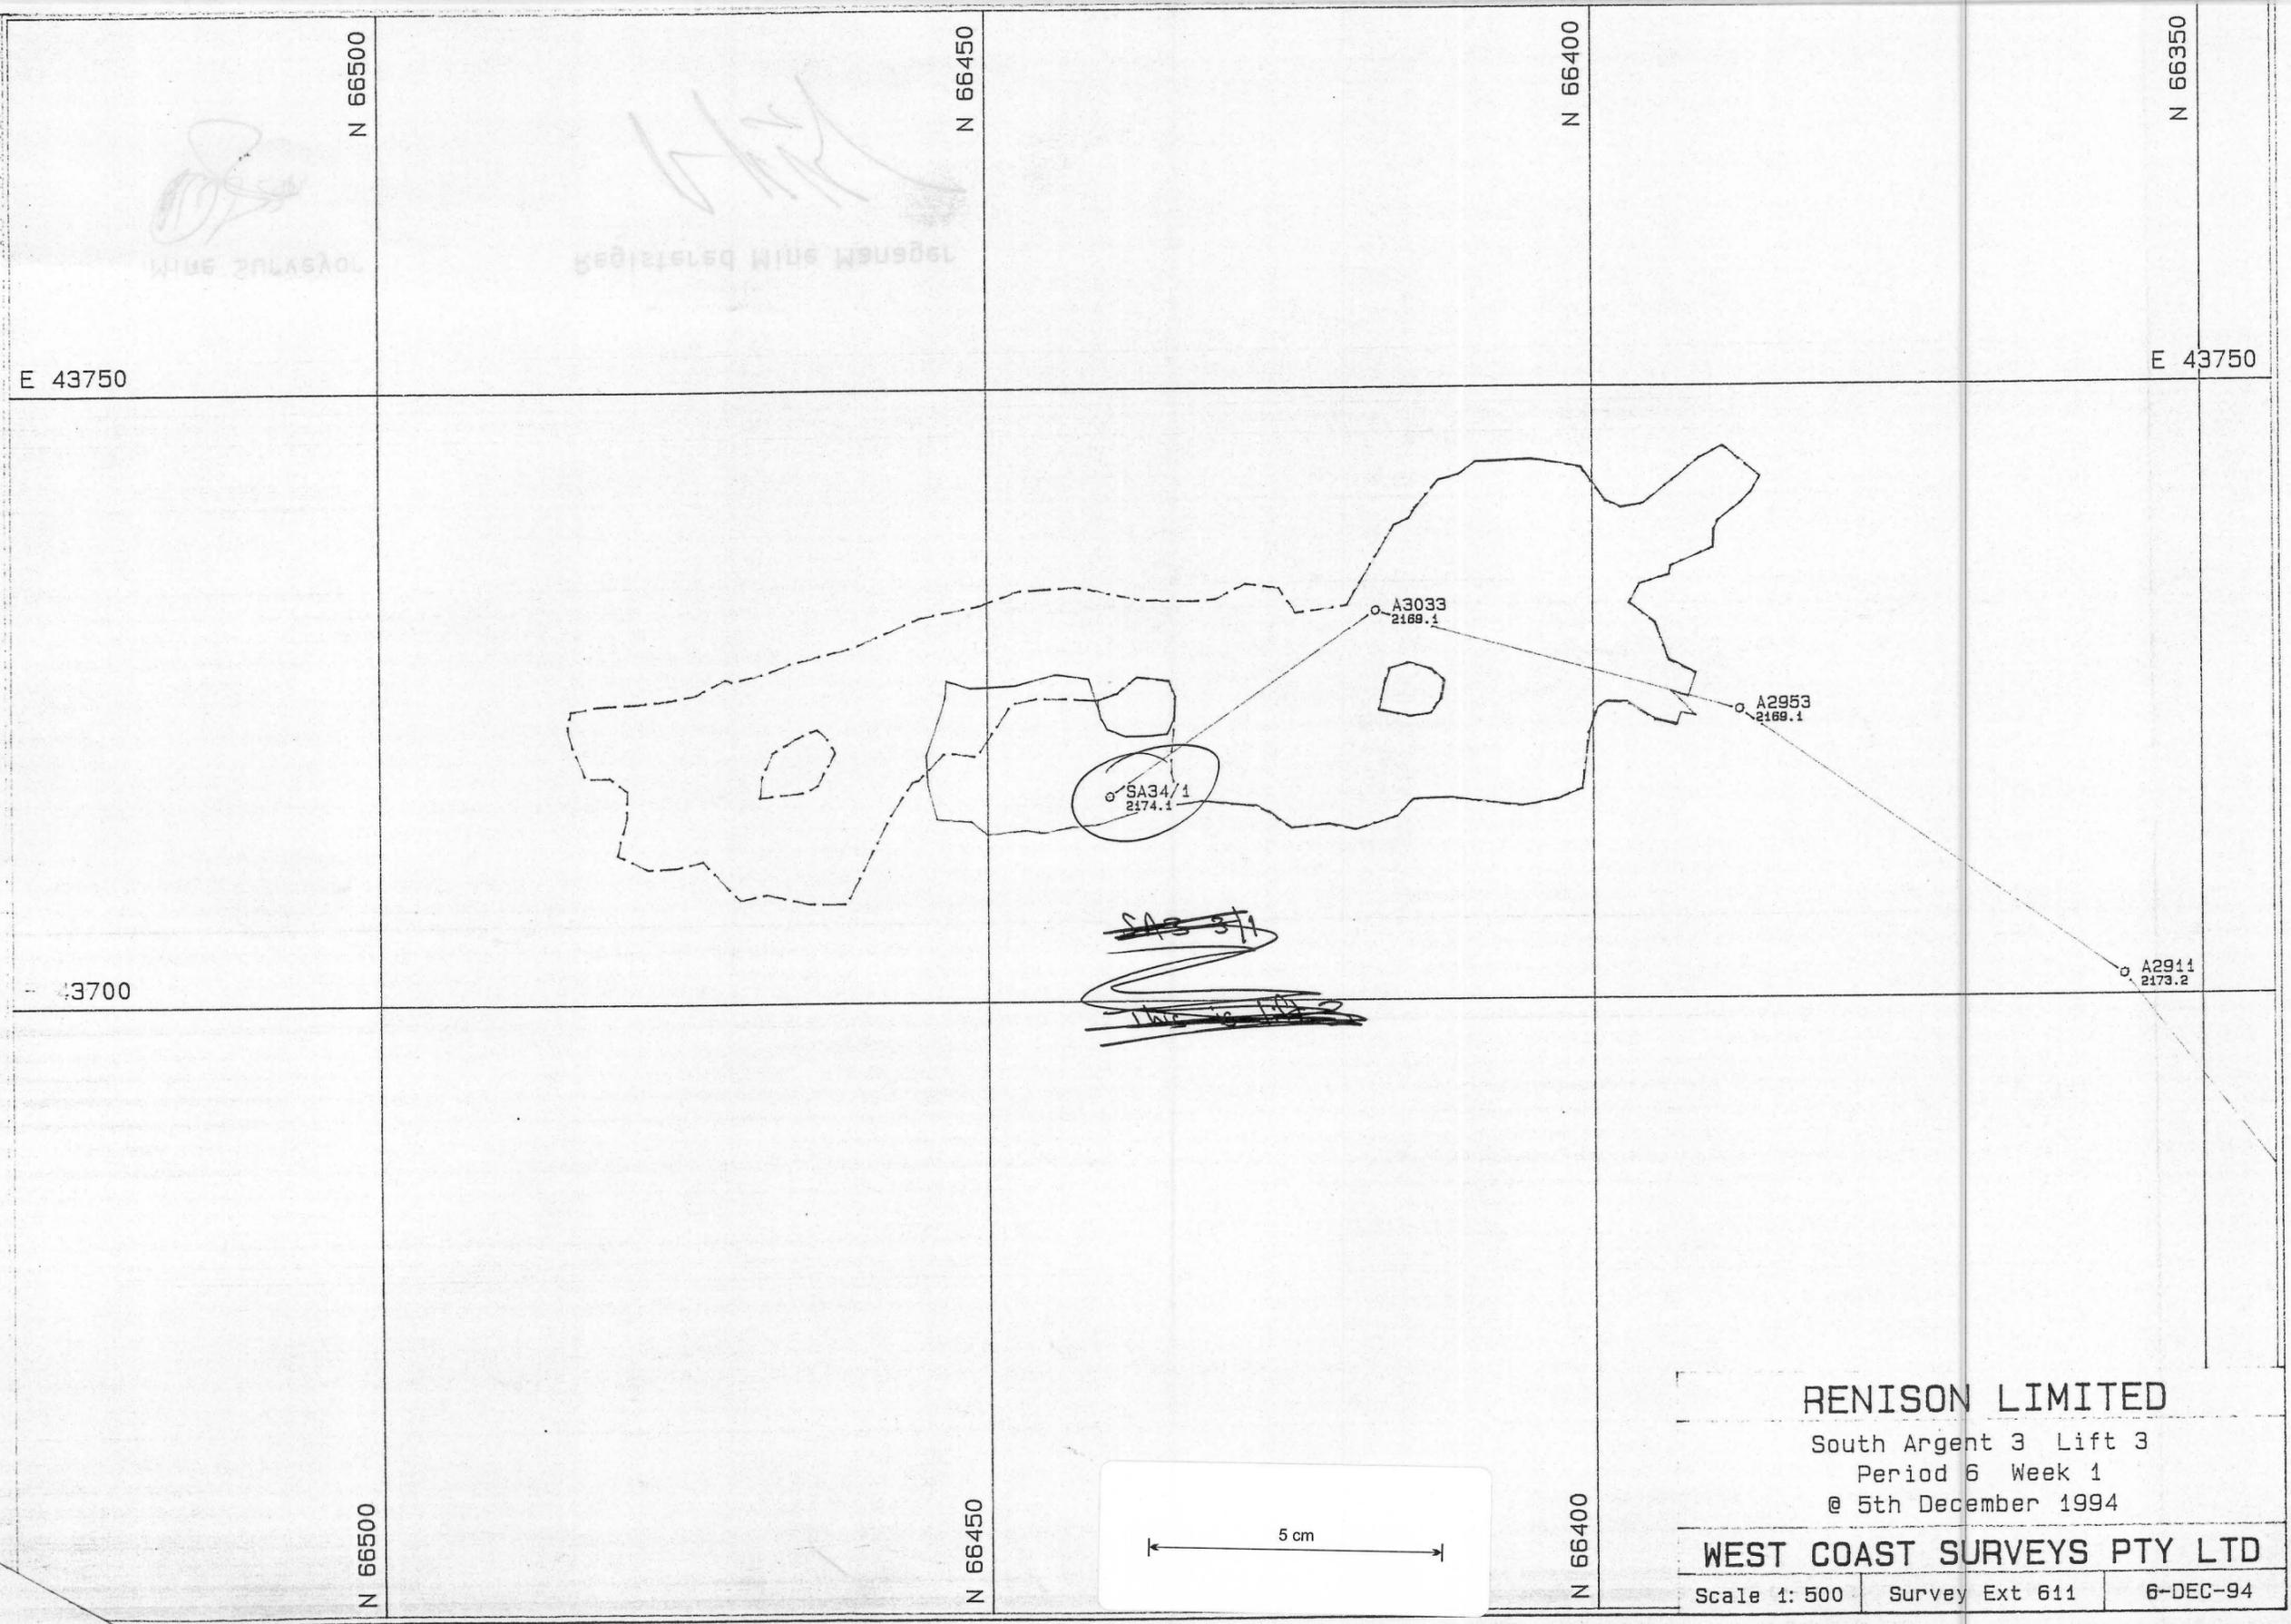

REGISTERED
MINE MANAGER

REGISTERED
MINE MANAGER

~~SA3 5/1~~
~~SA3 5/1~~

RENISON LIMITED

South Argent 3 Lift 3
Period 6 Week 1
@ 5th December 1994

WEST COAST SURVEYS PTY LTD

Scale 1:500 | Survey Ext 611 | 6-DEC-94

