


03760151

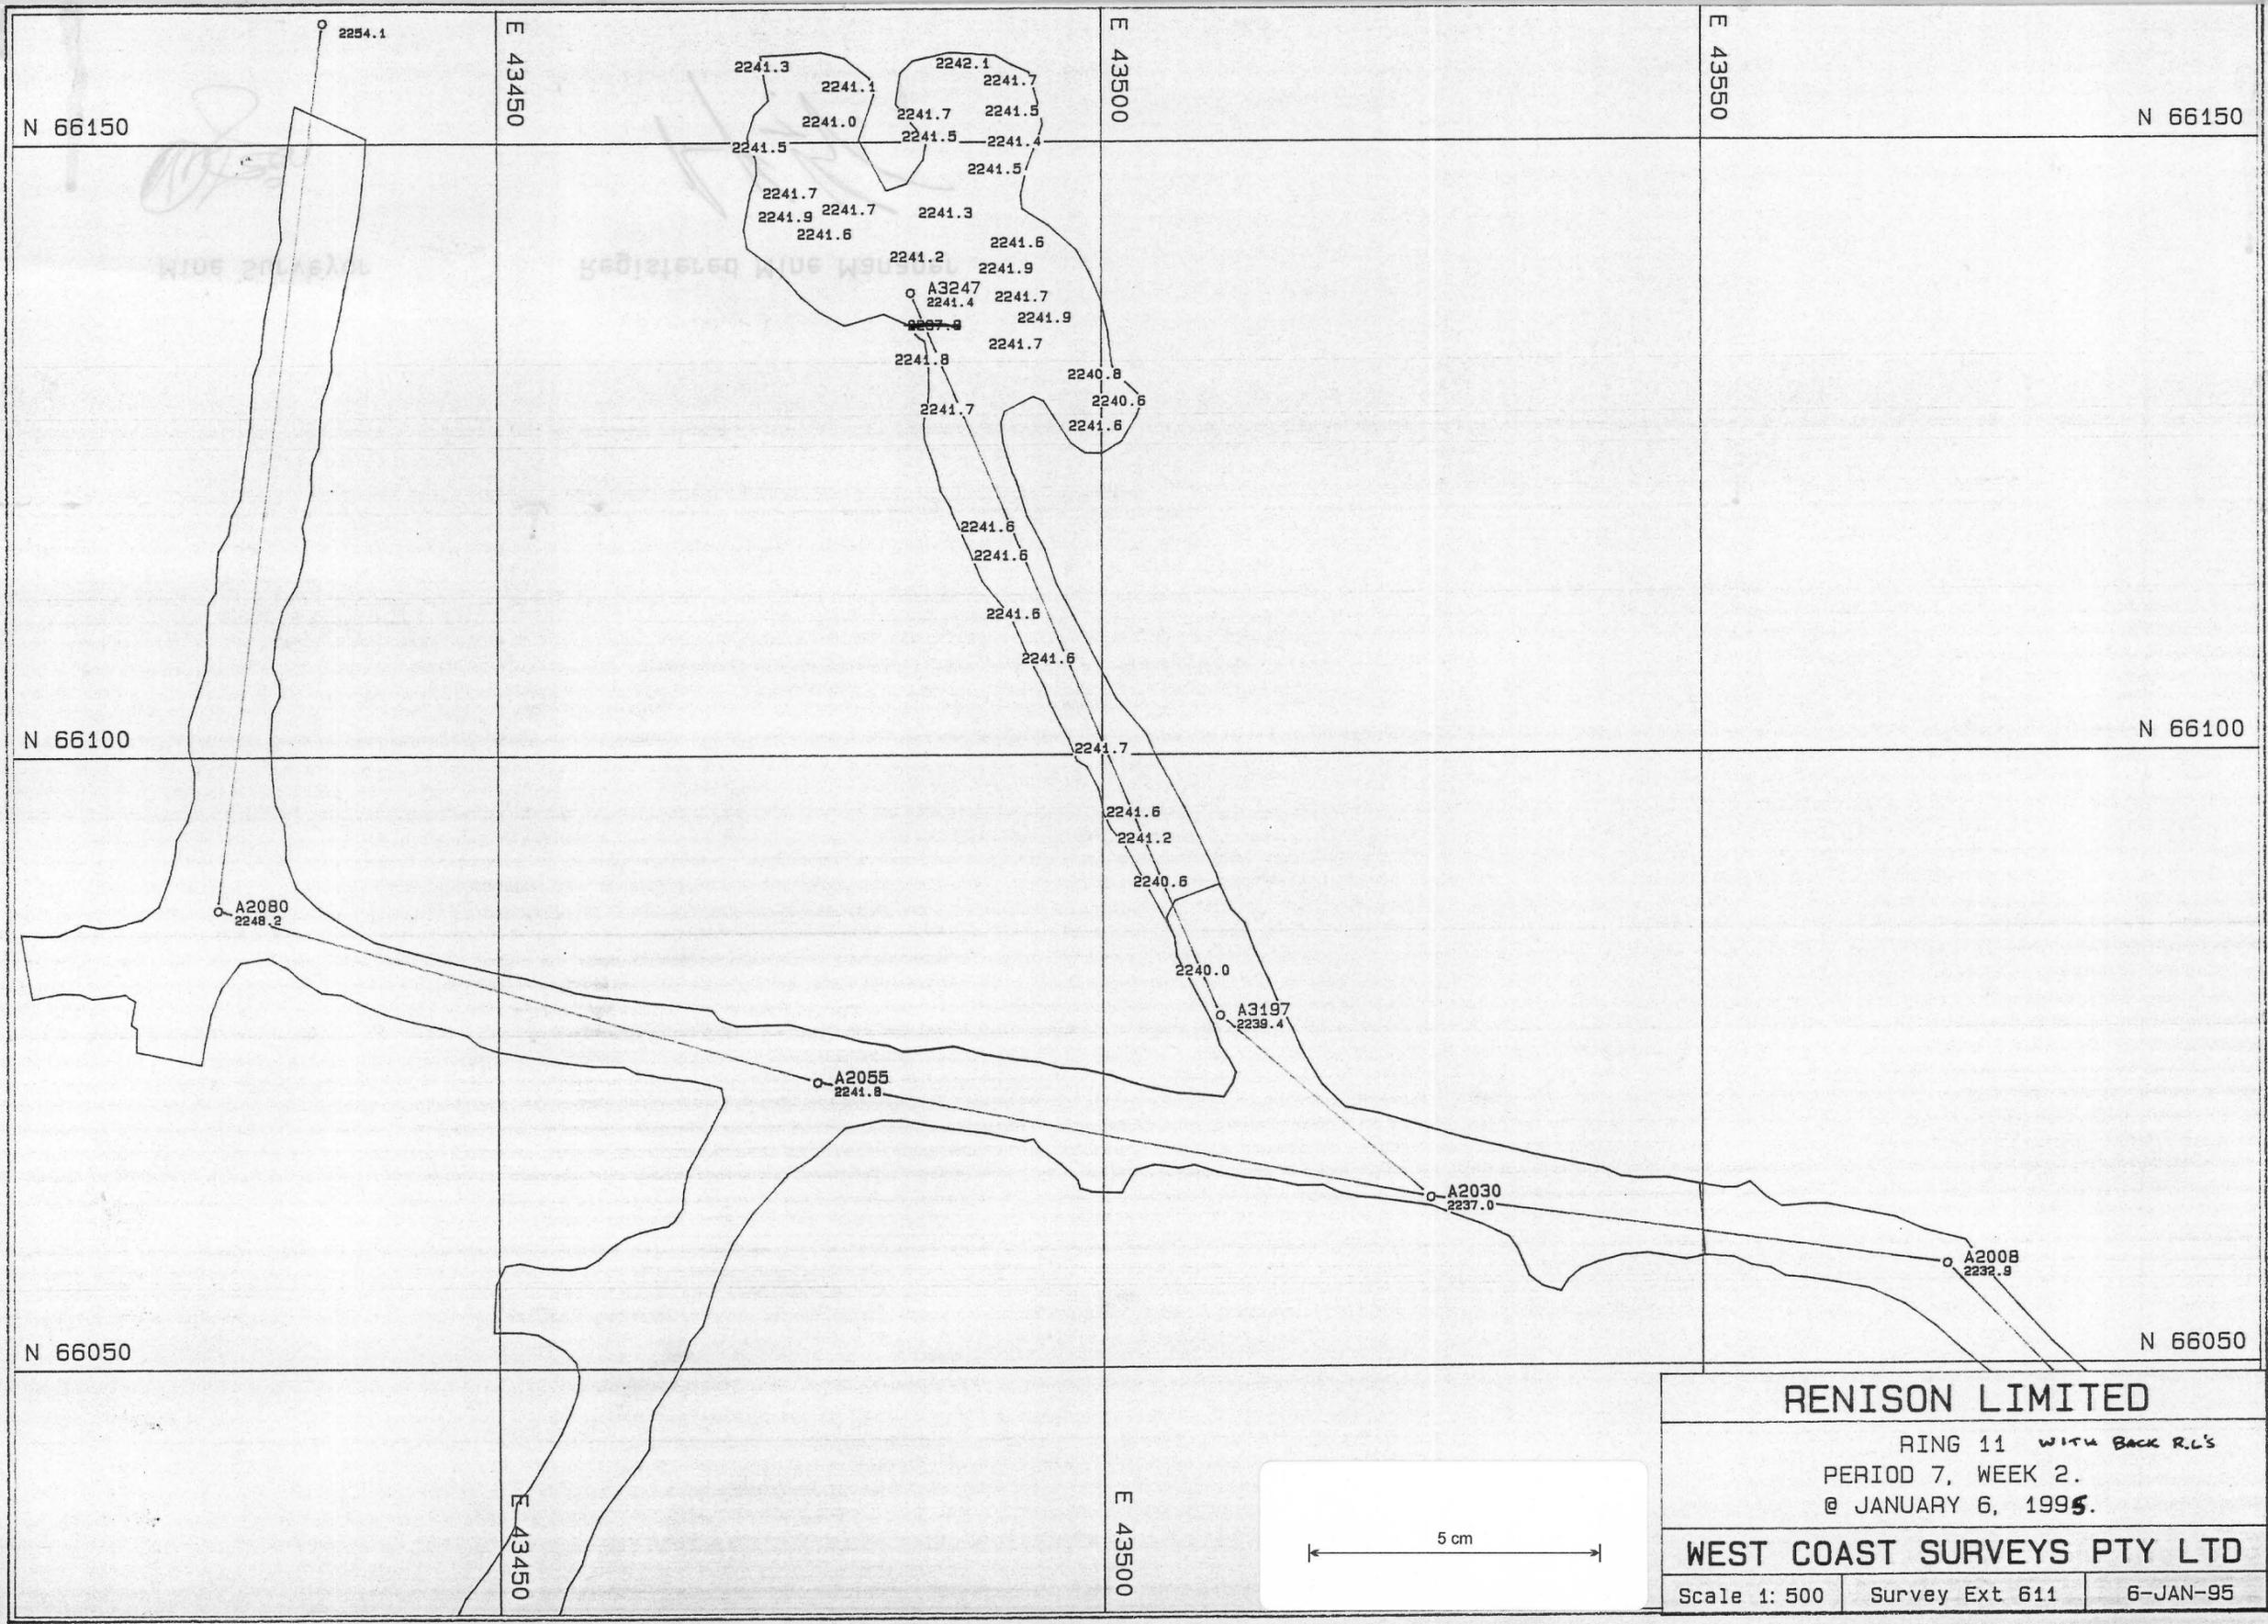

RENISON LIMITED
 RING 11 WITH BACK R.L.'S
 PERIOD 7, WEEK 2.
 @ JANUARY 6, 1995.

WEST COAST SURVEYS PTY LTD
 Scale 1: 500 Survey Ext 611 6-JAN-95

RING1A.PF