



0376 - 153

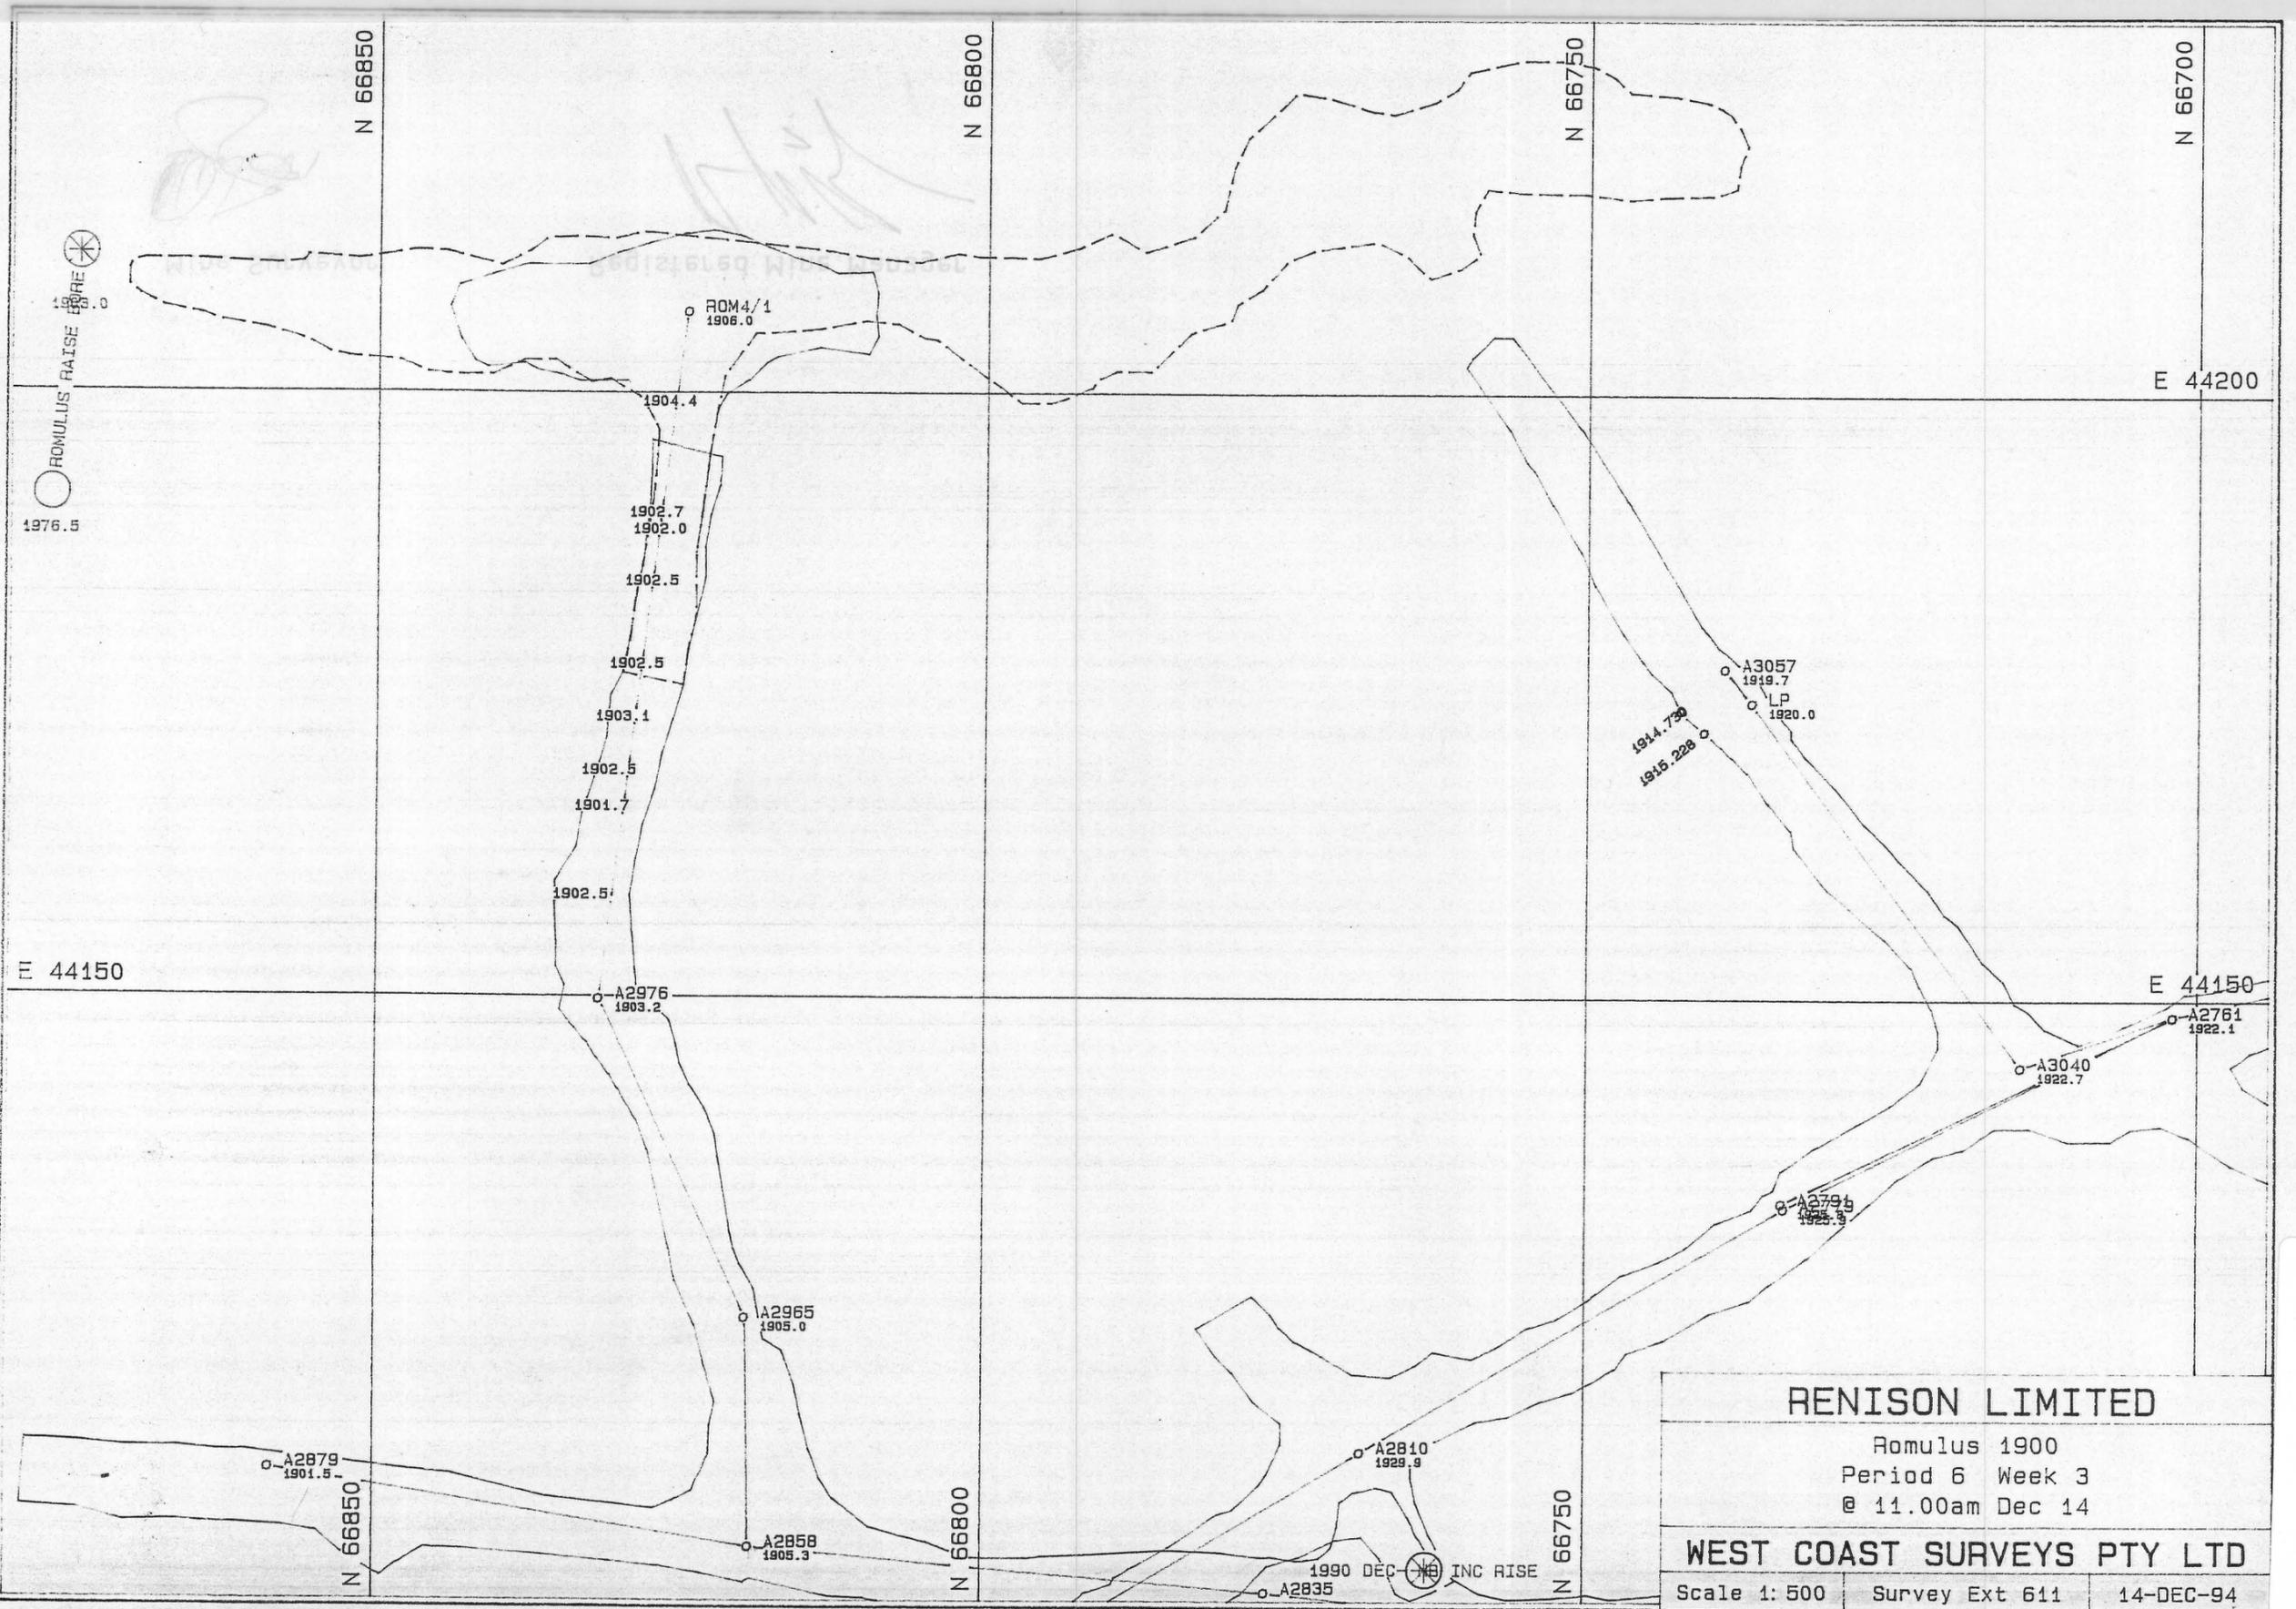

**RENISON LIMITED**  
 Romulus 1900  
 Period 6 Week 3  
 @ 11.00am Dec 14

**WEST COAST SURVEYS PTY LTD**  
 Scale 1: 500    Survey Ext 611    14-DEC-94

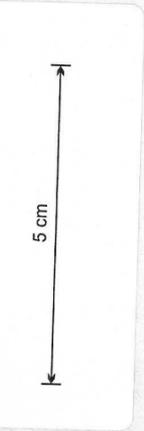

ROMULA.PF