


0376 - 154

MASEC.PF

X

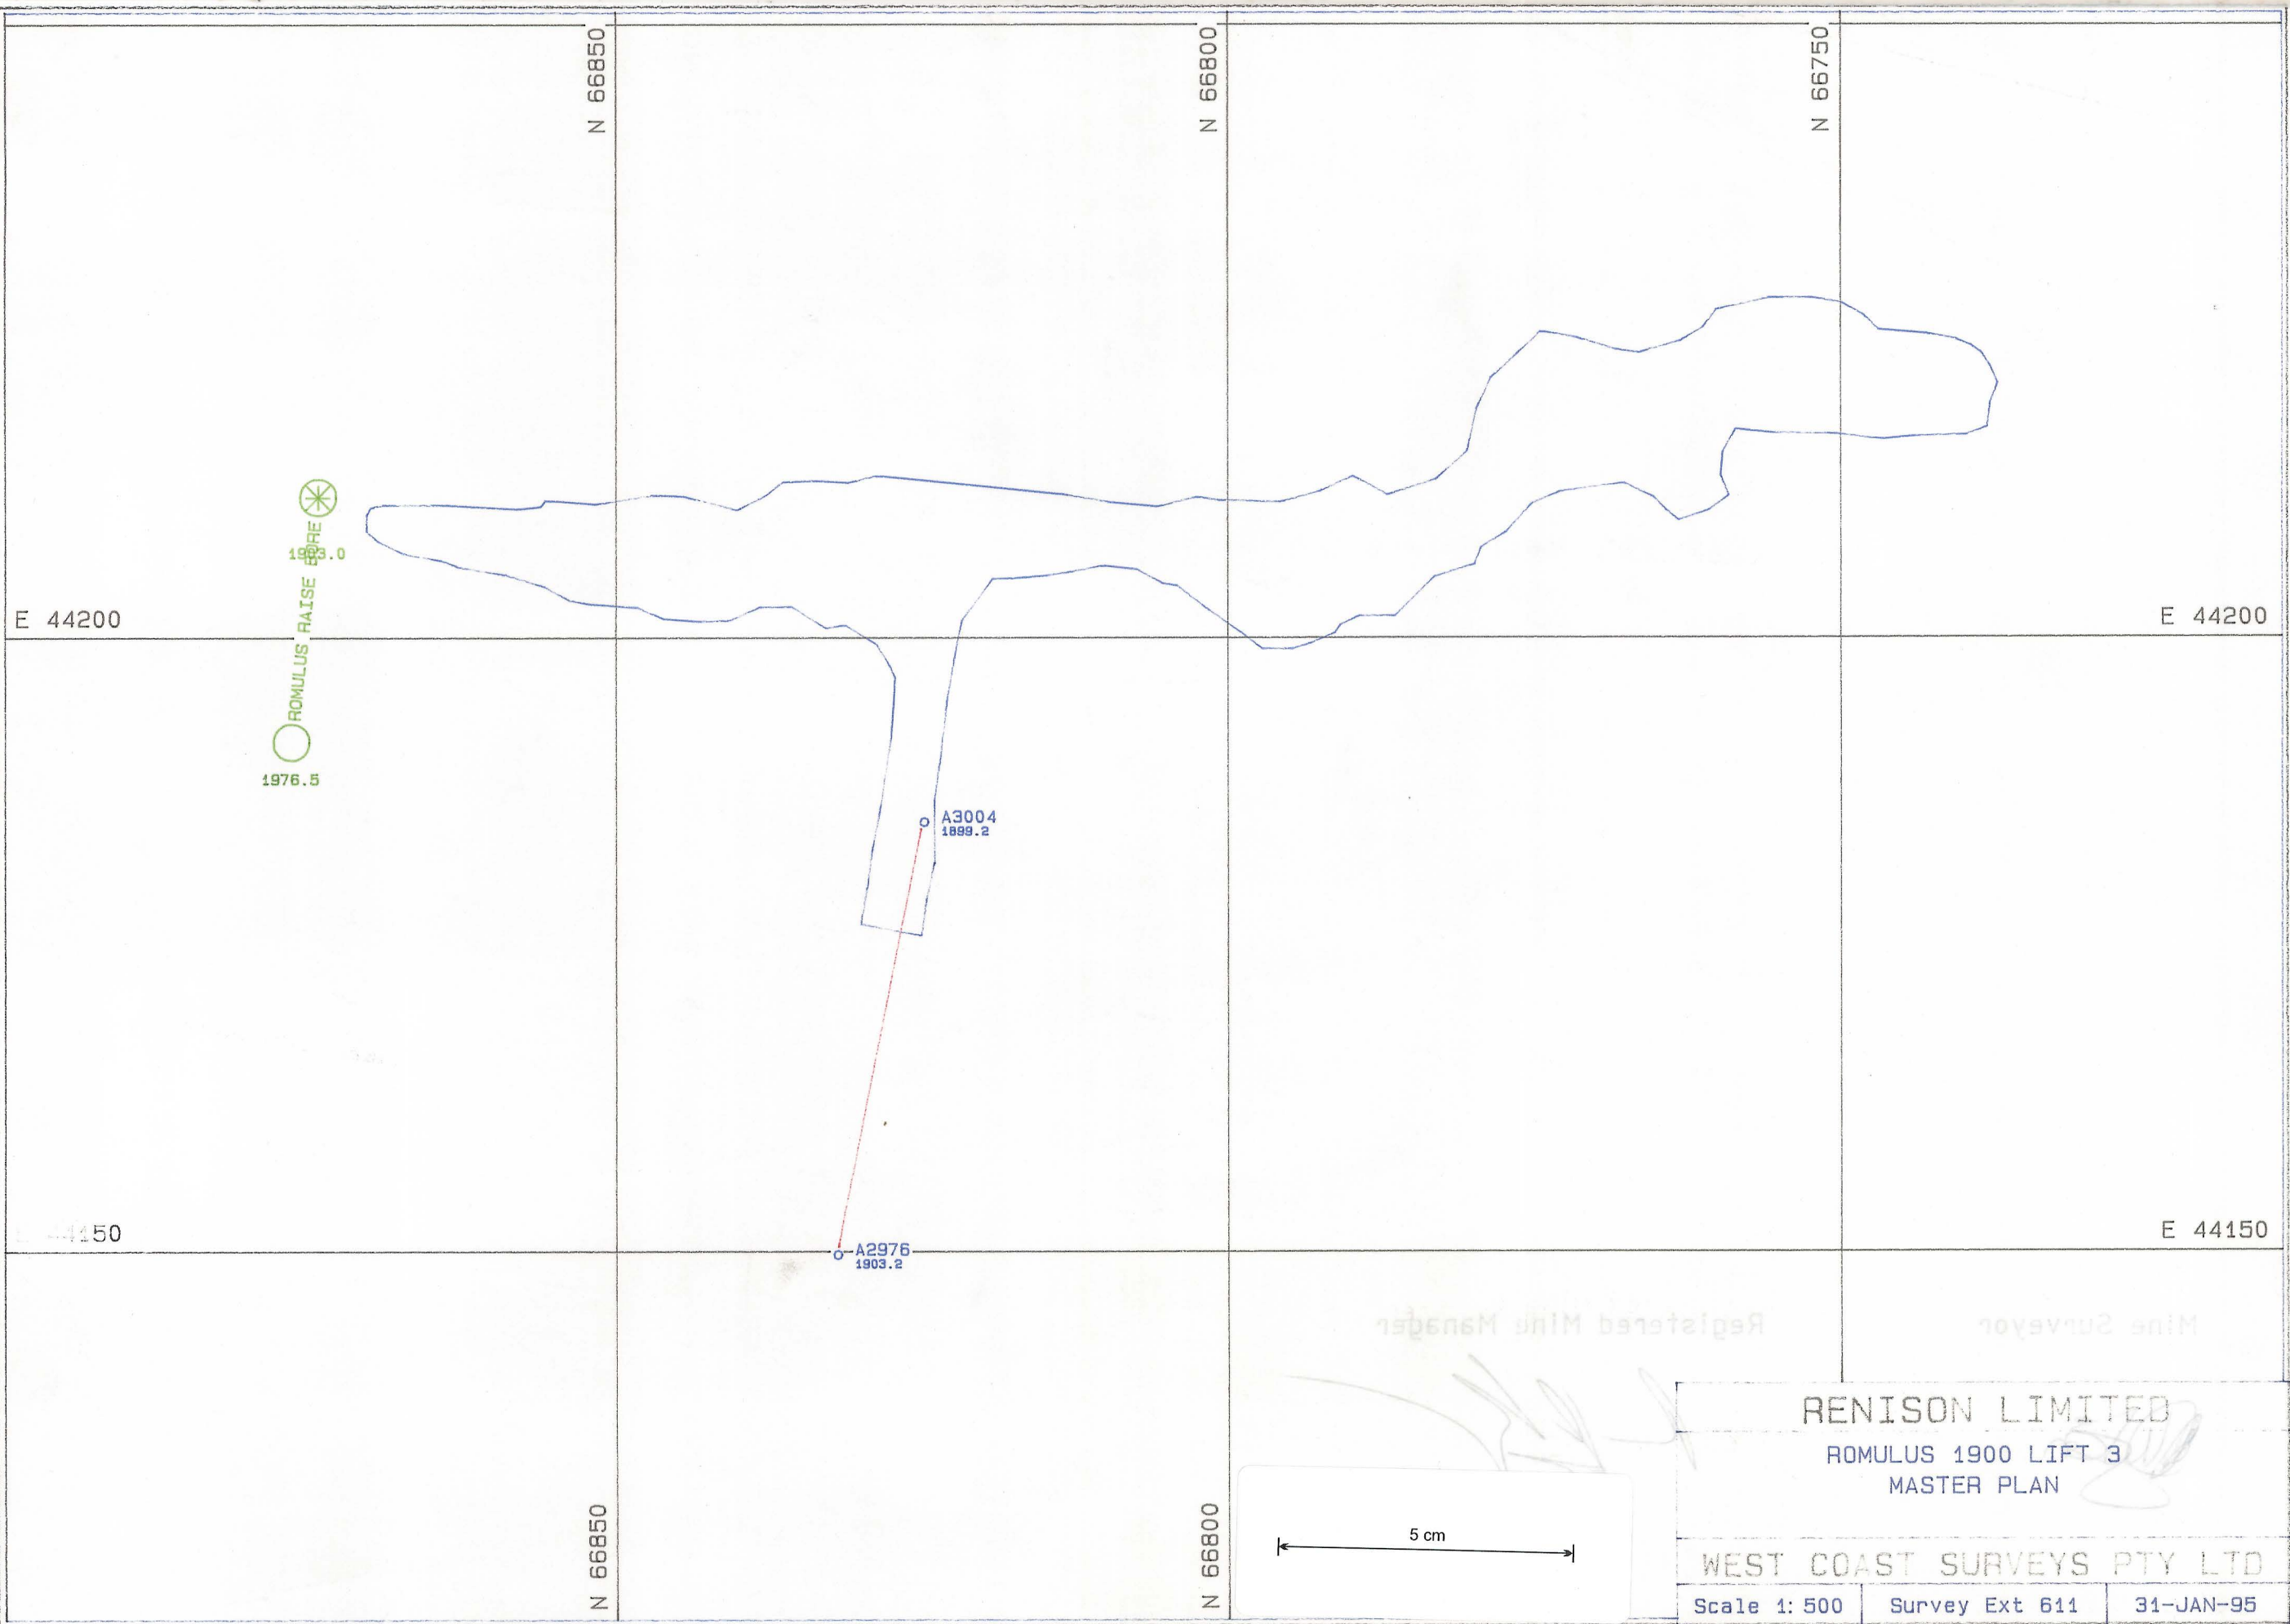

RENISON LIMITED

ROMULUS 1900 LIFT 3
MASTER PLAN

WEST COAST SURVEYS PTY LTD

Scale 1: 500	Survey Ext 611	31-JAN-95
--------------	----------------	-----------