


RENISON LIMITED		
WINDER ACCESS INCLINE PERIOD 3, WEEK 2. @ SEPTEMBER 8, 1994.		
WEST COAST SURVEYS PTY LTD		
Scale 1: 500	Survey Ext 611	7-OCT-94

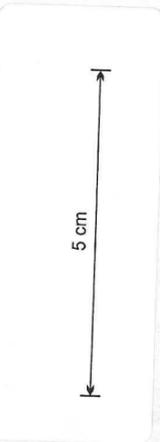

MINDED.PF