


0376 - 157

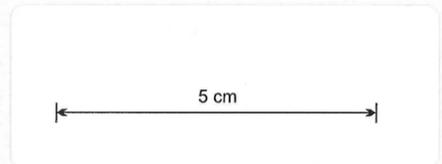

RENISON LIMITED		
TRUCK TIPPLE ACCES PERIOD 6 WEEK 3 @ 16 DECEMBER 1994		
WEST COAST SURVEYS PTY LTD		
Scale 1: 500	Survey Ext 611	16-DEC-94

TRUCKA.PF